

621.20 STEEL BEAM GUARDRAIL, GALVANIZED

STA. 65+37.5 TO 67+75.0, RT 68+0, RT
STA. 66+00.5 TO 68+50.0, LT
50.5

621.50 MANUFACTURED TERMINAL SECTION, FLARED

STA. 65+00.0 TO 65+37.5, RT
STA. 65+63.0 TO 66+00.5, LT
STA. 67+75.0 TO 68+12.5, RT
68+0 TO 68+37.5, RT

621.80 REMOVAL AND DISPOSAL OF GUARDRAIL

STA. 65+06 TO 68+12, RT
STA. 65+67 TO 68+50, LT

646.402 DURABLE 4 INCH WHITE LINE, THERMOPLASTIC

(ALL LINES WILL INCLUDE EDGE LINE BREAKS AND
RADI1 FOR SIDE ROADS)

STA. 62+50 TO 68+50, SOLID LT & RT
STA. 63+91, SOLID LT (I-91 SOUTHBOUND OFF-RAMP)
STA. 63+97, SOLID RT (I-91 SOUTHBOUND ON-RAMP)
STA. 64+00 TO 65+65, SOLID LT (LANE LINE)
STA. 65+65 TO 68+50, DOTTED LT (LANE LINE)
STA. 66+55 TO 68+50, DOTTED RT (LANE LINE)

646.412 DURABLE 4 INCH YELLOW LINE, THERMOPLASTIC

(ALL LINES WILL INCLUDE @ BREAKS FOR SIDE ROADS)
STA. 62+50 TO 63+60, DOUBLE SOLID LT & RT (INCLUDING DIAGONALS)
STA. 64+40 TO 68+50, DOUBLE SOLID RT - LT

646.422 DURABLE 6 INCH WHITE LINE, THERMOPLASTIC

STA. 63+91, SOLID LT (I-91 SOUTHBOUND OFF-RAMP)
STA. 63+97, SOLID RT (I-91 SOUTHBOUND ON-RAMP)

646.432 DURABLE 6 INCH YELLOW LINE, THERMOPLASTIC

STA. 63+91, SOLID LT (I-91 SOUTHBOUND OFF-RAMP)
STA. 63+97, SOLID RT (I-91 SOUTHBOUND ON-RAMP)

646.482 DURABLE 24 INCH STOP BAR, THERMOPLASTIC

STA. 63+91, LT (I-91 SB OFF-RAMP)

646.492 DURABLE LETTER OR SYMBOL, THERMOPLASTIC

STA. 63+91, LT (I-91 SB OFF-RAMP) - "STOP"
STA. 64+44, LT - ARROW
STA. 65+03, LT - "ONLY"
STA. 65+61, LT - ARROW

646.602 TEMPORARY 4 INCH WHITE LINE, PAINT

(ALL LINES WILL INCLUDE @ BREAKS FOR SIDE ROADS AND
RADI1 FOR SIDE ROADS)

STA. 62+50 TO 68+50, SOLID LT & RT
STA. 63+91, SOLID LT (I-91 SOUTHBOUND OFF-RAMP)
STA. 63+97, SOLID RT (I-91 SOUTHBOUND ON-RAMP)
STA. 64+00 TO 65+65, SOLID LT (LANE LINE)
STA. 65+65 TO 68+50, DOTTED LT (LANE LINE)
STA. 66+55 TO 68+50, DOTTED RT (LANE LINE)

646.612 TEMPORARY 4 INCH YELLOW LINE, PAINT

(ALL LINES WILL INCLUDE @ BREAKS FOR SIDE ROADS)
STA. 62+50 TO 63+60, DOUBLE SOLID LT & RT (INCLUDING DIAGONALS)
STA. 64+40 TO 68+50, DOUBLE SOLID RT - LT

646.622 TEMPORARY 6 INCH WHITE LINE, PAINT

STA. 63+91, SOLID LT (I-91 SOUTHBOUND OFF-RAMP)
STA. 63+97, SOLID RT (I-91 SOUTHBOUND ON-RAMP)

646.632 TEMPORARY 6 INCH YELLOW LINE, PAINT


STA. 63+91, SOLID LT (I-91 SOUTHBOUND OFF-RAMP)
STA. 63+97, SOLID RT (I-91 SOUTHBOUND ON-RAMP)

646.682 TEMPORARY 24 INCH STOP BAR, PAINT

STA. 63+91, LT (I-91 SB OFF-RAMP)

646.692 TEMPORARY LETTER OR SYMBOL, PAINT

STA. 63+91, LT (I-91 SB OFF-RAMP) - "STOP"
STA. 64+44, LT - ARROW
STA. 65+03, LT - "ONLY"
STA. 65+61, LT - ARROW

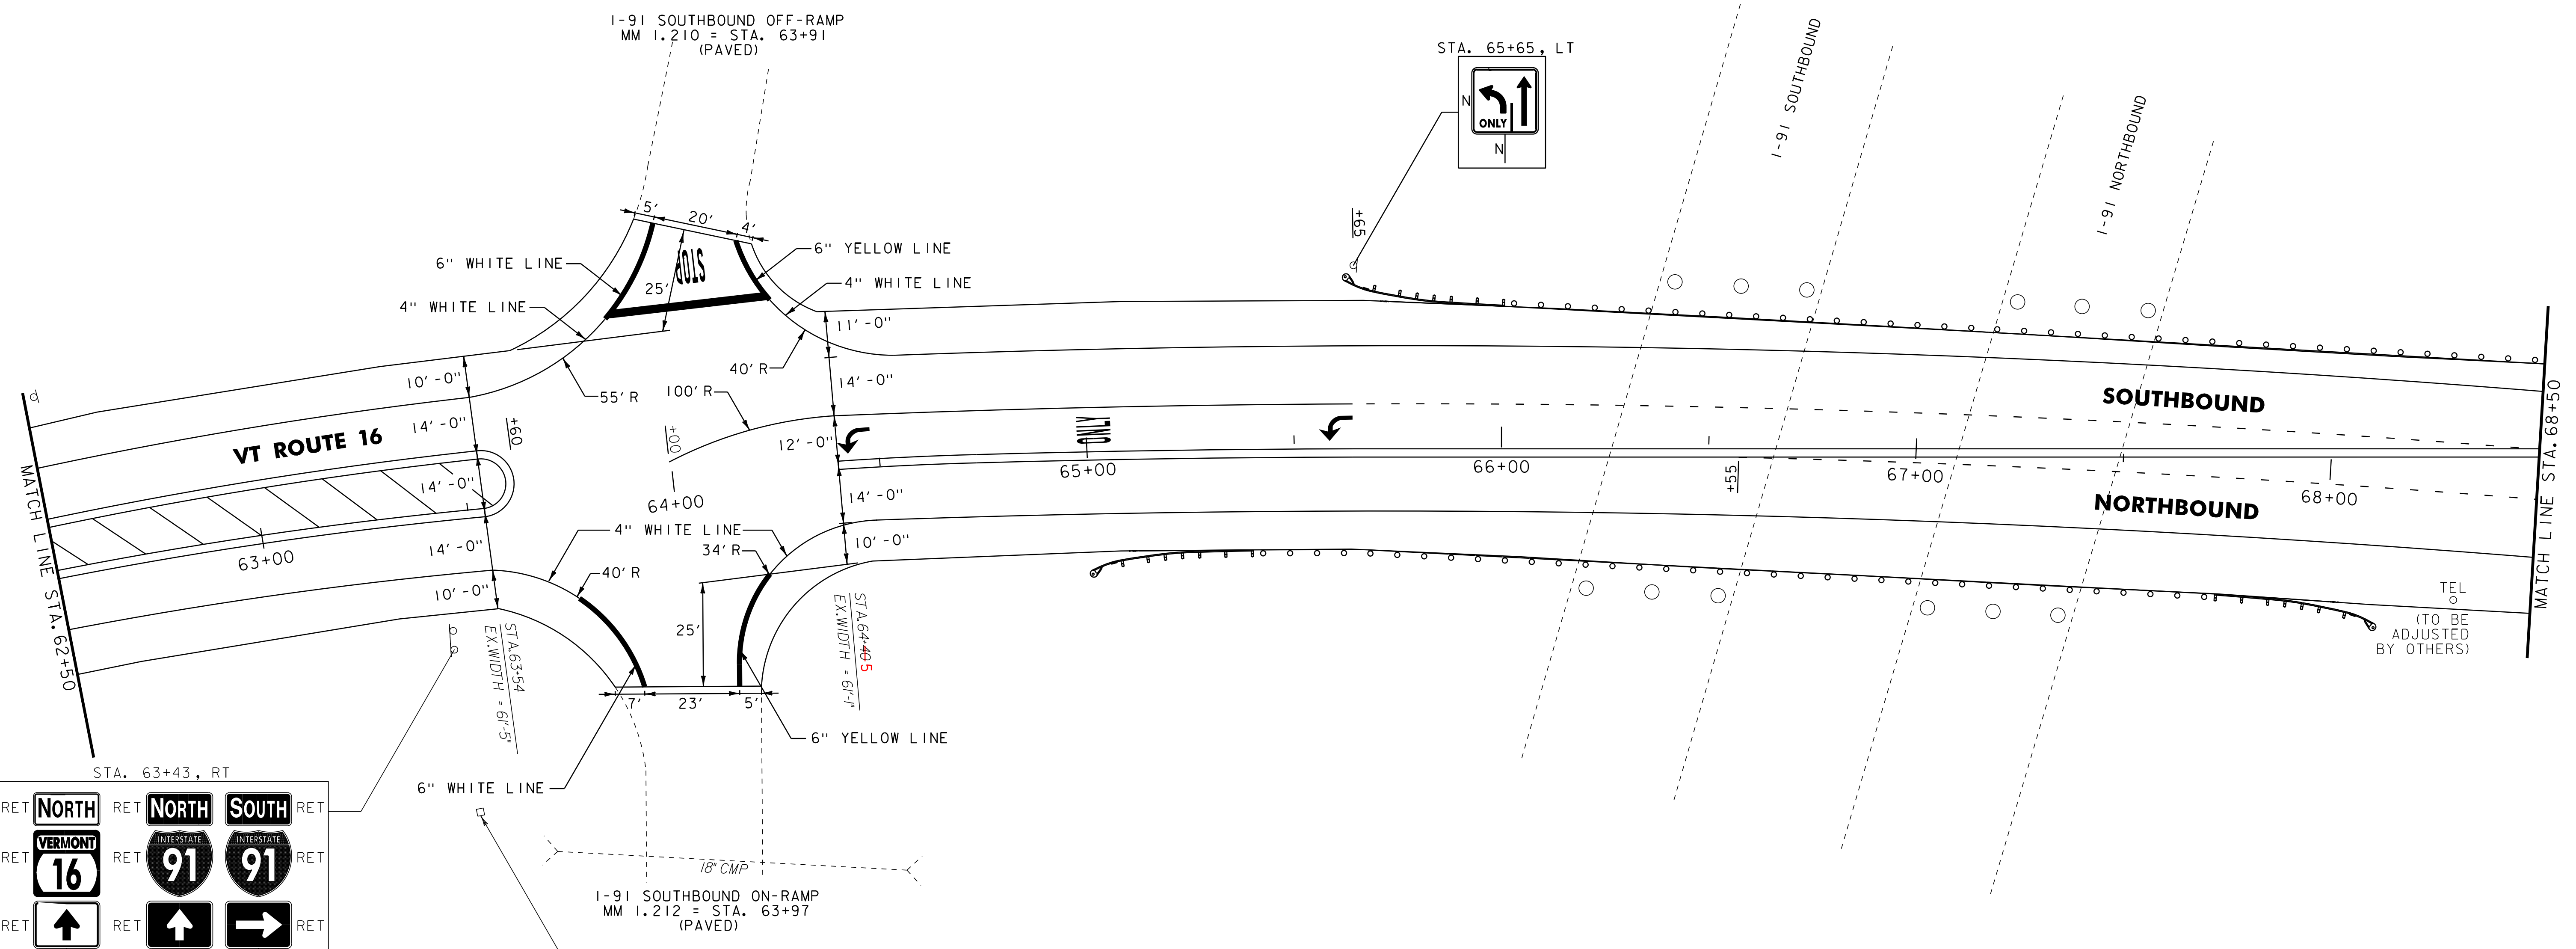

| | | | | | |
|-----|----------------|-----|--------------|--------------|-----|
| RET | NORTH | RET | NORTH | SOUTH | RET |
| RET | VERMONT | RET | 91 | 91 | RET |
| RET | 16 | RET | ↑ | → | RET |
| RET | 0160 | RET | 1002 | 0120 | RET |

NOTES:
 1. FOR LEGENDS, SEE LAYOUT SHEET #1.
 2. ALL EXISTING SIGNS NOT SHOWN SHALL BE RETAINED.

| | | | |
|---------------------------------|-------------------------------|--------------------------|------------------------------|
| PROJECT LAYOUT SHEET #28 | PROJECT NAME: GLOVER - BARTON | FILE NAME: p01b034.dgn | PLOT DATE: 28-NOV-2012 15:00 |
| | PROJECT NUMBER: STP 2318(I) | DESIGNED BY: STANTEC | DRAWN BY: STANTEC |
| | | IPARM FILE: p01b034I28.i | CHECKED BY: STANTEC |
| | | | SHEET 40 OF 60 |

