

**STEEL BEAM GUARDRAIL, GALVANIZED**

STA. 68+50.0 TO 68+50.5, LT

**621.50 MANUFACTURED TERMINAL SECTION, FLARED**

STA. 68+50.5 TO 68+88.0, LT

**621.80 REMOVAL AND DISPOSAL OF GUARDRAIL**

STA. 68+50 TO 68+83, LT

**646.402 DURABLE 4 INCH WHITE LINE, THERMOPLASTIC**

(ALL LINES WILL INCLUDE EDGE LINE BREAKS AND RADIUS FOR SIDE ROADS)

STA. 68+50 TO 68+60, DOTTED RT (LANE LINE)

STA. 68+50 TO 74+50, SOLID LT & RT

STA. 68+60 TO 69+75, SOLID RT (LANE LINE)

STA. 69+74, SOLID LT (I-91 NORTHBOUND ON-RAMP)

STA. 69+88, SOLID RT (I-91 NORTHBOUND OFF-RAMP)

**646.412 DURABLE 4 INCH YELLOW LINE, THERMOPLASTIC**

(ALL LINES WILL INCLUDE C BREAKS FOR SIDE ROADS)

STA. 68+50 TO 69+35, DOUBLE SOLID LT

STA. 70+34 TO 74+50, DOUBLE SOLID LT & RT (INCLUDING DIAGONALS)

**646.422 DURABLE 6 INCH WHITE LINE, THERMOPLASTIC**

STA. 69+74, SOLID LT (I-91 NORTHBOUND ON-RAMP)

STA. 69+88, SOLID RT (I-91 NORTHBOUND OFF-RAMP)

**646.432 DURABLE 6 INCH YELLOW LINE, THERMOPLASTIC**

STA. 69+74, SOLID LT (I-91 NORTHBOUND ON-RAMP)

STA. 69+88, SOLID RT (I-91 NORTHBOUND OFF-RAMP)

**646.482 DURABLE 24 INCH STOP BAR, THERMOPLASTIC**

STA. 69+88, RT (I-91 NB OFF-RAMP)

**646.492 DURABLE LETTER OR SYMBOL, THERMOPLASTIC**

STA. 68+64, RT - ARROW

STA. 68+98, RT - "ONLY"

STA. 69+31, RT - ARROW

STA. 69+88, RT (I-91 NB OFF-RAMP) - "STOP"

**646.602 TEMPORARY 4 INCH WHITE LINE, PAINT**

(ALL LINES WILL INCLUDE EDGE LINE BREAKS AND RADIUS FOR SIDE ROADS)

STA. 68+50 TO 68+60, DOTTED RT (LANE LINE)

STA. 68+50 TO 74+50, SOLID LT & RT

STA. 68+60 TO 69+75, SOLID RT (LANE LINE)

STA. 69+74, SOLID LT (I-91 NORTHBOUND ON-RAMP)

STA. 69+88, SOLID RT (I-91 NORTHBOUND OFF-RAMP)

**646.612 TEMPORARY 4 INCH YELLOW LINE, PAINT**

(ALL LINES WILL INCLUDE C BREAKS FOR SIDE ROADS)

STA. 68+50 TO 69+35, DOUBLE SOLID LT

STA. 70+34 TO 74+50, DOUBLE SOLID LT & RT (INCLUDING DIAGONALS)

**646.622 TEMPORARY 6 INCH WHITE LINE, PAINT**

STA. 69+74, SOLID LT (I-91 NORTHBOUND ON-RAMP)

STA. 69+88, SOLID RT (I-91 NORTHBOUND OFF-RAMP)

**646.632 TEMPORARY 6 INCH YELLOW LINE, PAINT**

STA. 69+74, SOLID LT (I-91 NORTHBOUND ON-RAMP)

STA. 69+88, SOLID RT (I-91 NORTHBOUND OFF-RAMP)

**646.682 TEMPORARY 24 INCH STOP BAR, PAINT**

STA. 69+88, RT (I-91 NB OFF-RAMP)




**646.692 TEMPORARY LETTER OR SYMBOL, PAINT**

STA. 68+64, RT - ARROW

STA. 68+98, RT - "ONLY"

STA. 69+31, RT - ARROW

STA. 69+88, RT (I-91 NB OFF-RAMP) - "STOP"

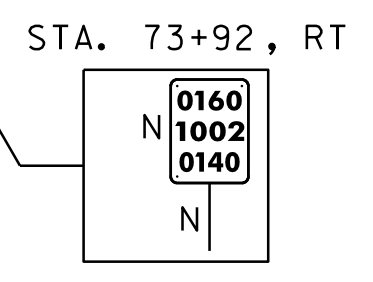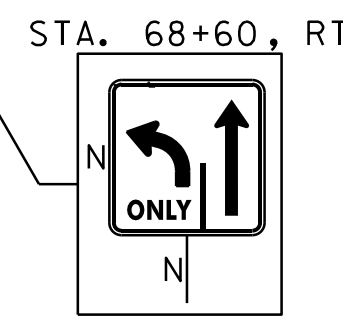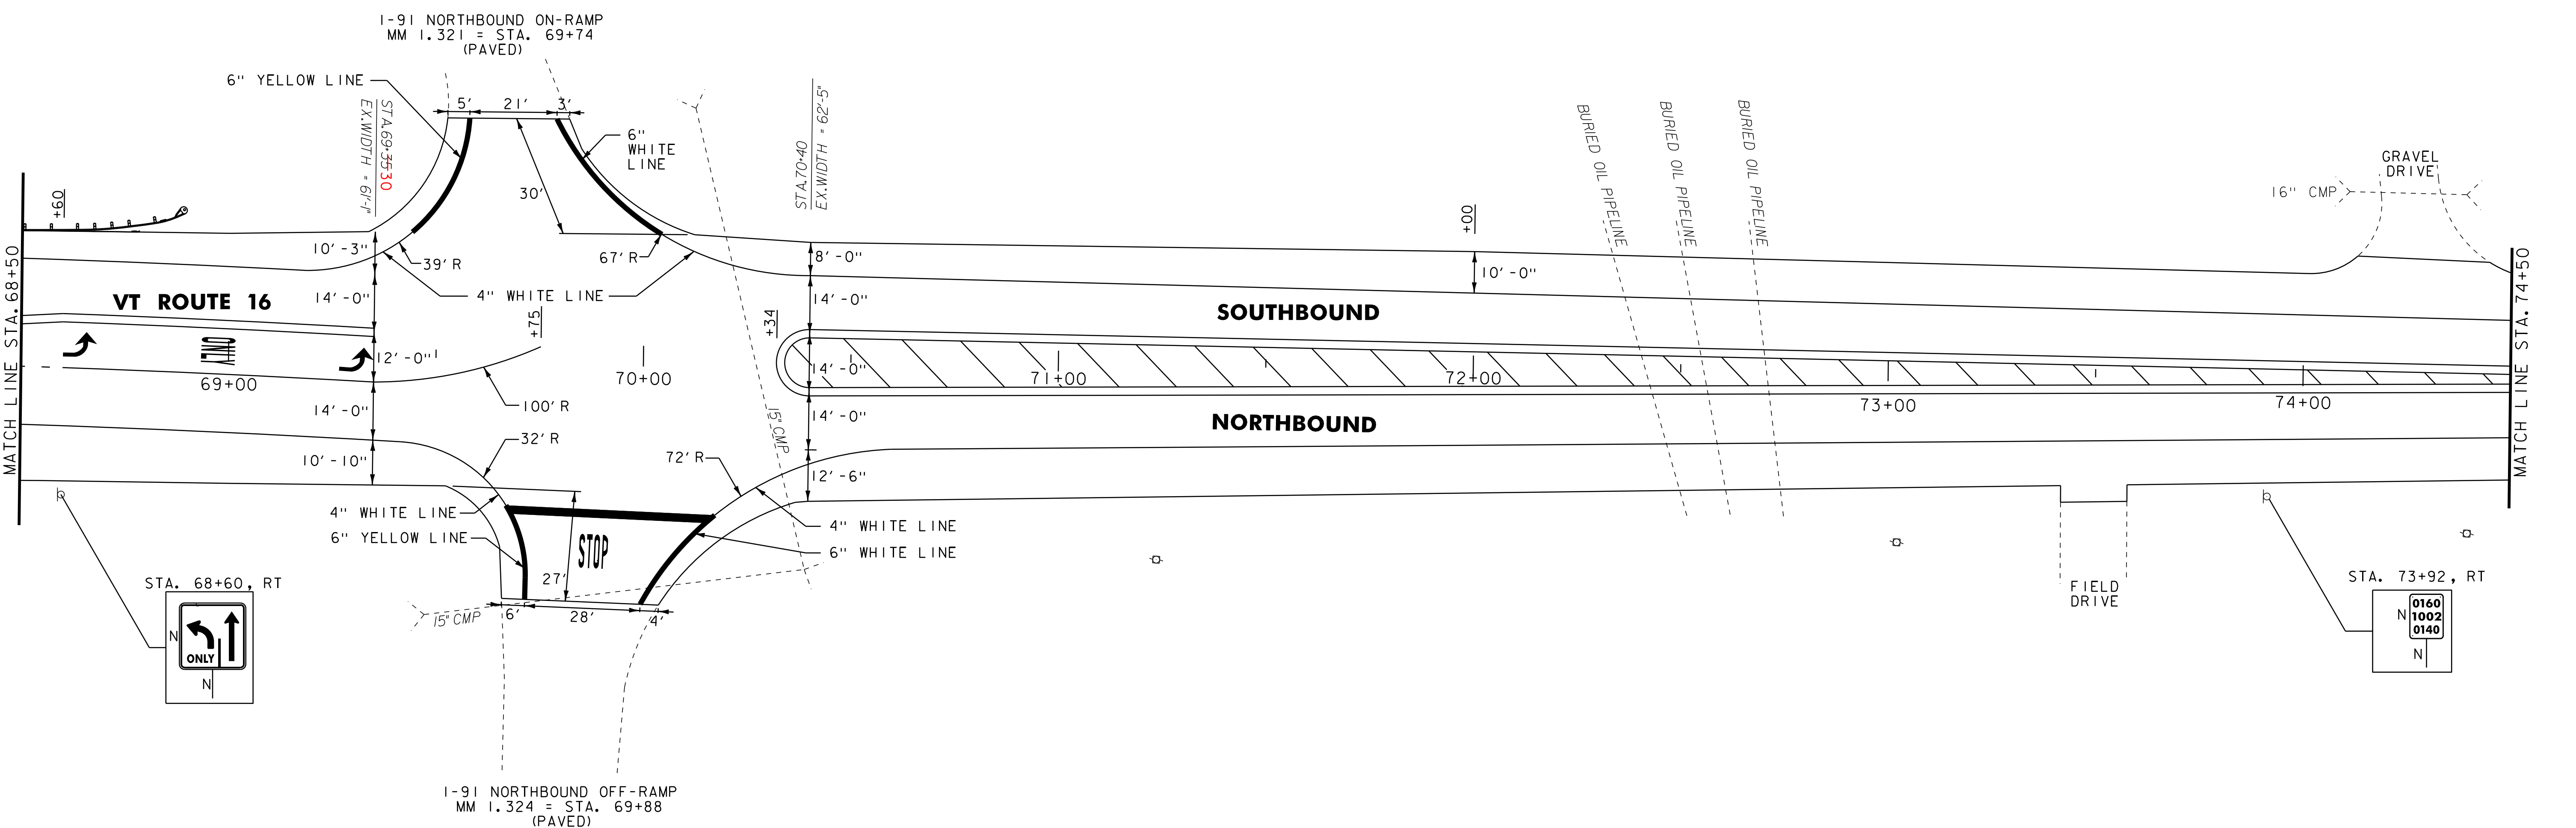

- NOTES:
- FOR LEGENDS, SEE LAYOUT SHEET #1.
  - ALL EXISTING SIGNS NOT SHOWN SHALL BE RETAINED.

NOT TO SCALE

<b>PROJECT LAYOUT SHEET #29</b>	PROJECT NAME: GLOVER - BARTON	FILE NAME: p01b034.dgn	PLOT DATE: 28-NOV-2012 15:00
	PROJECT NUMBER: STP 2318(I)	PROJECT LEADER: JLL	DRAWN BY: STANTEC
		DESIGNED BY: STANTEC	CHECKED BY: STANTEC

**IPARM FILE: p01b034I29.i**

