

616.47 BITUMINOUS CONCRETE GUTTERS AND TRAFFIC ISLANDS
 STA. 78+58 TO 80+50, RT
 (SEE DETAIL ON MISCELLANEOUS DETAIL SHEET #2)

621.20 STEEL BEAM GUARDRAIL, GALVANIZED
 STA. 76+99.5 TO 80+50.0, LT

621.50 MANUFACTURED TERMINAL SECTION, FLARED
 STA. 76+62.0 TO 76+99.5, LT

621.80 REMOVAL AND DISPOSAL OF GUARDRAIL
 STA. 76+62 TO 80+50, LT


646.402 DURABLE 4 INCH WHITE LINE, THERMOPLASTIC
 (ALL LINES WILL INCLUDE EDGE LINE BREAKS AND
 RADII FOR SIDE ROADS)
 STA. 74+50 TO 80+50, SOLID LT & RT

646.412 DURABLE 4 INCH YELLOW LINE, THERMOPLASTIC
 (ALL LINES WILL INCLUDE C BREAKS FOR SIDE ROADS)
 STA. 74+50 TO 75+44, DOUBLE SOLID LT & RT (INCLUDES DIAGONALS)
 STA. 75+44 TO 80+50, SOLID LT & RT

646.602 TEMPORARY 4 INCH WHITE LINE, PAINT
 (ALL LINES WILL INCLUDE EDGE LINE BREAKS AND
 RADII FOR SIDE ROADS)
 STA. 74+50 TO 80+50, SOLID LT & RT

646.612 TEMPORARY 4 INCH YELLOW LINE, PAINT
 (ALL LINES WILL INCLUDE C BREAKS FOR SIDE ROADS)
 STA. 74+50 TO 75+44, DOUBLE SOLID LT & RT (INCLUDES DIAGONALS)
 STA. 75+44 TO 80+50, SOLID LT & RT

619.17 YIELDING MARKER POSTS
 STA. 74+65, RT
 STA. 81+40, LT & RT
 STA. 83+80, LT & RT
 STA. 85+80, LT & RT

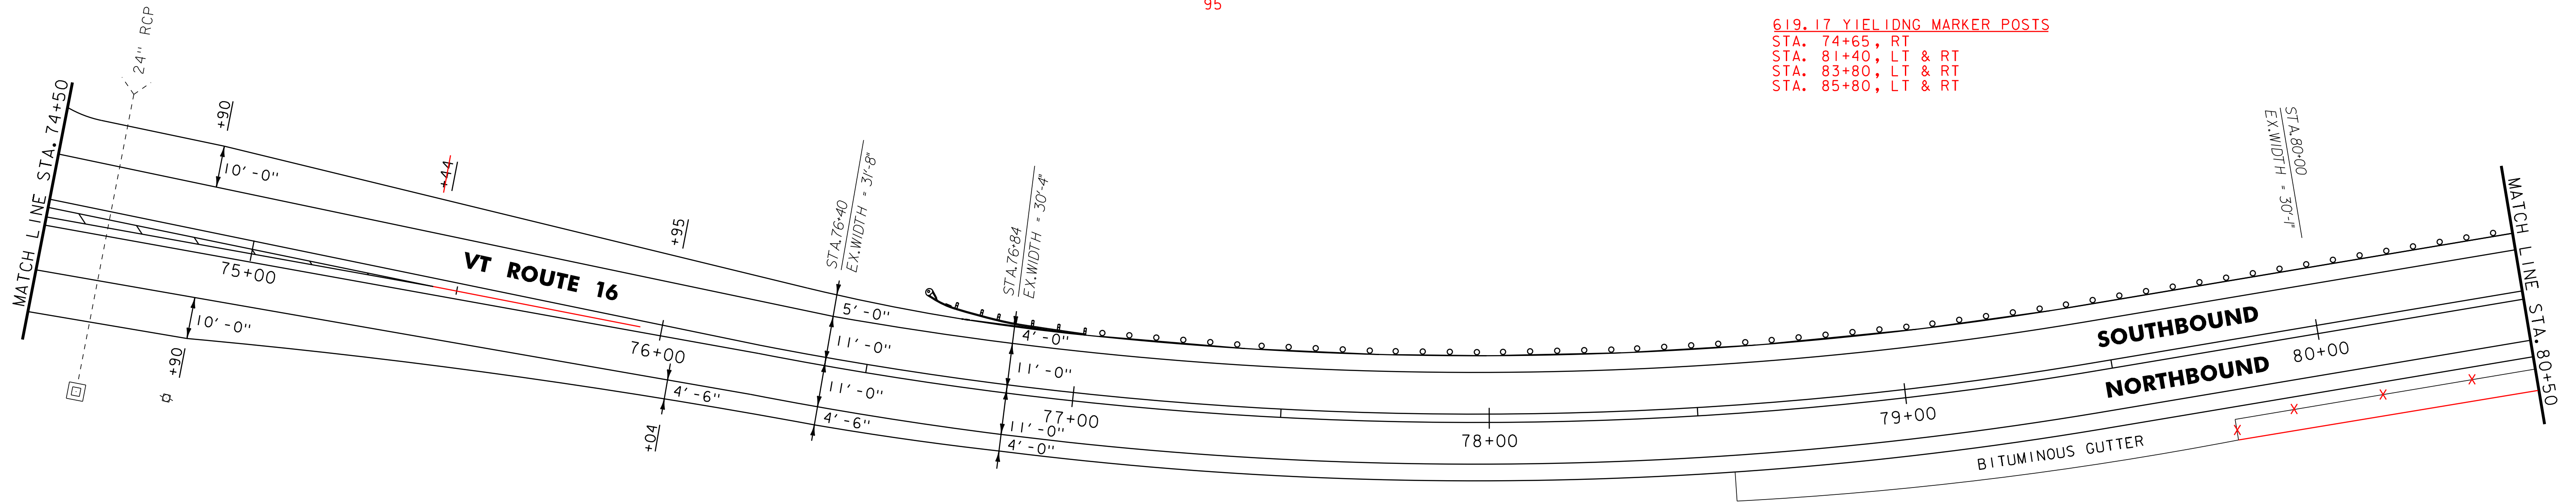

604.412 OR 604.415 REHAB.
 DIS, CBS OR MHS, CLASS I OR II
 STA. 81+40, RT
 STA. 83+86, RT
 STA. 85+90, RT
 STA. 86+27, RT

621.20 STEEL BEAM GUARDRAIL, GALVANIZED
 STA. 80+50.0 TO 85+74.5, LT

621.50 MANUFACTURED TERMINAL SECTION, FLARED
 STA. 85+74.5 TO 86+12.0, LT

621.80 REMOVAL AND DISPOSAL OF GUARDRAIL
 STA. 80+50 TO 86+12, LT


646.402 DURABLE 4 INCH WHITE LINE, THERMOPLASTIC
 (ALL LINES WILL INCLUDE EDGE LINE BREAKS AND
 RADII FOR SIDE ROADS)
 STA. 80+50 TO 86+50, SOLID LT & RT

646.412 DURABLE 4 INCH YELLOW LINE, THERMOPLASTIC
 (ALL LINES WILL INCLUDE C BREAKS FOR SIDE ROADS)
 STA. 80+50 TO 86+50, SOLID LT & RT

646.602 TEMPORARY 4 INCH WHITE LINE, PAINT
 (ALL LINES WILL INCLUDE EDGE LINE BREAKS AND
 RADII FOR SIDE ROADS)
 STA. 80+50 TO 86+50, SOLID LT & RT

646.612 TEMPORARY 4 INCH YELLOW LINE, PAINT
 (ALL LINES WILL INCLUDE C BREAKS FOR SIDE ROADS)
 STA. 80+50 TO 86+50, SOLID LT & RT

616.47 BITUMINOUS CONCRETE GUTTERS AND TRAFFIC ISLANDS
 STA. 80+50 TO 81+37, RT
 STA. ~~81+97~~ TO 85+94, RT 81+37
 STA. 86+25 TO 86+50, RT
 (SEE DETAIL ON MISCELLANEOUS DETAIL SHEET #2)

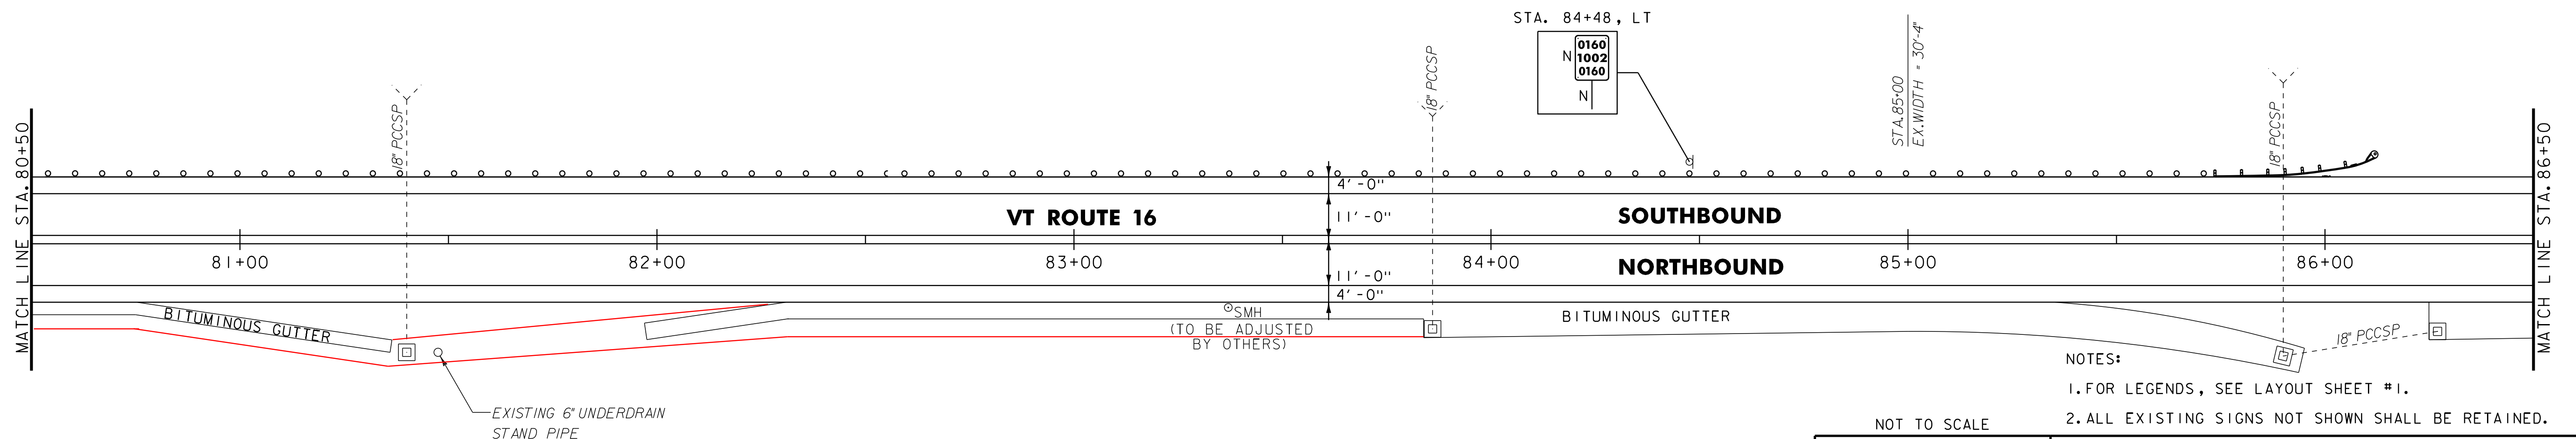

- NOTES:
- FOR LEGENDS, SEE LAYOUT SHEET #1.
 - ALL EXISTING SIGNS NOT SHOWN SHALL BE RETAINED.

NOT TO SCALE

PROJECT LAYOUT SHEET #30

PROJECT NAME: GLOVER - BARTON
 PROJECT NUMBER: STP 2318(I)

FILE NAME: p01b034.dgn
 PROJECT LEADER: JLL
 DESIGNED BY: STANTEC
 IPARM FILE: p01b034i30.i

PLOT DATE: 28-NOV-2012 15:00
 DRAWN BY: STANTEC
 CHECKED BY: STANTEC
 SHEET 42 OF 60

