

TEMPORARY 4" WHITE LINE, PAINT  
 DURABLE 4" WHITE LINE, THERMOPLASTIC  
 STA 225+45 TO 233+00 SOLID LT  
 STA 225+45 TO 233+00 SOLID RT


TEMPORARY 4" YELLOW LINE, PAINT  
 DURABLE 4" YELLOW LINE, THERMOPLASTIC  
 STA 225+45 TO 233+00 SOLID LT & RT

REMOVING SIGNS  
 AS SHOWN - 5

ERECTING SALVAGED SIGNS  
 (NO FED. PART.)  
 AS SHOWN (TIS) - 3

**VT ROUTE 103**  
**STA 225+45.00**  
**(MM 4.270)**  
**BEGIN PROJECT**  
**NH 2326(1)S**

BEGIN COLD PLANE 5"  
 BEGIN RECLAIM 8"  
 BEGIN 2 LIFTS 1 1/4" TYPE III S  
 BEGIN 2 1/2" TYPE II S

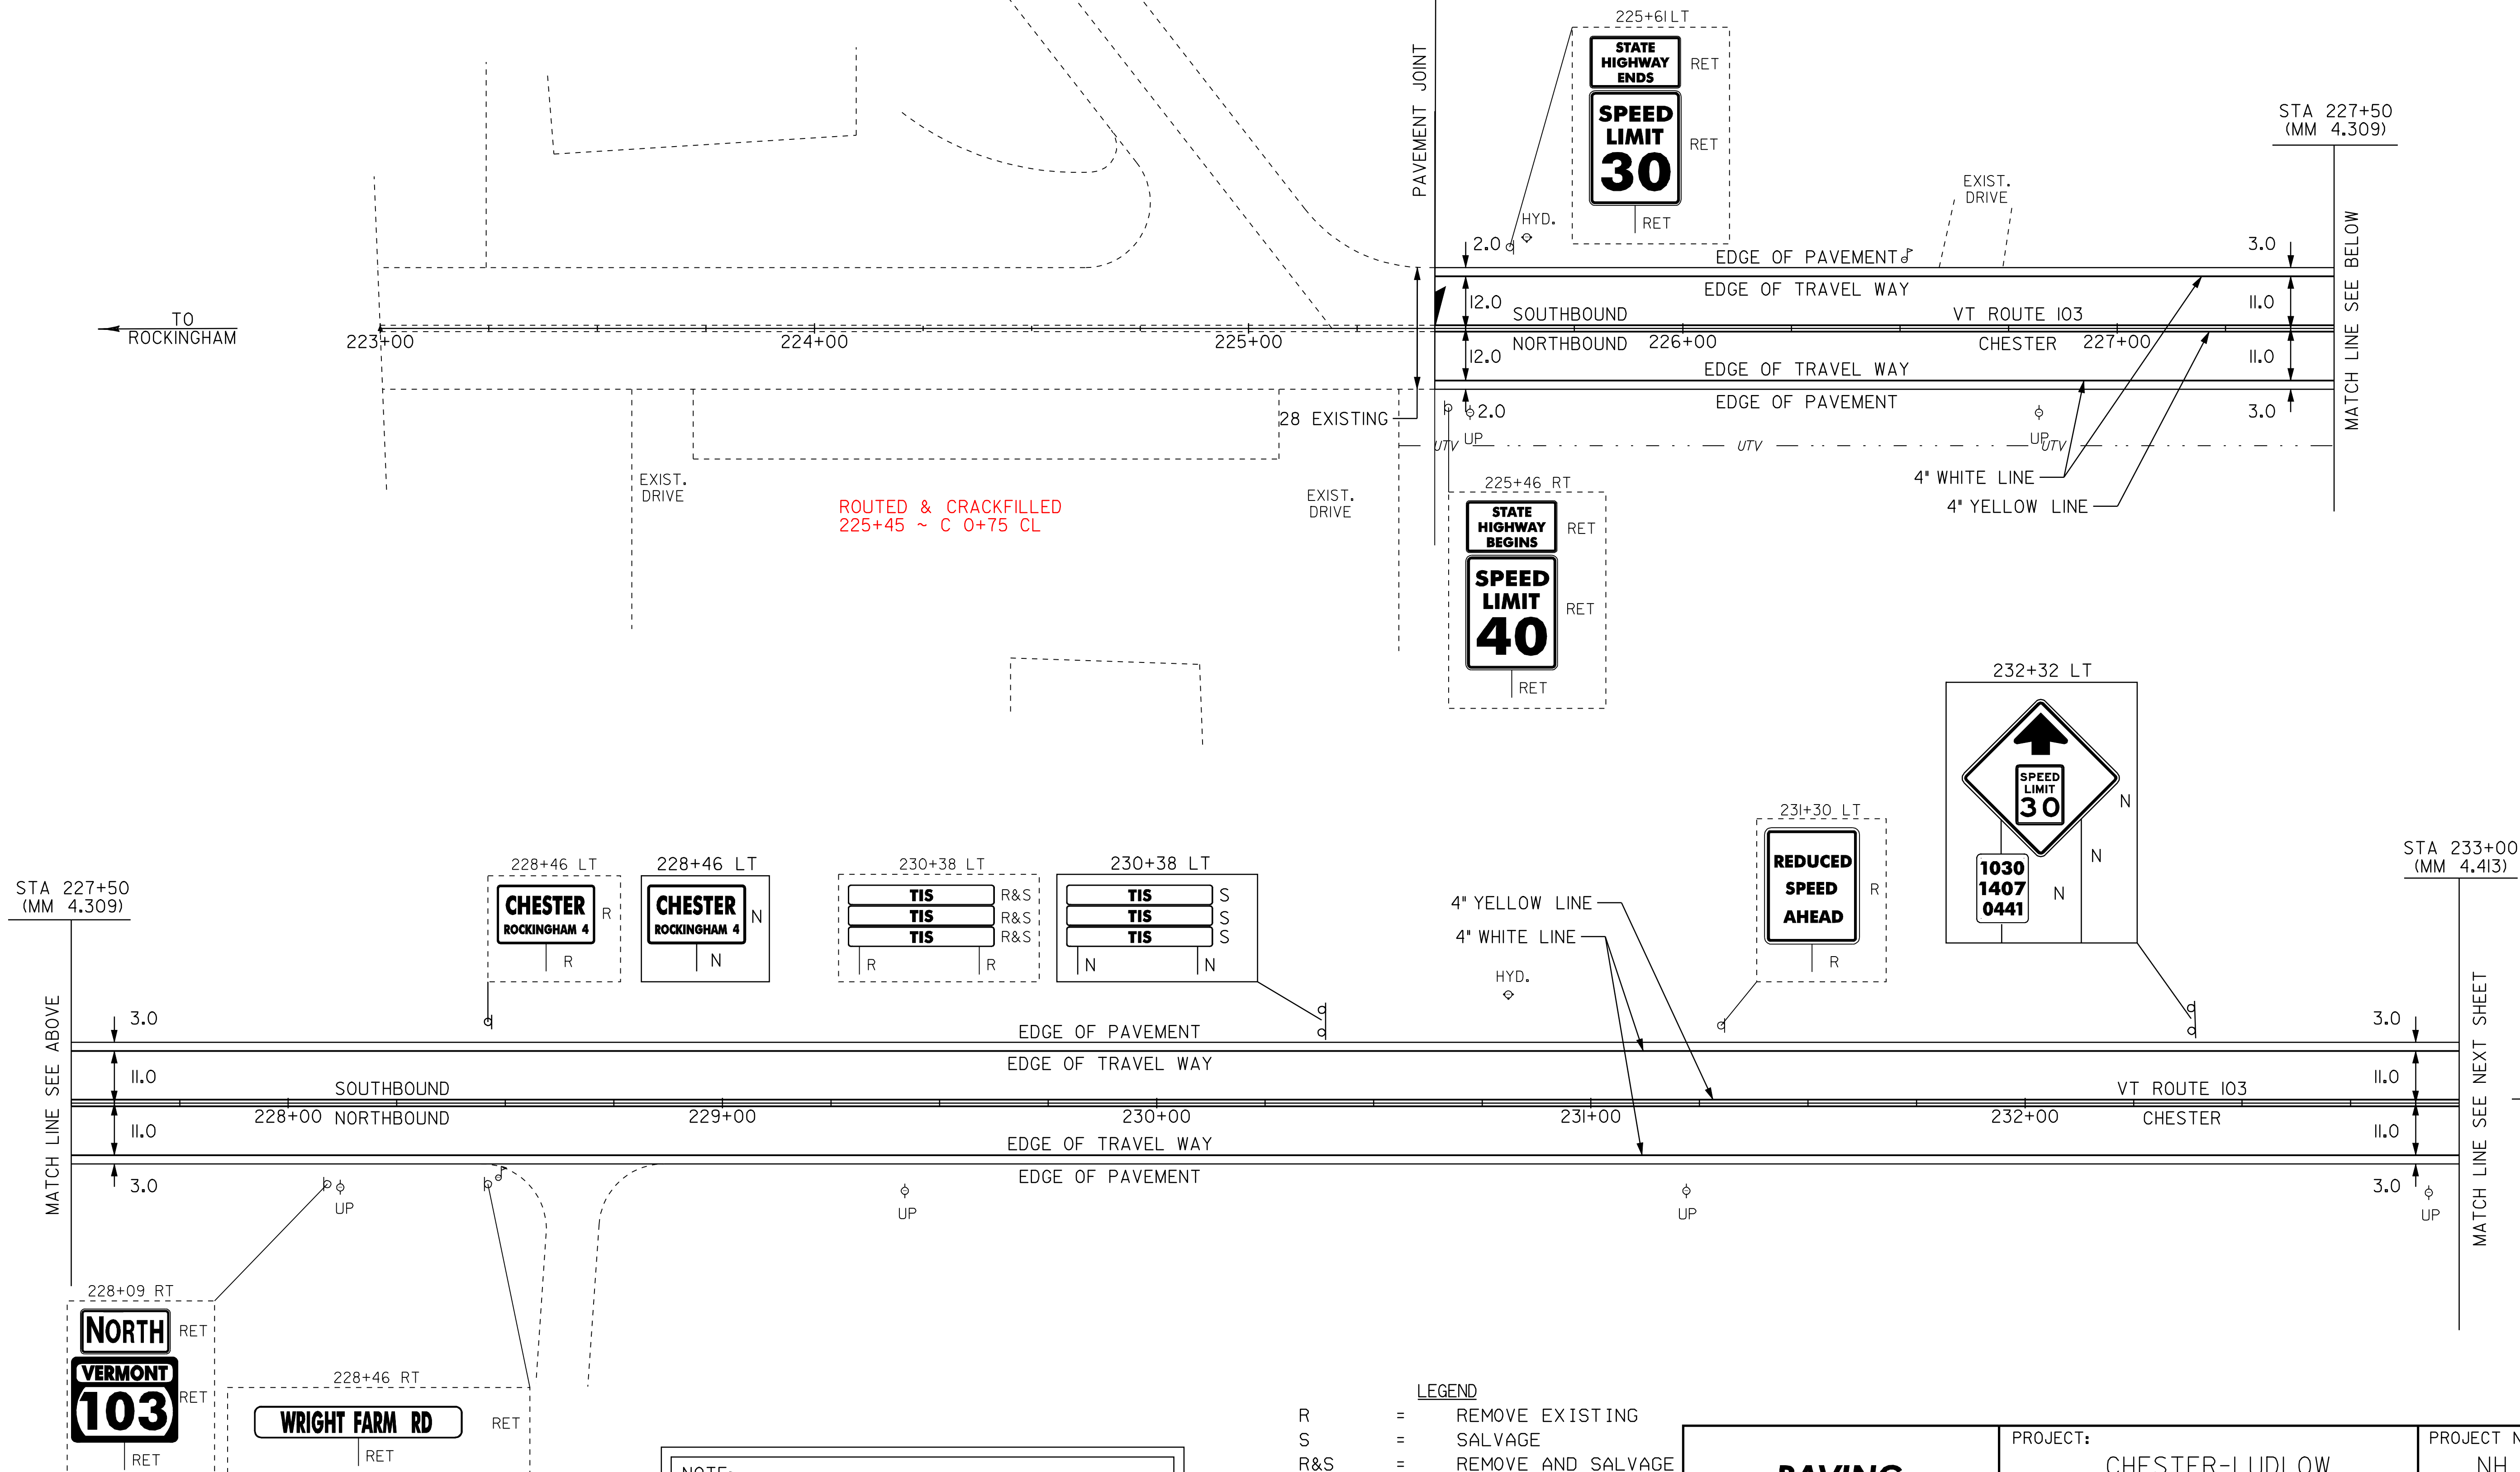

NOTE:  
 TOWN OF CHESTER WATER MAIN EXTENDS  
 FROM STA. 225+42 TO APPROX. STA. 237+00.  
 EXACT LOCATION TO BE DETERMINED IN THE FIELD.

- LEGEND**
- R = REMOVE EXISTING
  - S = SALVAGE
  - R&S = REMOVE AND SALVAGE
  - N = NEW
  - RET = RETAIN
  - B-B = BACK TO BACK
  - = NEW RAIL
  - - - = EXISTING RAIL

**PAVING PROJECT LAYOUT #1**

PROJECT:	PROJECT NO.:
_CHESTER-LUDLOW	_NH_2326(1)S_
DESIGN FILE NAME: \pave\01b038\pb038.dgn	PLOT DATE: 16-OCT-2009 16:
IPARM FILE NAME: pb0381a01.i	SURVEY DATE: 01/05
SURVEYED BY: CLD_ENGINEERS, INC	DRAWN BY: MRS
SQUAD LEADER: CRB	SHEET: 15 OF 110
_CLD_04-0396	