


TEMPORARY 4" WHITE LINE, PAINT  
 DURABLE 4" WHITE LINE, THERMOPLASTIC  
 STA 343+00 TO 354+00 SOLID LT  
 STA 343+00 TO 354+00 SOLID RT

TEMPORARY 4" YELLOW LINE, PAINT  
 DURABLE 4" YELLOW LINE, THERMOPLASTIC  
 STA 343+00 TO 354+00 SOLID LT & RT

STEEL BEAM GUARDRAIL, GALVANIZED  
 STA 343+00 TO 350+64 LT  
 STA 351+33 TO 354+00 LT  
 88  
 MANUFACTURED TERMINAL SECTION, FLARED  
 STA 350+64 LT  
 351+88 LT  
 REMOVAL AND DISPOSAL OF GUARDRAIL  
 STA 343+28 TO 351+08 LT

REMOVING SIGNS  
 AS SHOWN - 2

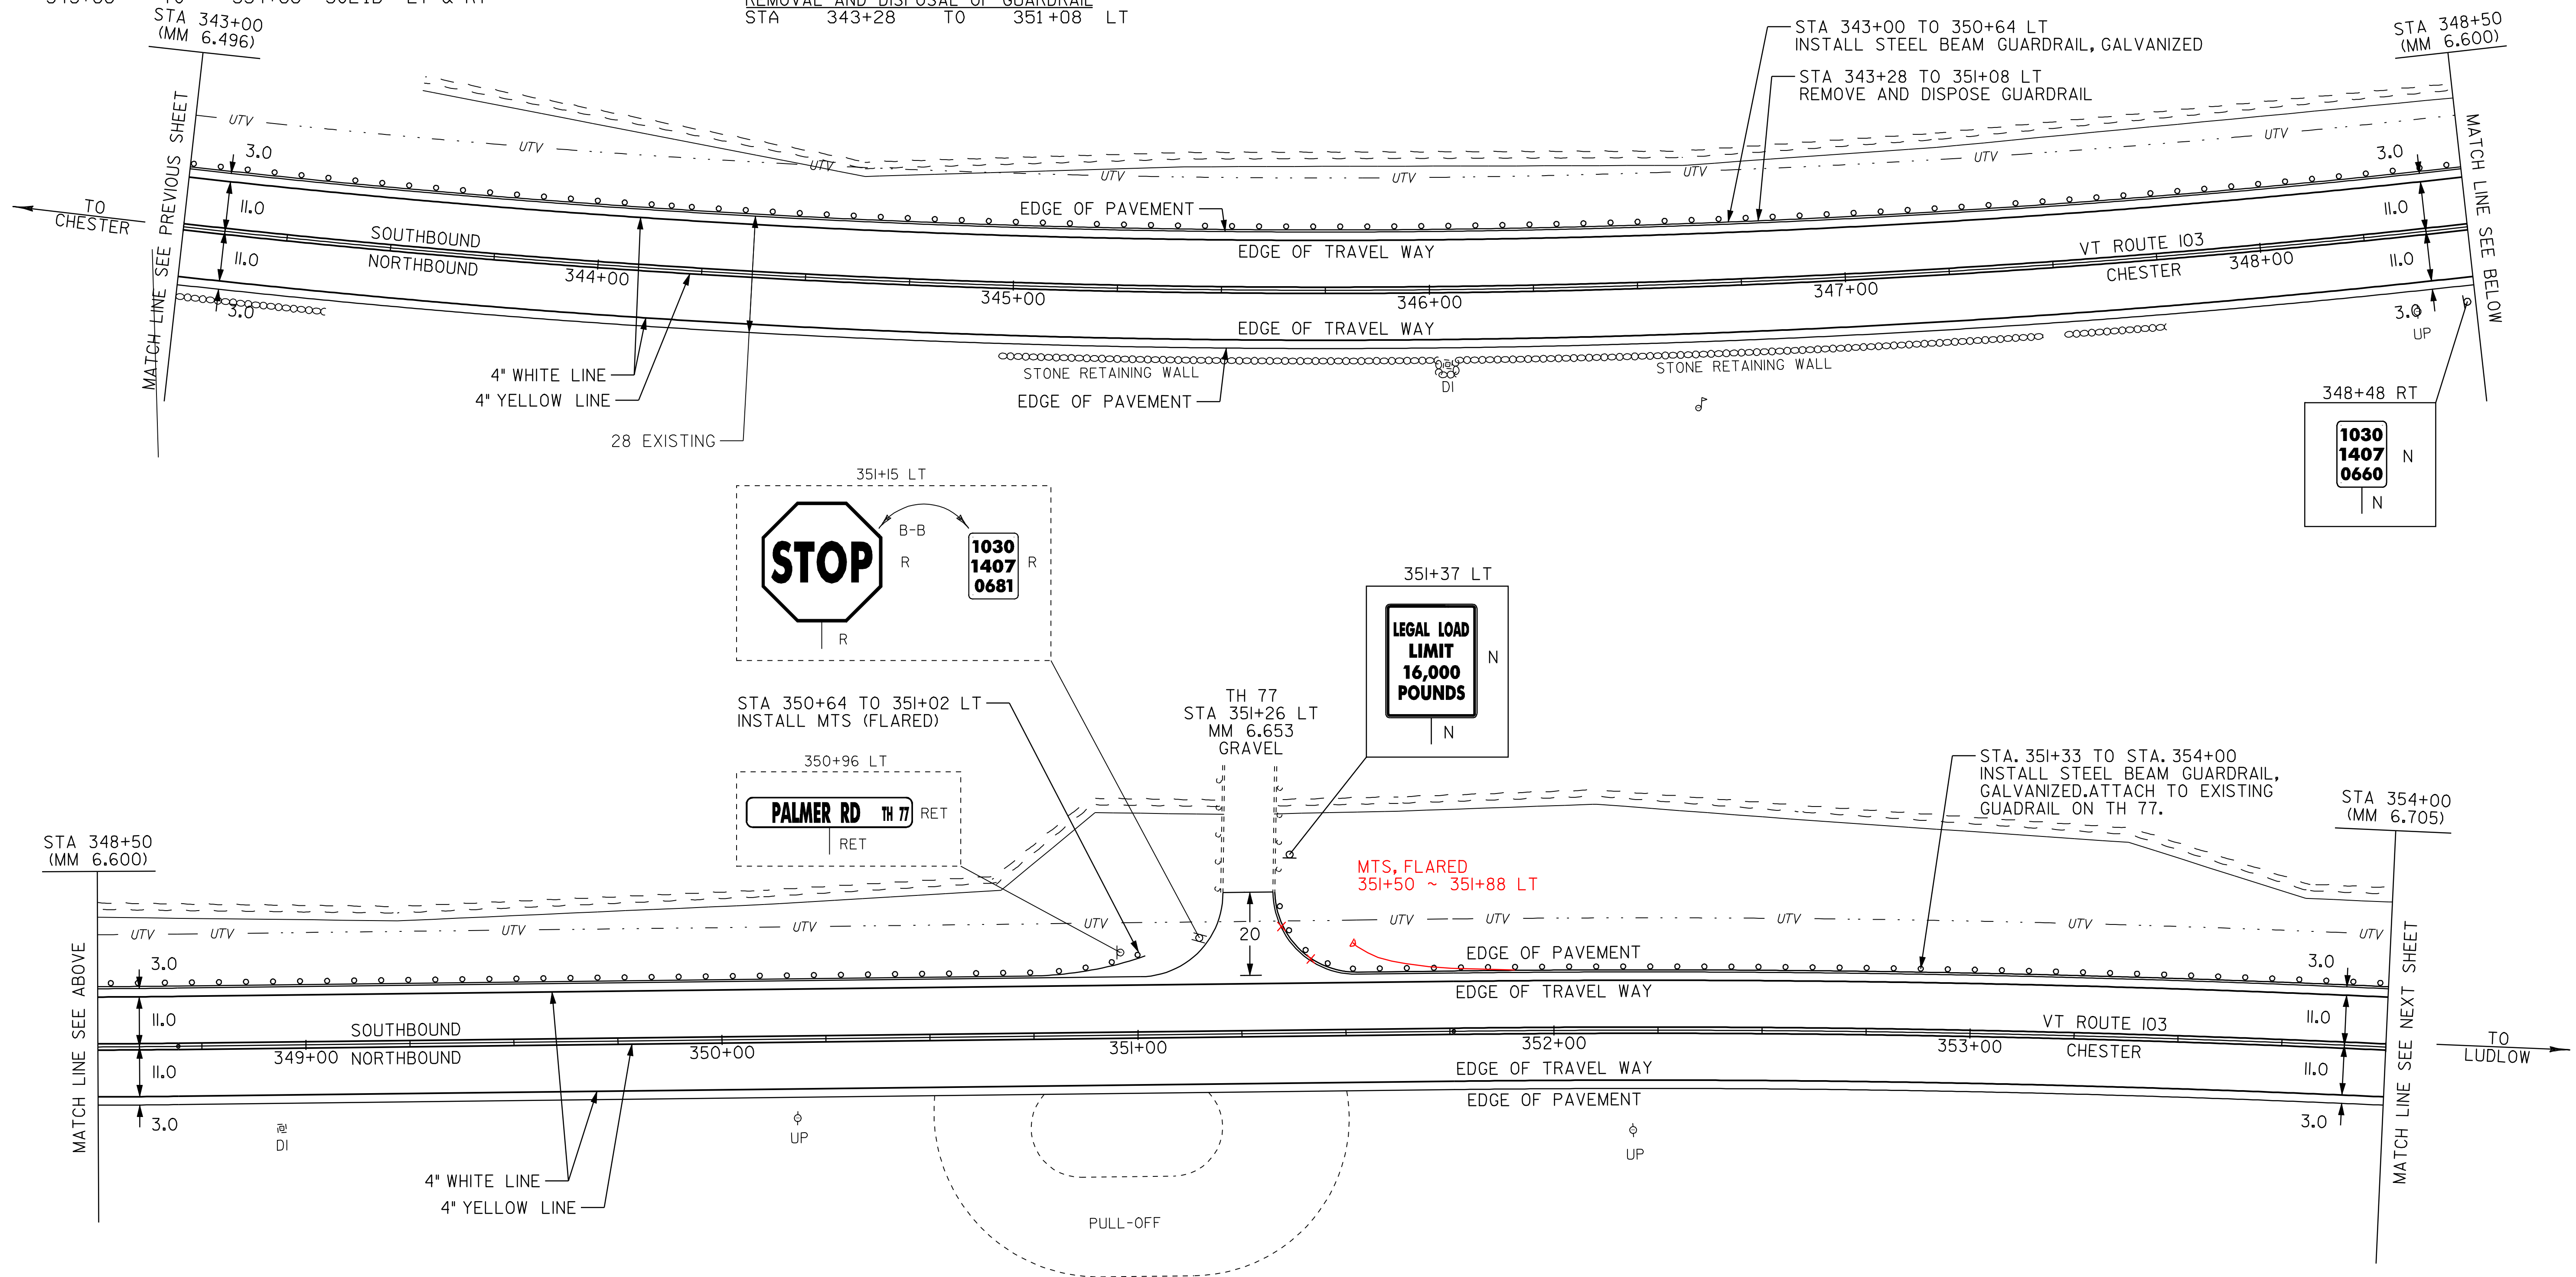

- LEGEND**
- R = REMOVE EXISTING
  - S = SALVAGE
  - R&S = REMOVE AND SALVAGE
  - N = NEW
  - RET = RETAIN
  - B-B = BACK TO BACK
  - = NEW RAIL
  - = EXISTING RAIL

**PAVING PROJECT LAYOUT #12**

PROJECT:	PROJECT NO.:
__CHESTER-LUDLOW__	__NH_2326(I)S__
DESIGN FILE NAME: \pave\01b038\pb038.dgn	PLOT DATE: 16-OCT-2009 16:
IPARM FILE NAME: pb0381a12.i	SURVEY DATE: 01/05
SURVEYED BY: CLD_ENGINEERS, INC	DRAWN BY: MRS
SQUAD LEADER: CRB	SHEET: 26 OF 110
CLD_04-0396	