

TEMPORARY 4" WHITE LINE, PAINT
 DURABLE 4" YELLOW LINE, THERMOPLASTIC
 STA 354+00 TO 365+00 SOLID LT
 STA 354+00 TO 365+00 SOLID RT

STEEL BEAM GUARDRAIL GALVANIZED
 STA 354+00 TO 355+69 LT
 STA 356+95 TO 358+30 LT
 STA 359+30 TO 365+00 LT

REMOVAL AND DISPOSAL OF GUARDRAIL
 STA 354+54 TO 360+96 LT





REMOVING SIGNS
 AS SHOWN - 3

TEMPORARY 4" YELLOW LINE, PAINT
 DURABLE 4" YELLOW LINE, THERMOPLASTIC
 STA 354+00 TO 365+00 SOLID LT & RT





STEEL BEAM GUARDRAIL, GALVANIZED W/8 FEET POSTS
 STA 355+69 TO 356+95 LT
 STA 358+30 TO 359+30 LT

STA 358+30 TO 359+30 LT
 INSTALL STEEL BEAM GUARDRAIL,
 GALVANIZED W/8' POSTS

359+04 LT
 1030
 1407
 0680
 N
 N

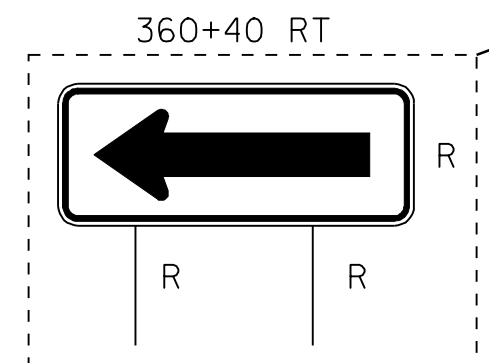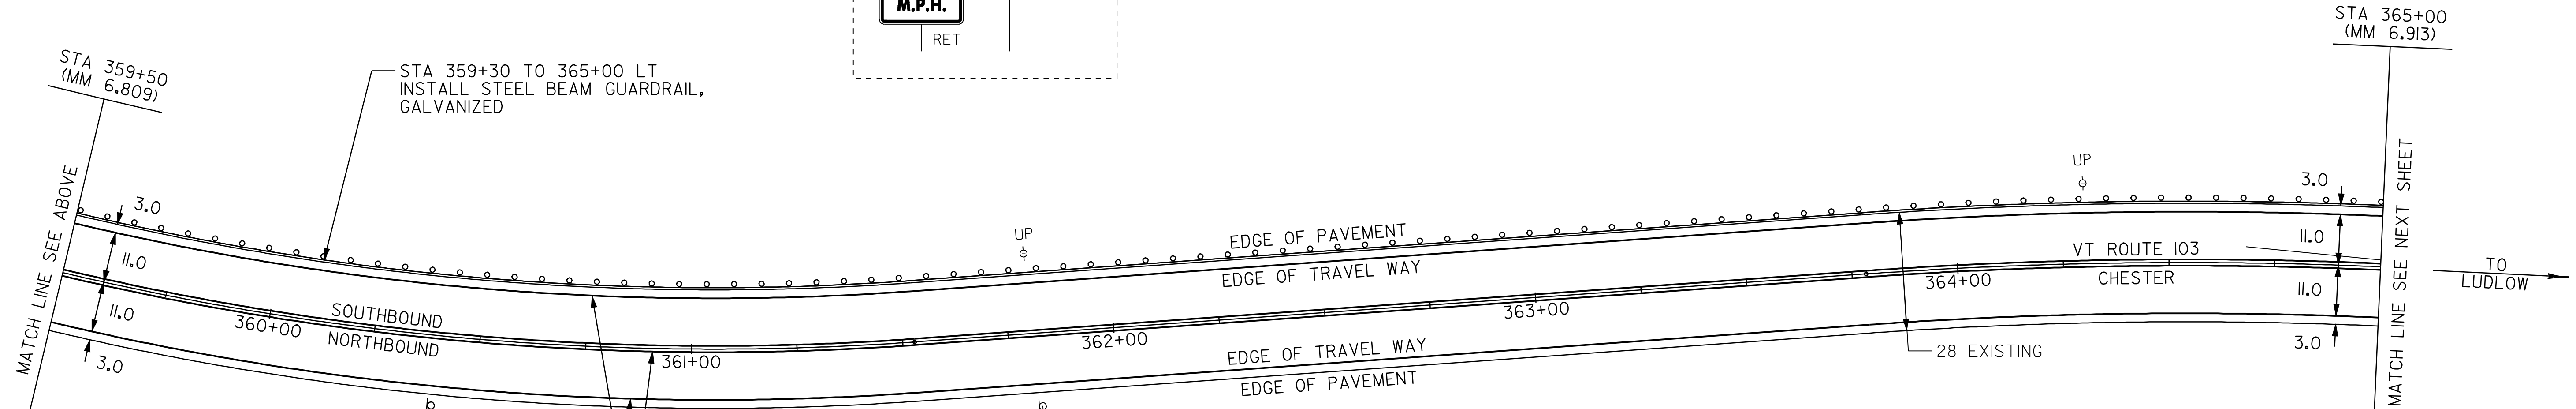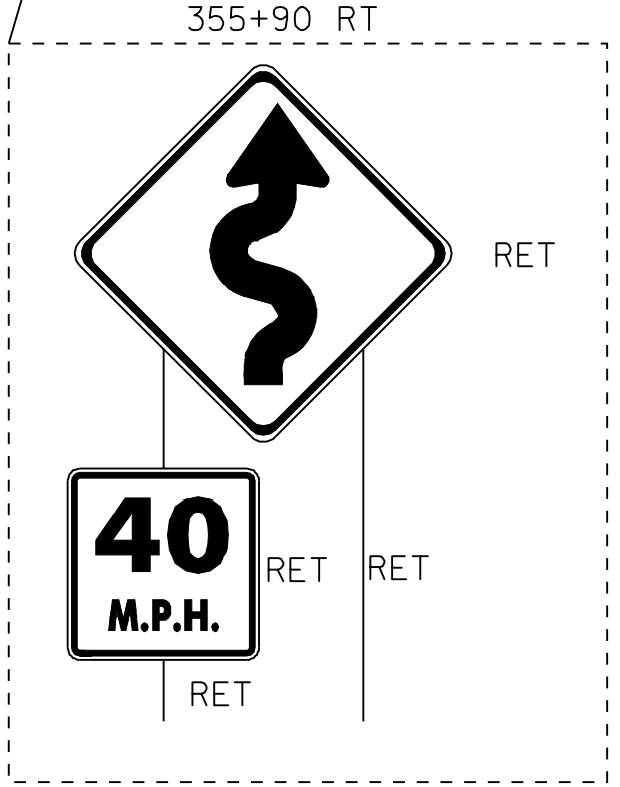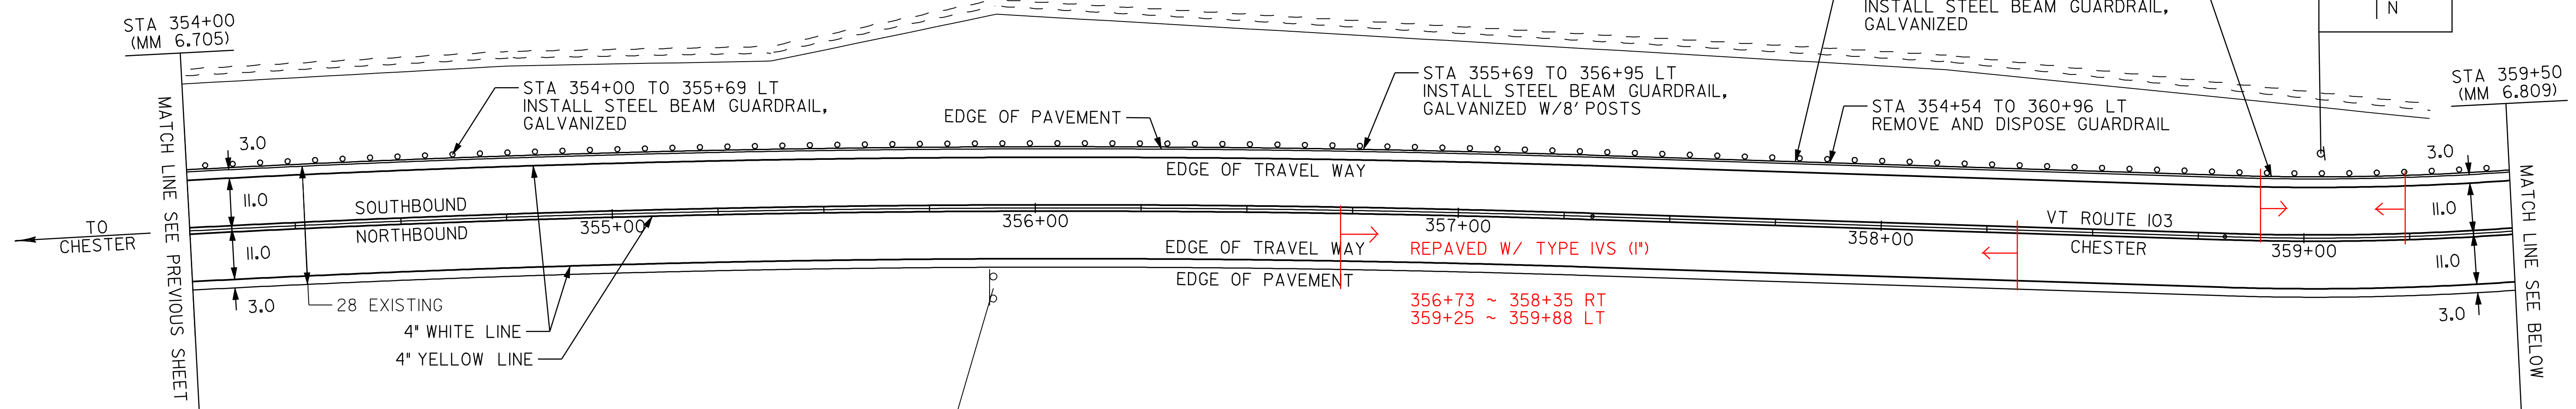

4" WHITE LINE
 4" YELLOW LINE

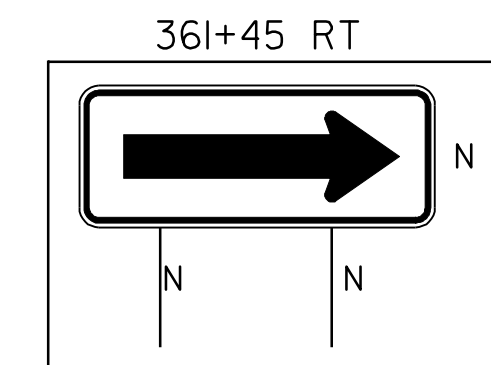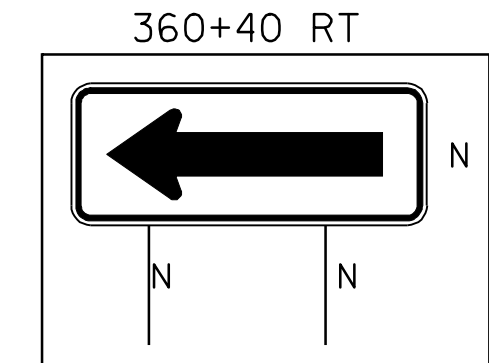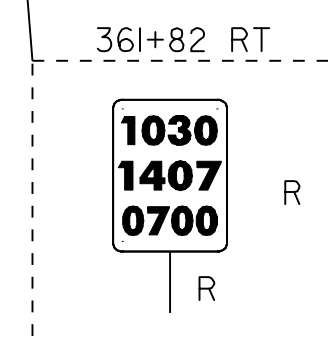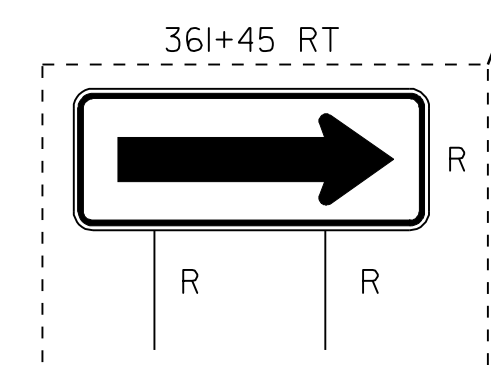

- LEGEND
- R = REMOVE EXISTING
 - S = SALVAGE
 - R&S = REMOVE AND SALVAGE
 - N = NEW
 - RET = RETAIN
 - B-B = BACK TO BACK
 - = NEW RAIL
 - = EXISTING RAIL

**PAVING
 PROJECT
 LAYOUT #13**

PROJECT: _CHESTER-LUDLOW	PROJECT NO.: _NH_2326(I)S_
DESIGN FILE NAME: Z:\pave\Q1b\Q38\pbQ38.dgn	PLOT DATE: 16-OCT-2009 16:
IPARM FILE NAME: pb0381a13.i	SURVEY DATE: Q1Q05
SQUAD LEADER: CLD_ENGINEERS, INC	DRAWN BY: MRS
CLD_04-0396	SHEET: 27 OF 110