

TEMPORARY 4" WHITE LINE, PAINT
 DURABLE 4" WHITE LINE, THERMOPLASTIC
 STA 375+50 TO 385+50 SOLID LT
 STA 375+50 TO 385+50 SOLID RT



TEMPORARY 4" YELLOW LINE, PAINT
 DURABLE 4" YELLOW LINE, THERMOPLASTIC
 STA 375+50 TO 385+50 SOLID LT & RT

STEEL BEAM GUARDRAIL, GALVANIZED
 STA 375+50 TO 381+99 LT
 STA 383+49 TO 385+50 LT

MANUFACTURED TERMINAL SECTION, FLARED
 STA 381+99 LT
 STA 383+49 LT

REMOVAL AND DISPOSAL OF GUARDRAIL
 STA 375+50 TO 382+38 LT
 STA 383+11 TO 385+50 LT

REMOVING SIGNS
 AS SHOWN - 1

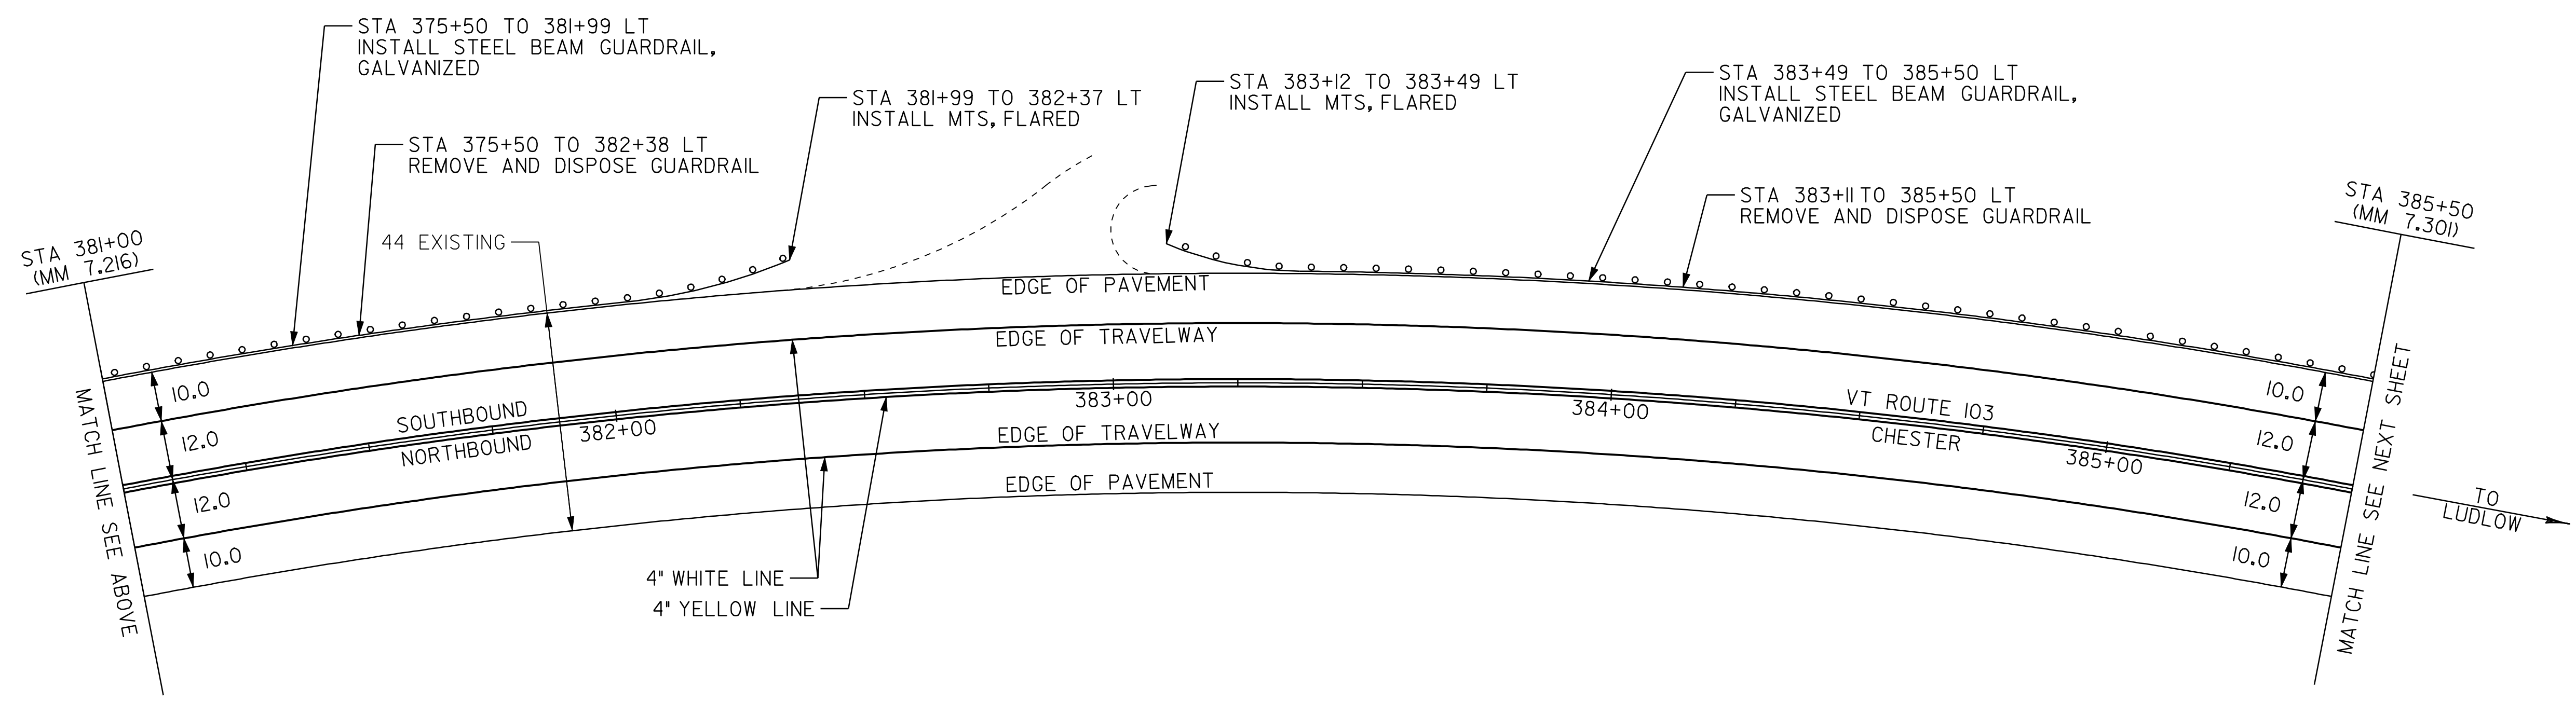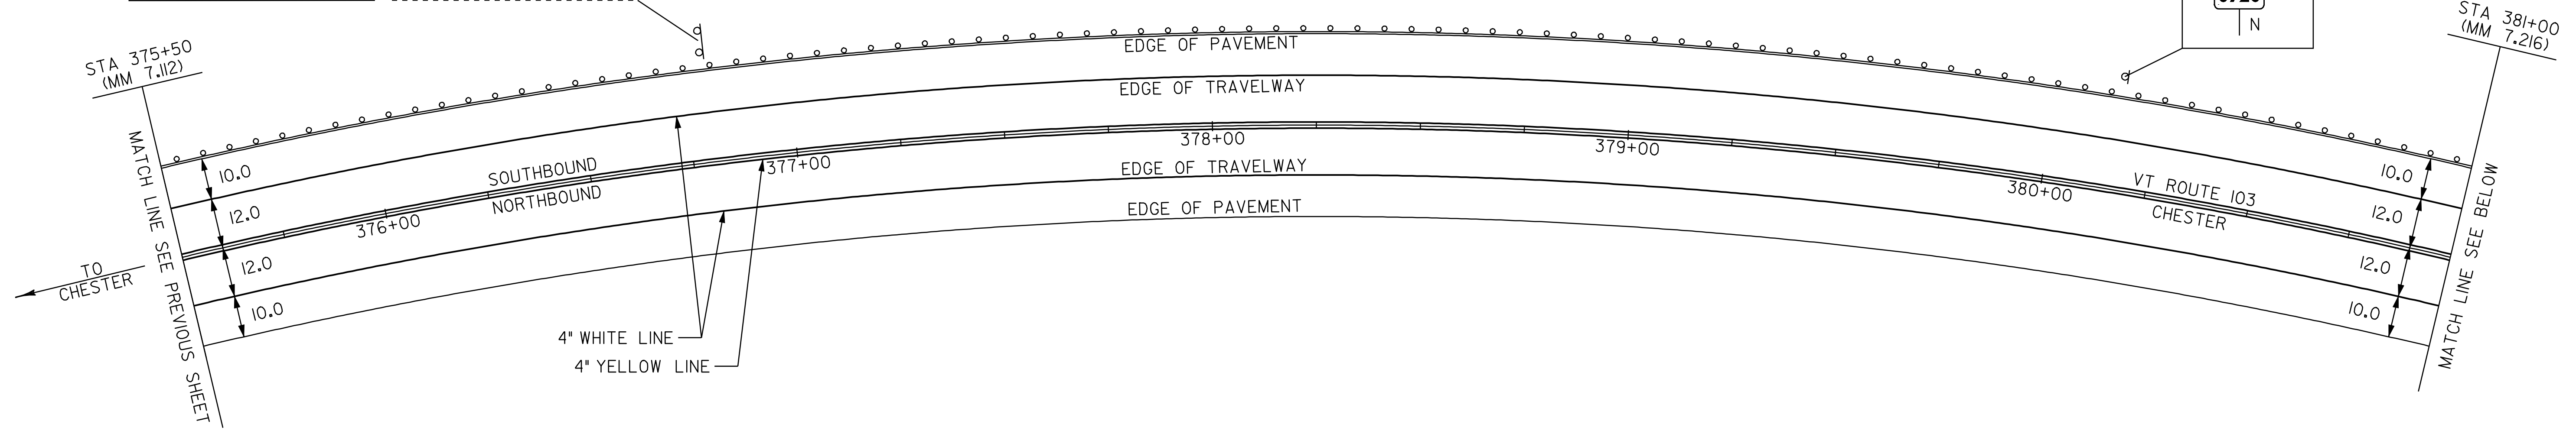

- LEGEND**
- R = REMOVE EXISTING
 - S = SALVAGE
 - R&S = REMOVE AND SALVAGE
 - N = NEW
 - RET = RETAIN
 - B-B = BACK TO BACK
 - = NEW RAIL
 - = EXISTING RAIL

**PAVING
 PROJECT
 LAYOUT #15**

PROJECT: _CHESTER-LUDLOW	PROJECT NO.: _NH_2326(I)S_
DESIGN FILE NAME: \pave\01b038\pb038.dgn	PLOT DATE: 16-OCT-2009 16:
IPARM FILE NAME: pb0381a15.i	SURVEY DATE: 01/05
SURVEYED BY: CLD_ENGINEERS, INC	DRAWN BY: MRS
SQUAD LEADER: CRB	SHEET: 29 OF 110
_CLD_04-0396	