


TEMPORARY 4" WHITE LINE, PAINT  
 DURABLE 4" WHITE LINE, THERMOPLASTIC  
 STA 474+00 TO 474+57 SOLID LT  
 STA 474+00 TO 485+00 SOLID RT  
 STA 474+96 TO 485+00 SOLID LT

TEMPORARY 4" YELLOW LINE, PAINT  
 DURABLE 4" YELLOW LINE, THERMOPLASTIC  
 STA 474+00 TO 474+49 SOLID LT & RT  
 STA 474+69 TO 474+89 DOUBLE SOLID LT (TH 15)  
 STA 474+89 TO 475+70 SOLID LT & RT  
 STA 475+70 TO 480+70 SOLID LT, DASHED RT  
 STA 480+70 TO 485+00 DASHED

TEMPORARY 24" STOP BAR, PAINT  
 DURABLE 24" STOP BAR, THERMOPLASTIC  
 STA 474+69 LT (TH 15)  
 TEMPORARY LETTER OR SYMBOL, PAINT  
 DURABLE LETTER OR SYMBOL, THERMOPLASTIC  
 STA 474+57 LT - "STOP" (TH 15)

STEEL BEAM GUARDRAIL, GALVANIZED  
 475+93 STA ~~476+05~~ TO 478+67 RT  
 STA 482+65 TO 483+65 RT  
 STA 483+04 TO ~~484+16~~ LT  
 483+80  
 MANUFACTURED TERMINAL SECTION, FLARED  
 STA ~~476+05~~ RT 475+93  
 STA 478+67 RT  
 STA 482+65 RT  
 STA 483+04 LT  
 STA 483+65 RT  
 STA ~~484+16~~ LT  
 483+80  
 REMOVAL AND DISPOSAL OF GUARDRAIL  
 STA 475+67 TO 479+07 RT  
 STA 482+31 TO 483+99 RT  
 STA 482+66 TO 484+50 LT

REMOVING SIGNS  
 AS SHOWN - 6

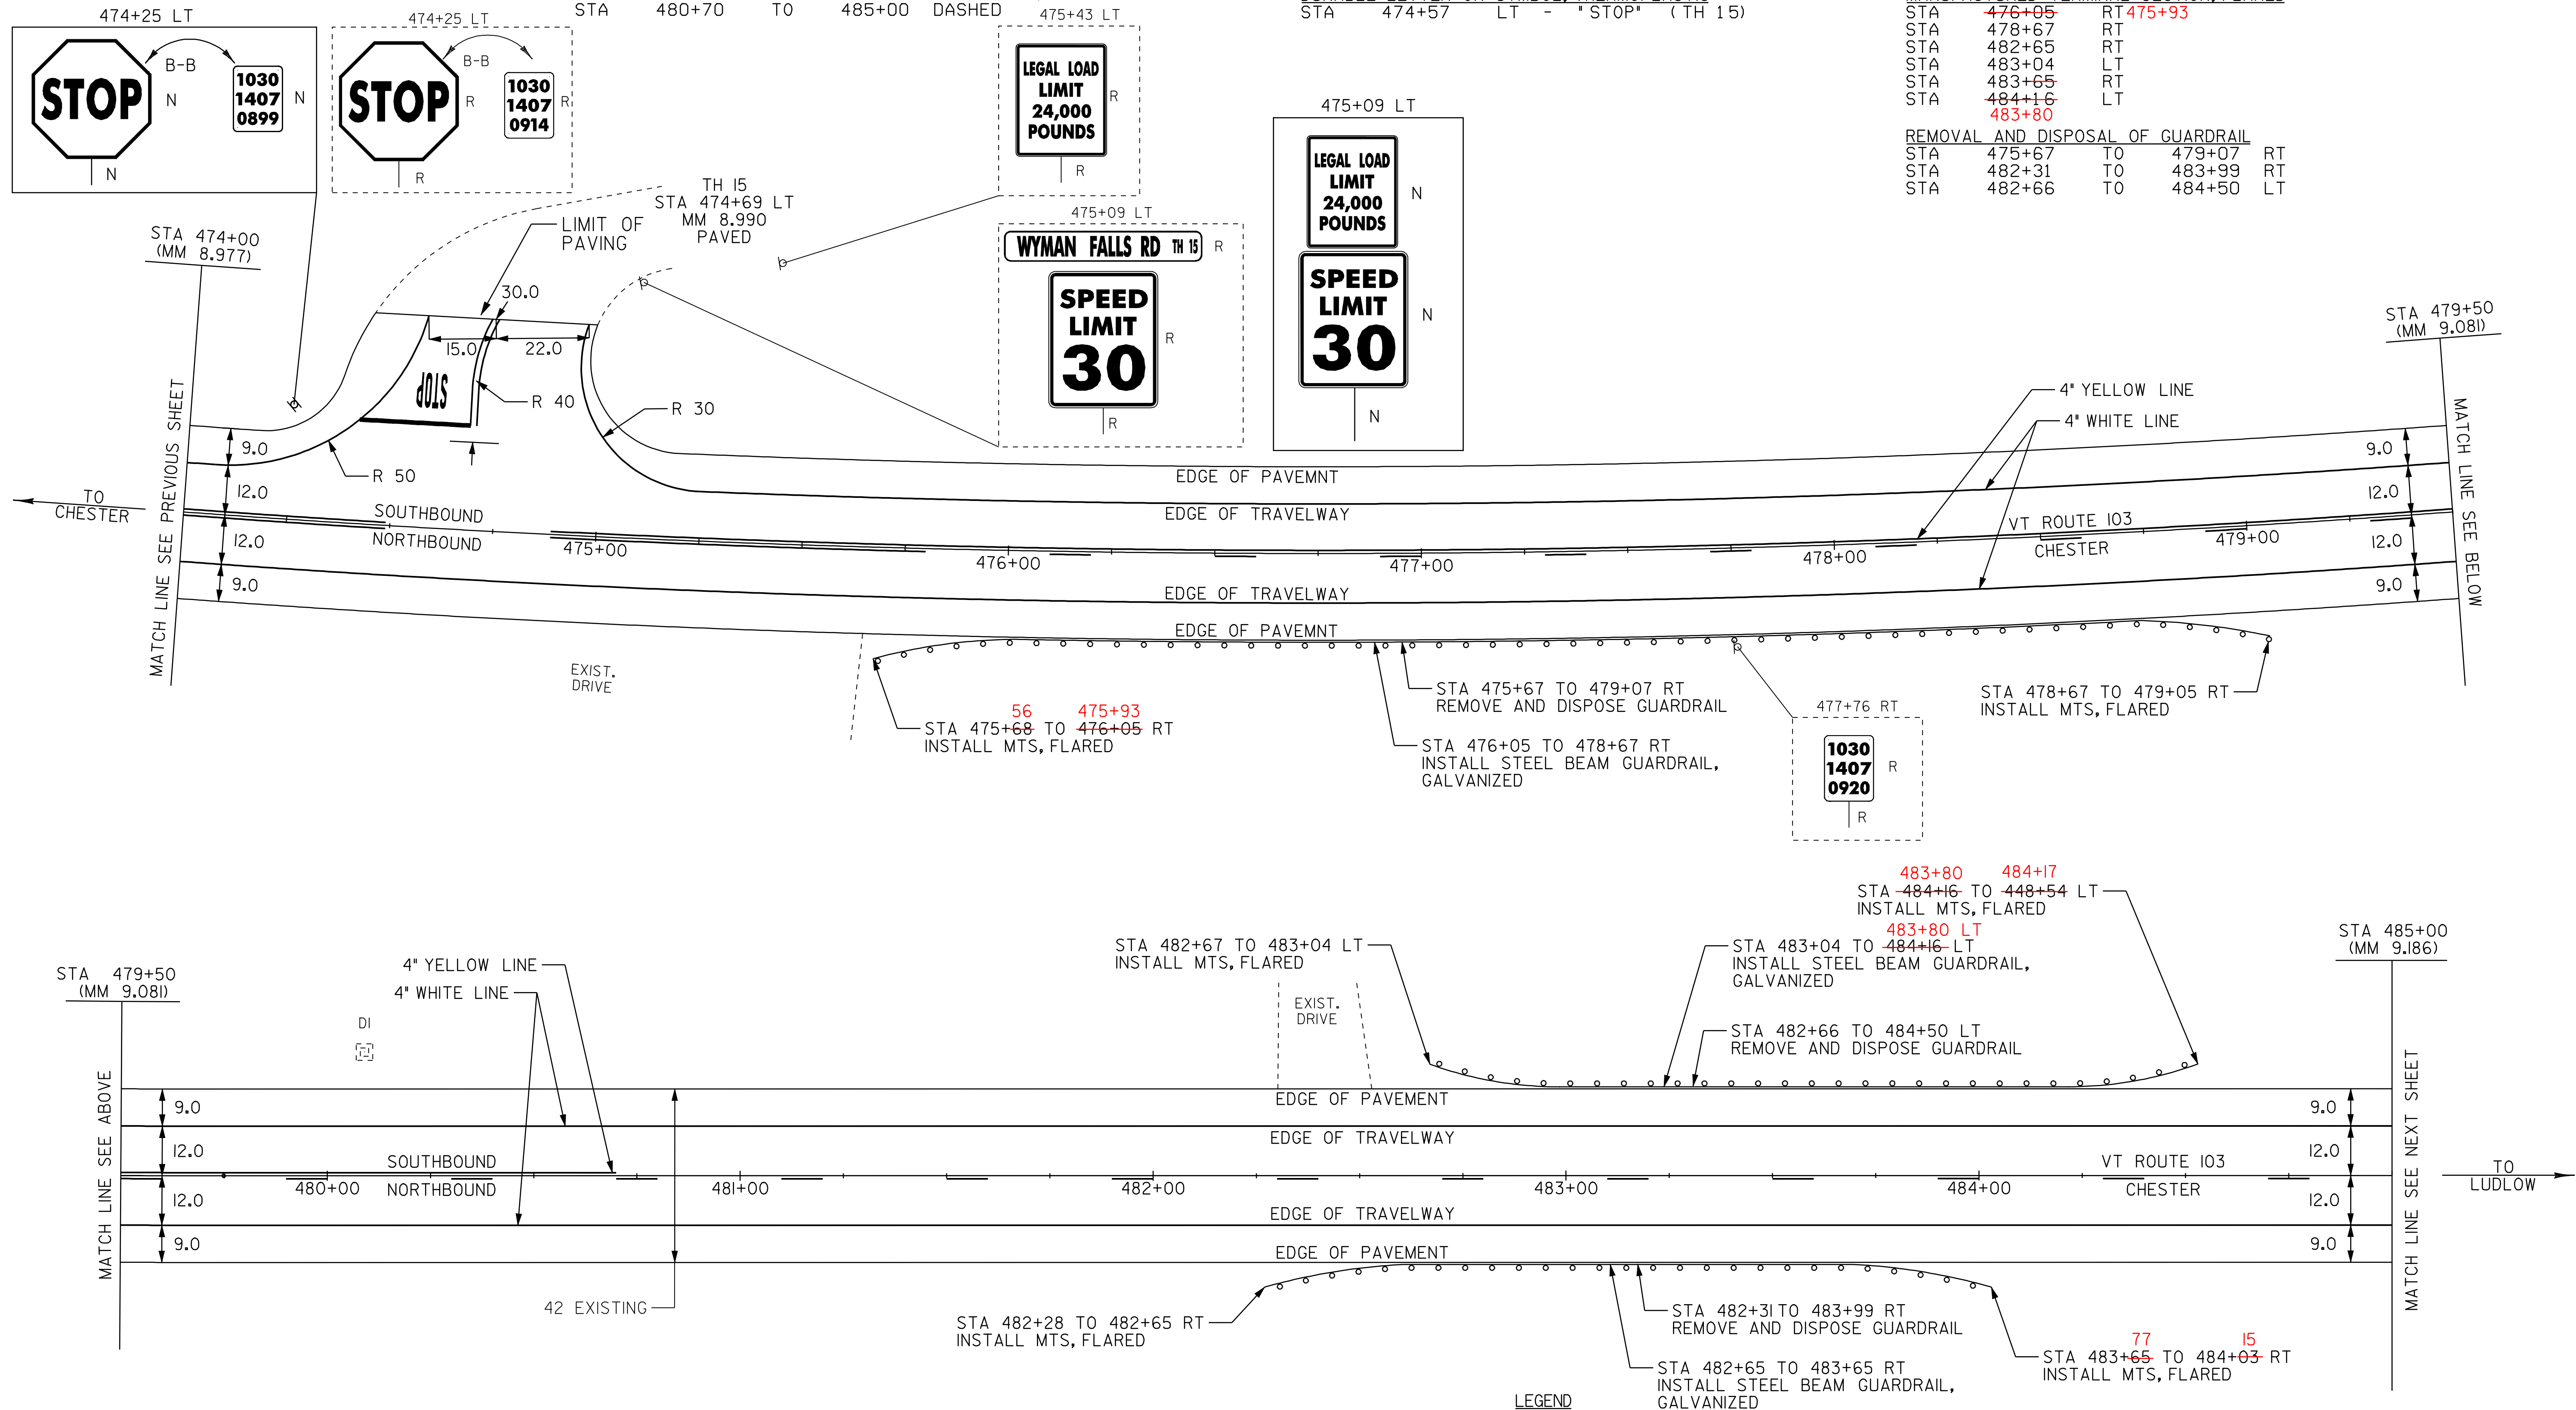

- LEGEND
- R = REMOVE EXISTING
  - S = SALVAGE
  - R&S = REMOVE AND SALVAGE
  - N = NEW
  - RET = RETAIN
  - B-B = BACK TO BACK
  - = NEW RAIL
  - — — = EXISTING RAIL

**PAVING  
 PROJECT  
 LAYOUT #26**

PROJECT: _CHESTER-LUDLOW	PROJECT NO.: _NH_2326(I)S_
DESIGN FILE NAME: \pave\01b038\pb038.dgn	PLOT DATE: 16-OCT-2009 17:
IPARM FILE NAME: pb0381a26.i	SURVEY DATE: 01/05
SURVEYED BY: CLD_ENGINEERS, INC	SQUAD LEADER: CRB
DRAWN BY: MRS	SHEET: 40 OF 110