


TEMPORARY 4" WHITE LINE, PAINT
 DURABLE 4" WHITE LINE, THERMOPLASTIC
 STA 496+00 TO 498+60 SOLID LT
 STA 496+00 TO 507+00 SOLID RT
 STA 498+83 TO 507+00 SOLID LT

TEMPORARY 4" YELLOW LINE, PAINT
 DURABLE 4" YELLOW LINE, THERMOPLASTIC
 STA 496+00 TO 498+50 SOLID LT & RT
 STA 498+70 TO 499+00 DOUBLE SOLID LT (TH 9)
 STA 498+90 TO 499+00 SOLID LT & RT
 STA 499+00 TO 503+80 SOLID LT, DASHED RT
 STA 503+80 TO 507+00 DASHED

TEMPORARY 24" STOP BAR, PAINT
 DURABLE 24" STOP BAR, THERMOPLASTIC
 STA 498+70 LT (TH 9)
 TEMPORARY LETTER OR SYMBOL, PAINT
 DURABLE LETTER OR SYMBOL, THERMOPLASTIC
 STA 498+65 LT - "STOP" (TH 9)
 REMOVING SIGNS
 AS SHOWN - 14
 ERECTING SALVAGED SIGNS
 AS SHOWN - 1

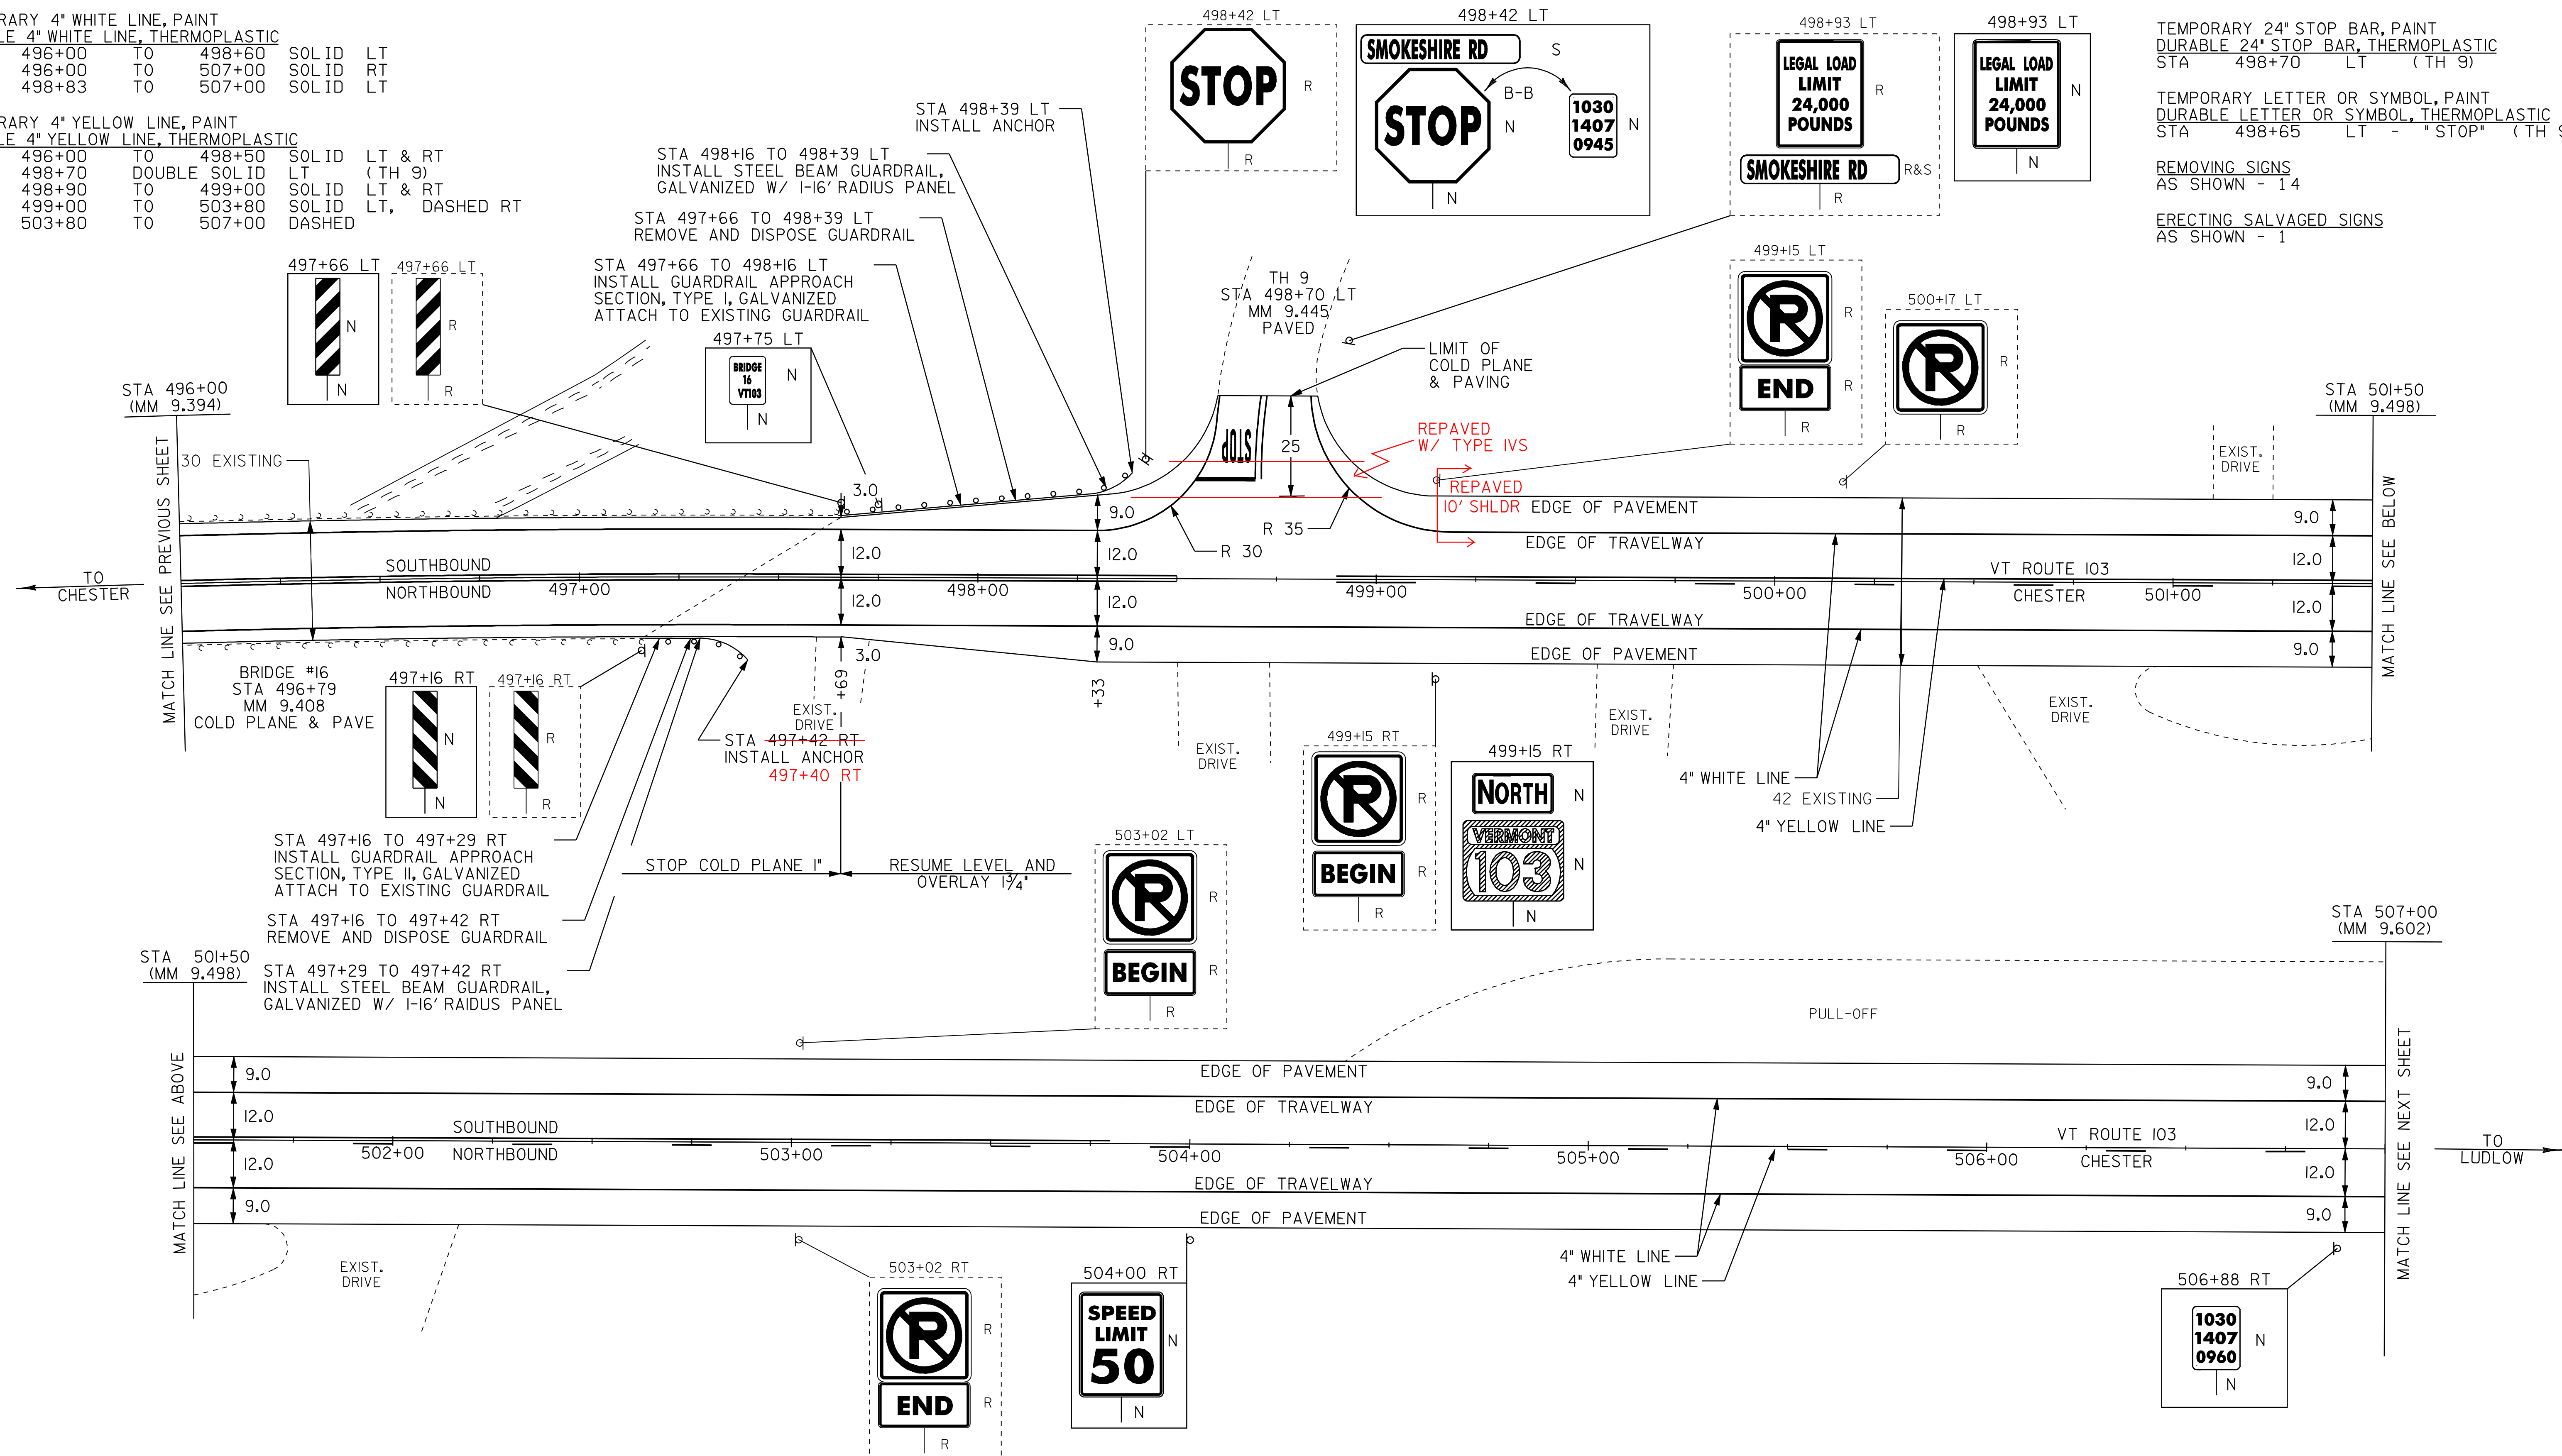

STEEL BEAM GUARDRAIL, GALVANIZED
 STA 497+29 TO 497+42 RT
 STA 498+16 TO 498+39 LT

GUARDRAIL APPROACH SECTION, GALVANIZED TYPE I
 STA 497+66 TO 498+16 LT

GUARDRAIL APPROACH SECTION, GALVANIZED TYPE II
 STA 497+16 TO 497+29 RT

ANCHOR FOR STEEL BEAM RAIL
 STA 497+42 RT
 STA 498+39 LT

REMOVAL AND DISPOSAL OF GUARDRAIL
 STA 497+16 TO 497+42 RT
 STA 497+66 TO 498+39 LT

- LEGEND**
- R = REMOVE EXISTING
 - S = SALVAGE
 - R&S = REMOVE AND SALVAGE
 - N = NEW
 - RET = RETAIN
 - B-B = BACK TO BACK
 - = NEW RAIL
 - - - = EXISTING RAIL

PAVING PROJECT LAYOUT #28

PROJECT: CHESTER-LUDLOW	PROJECT NO.: NH 2326(1)S
DESIGN FILE NAME: Z:\pave\01b038\pb038.dgn	PLOT DATE: 16-OCT-2009 17:
IPARM FILE NAME: pb0381a28.1	SURVEY DATE: 01/05
SURVEYED BY: CLD_ENGINEERS, INC	SQUAD LEADER: CRB
DRAWN BY: MRS	SHEET: 42 OF 110