
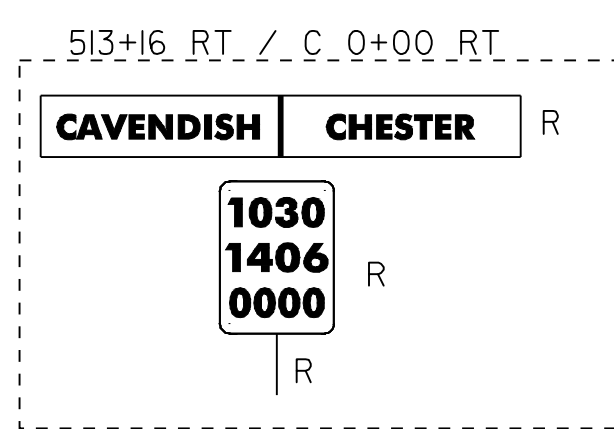
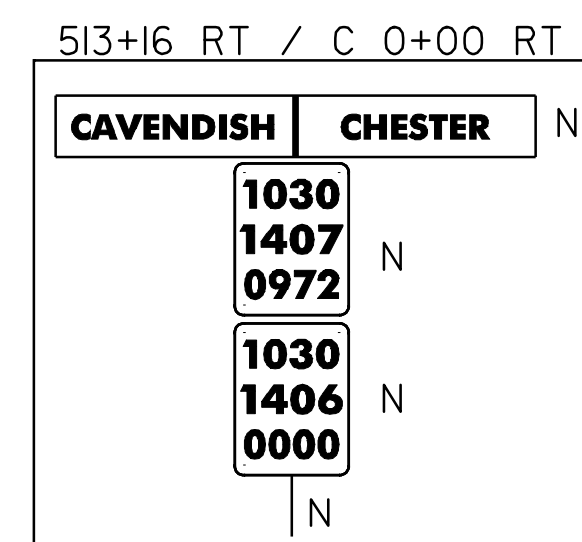
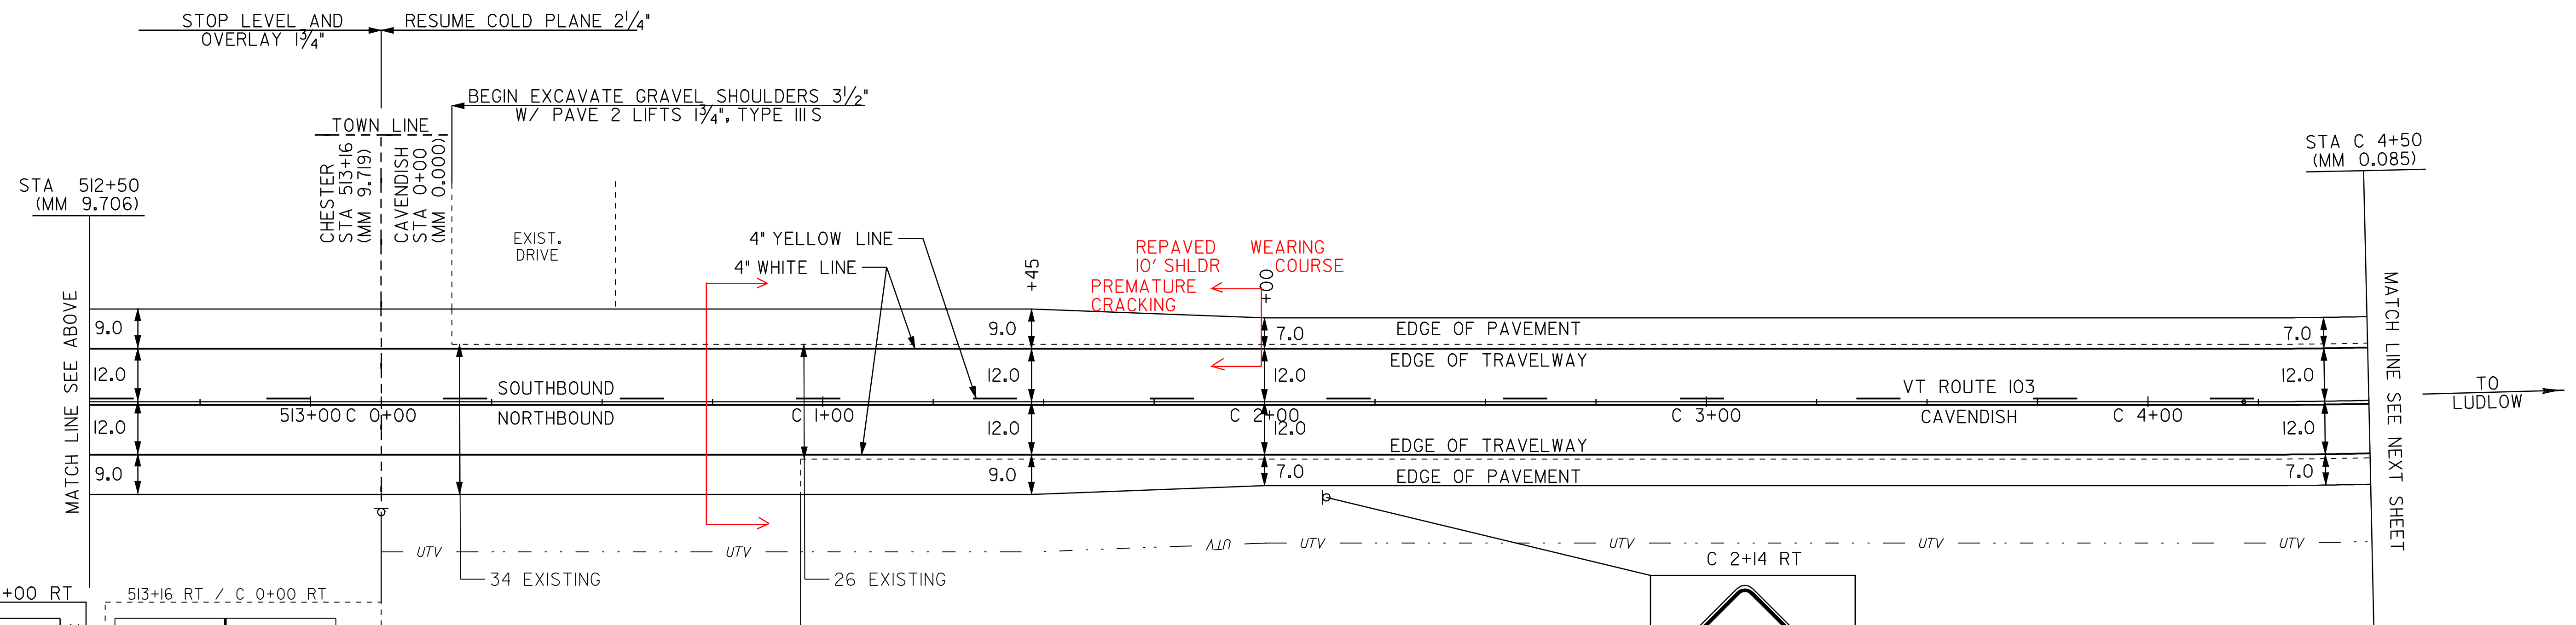
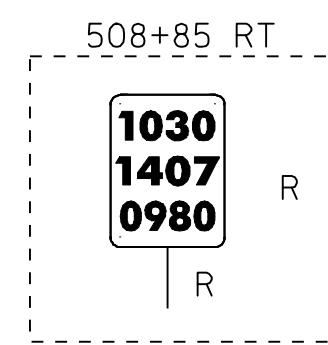



TEMPORARY 4" WHITE LINE, PAINT
 DURABLE 4" WHITE LINE, THERMOPLASTIC
 STA 507+00 TO C 4+50 SOLID LT
 STA 507+00 TO C 4+50 SOLID RT

TEMPORARY 4" YELLOW LINE, PAINT
 DURABLE 4" YELLOW LINE, THERMOPLASTIC
 STA 507+00 TO 511+70 DASHED
 STA 511+70 TO C 4+50 DASHED LT, SOLID RT

REMOVING SIGNS
 AS SHOWN - 3

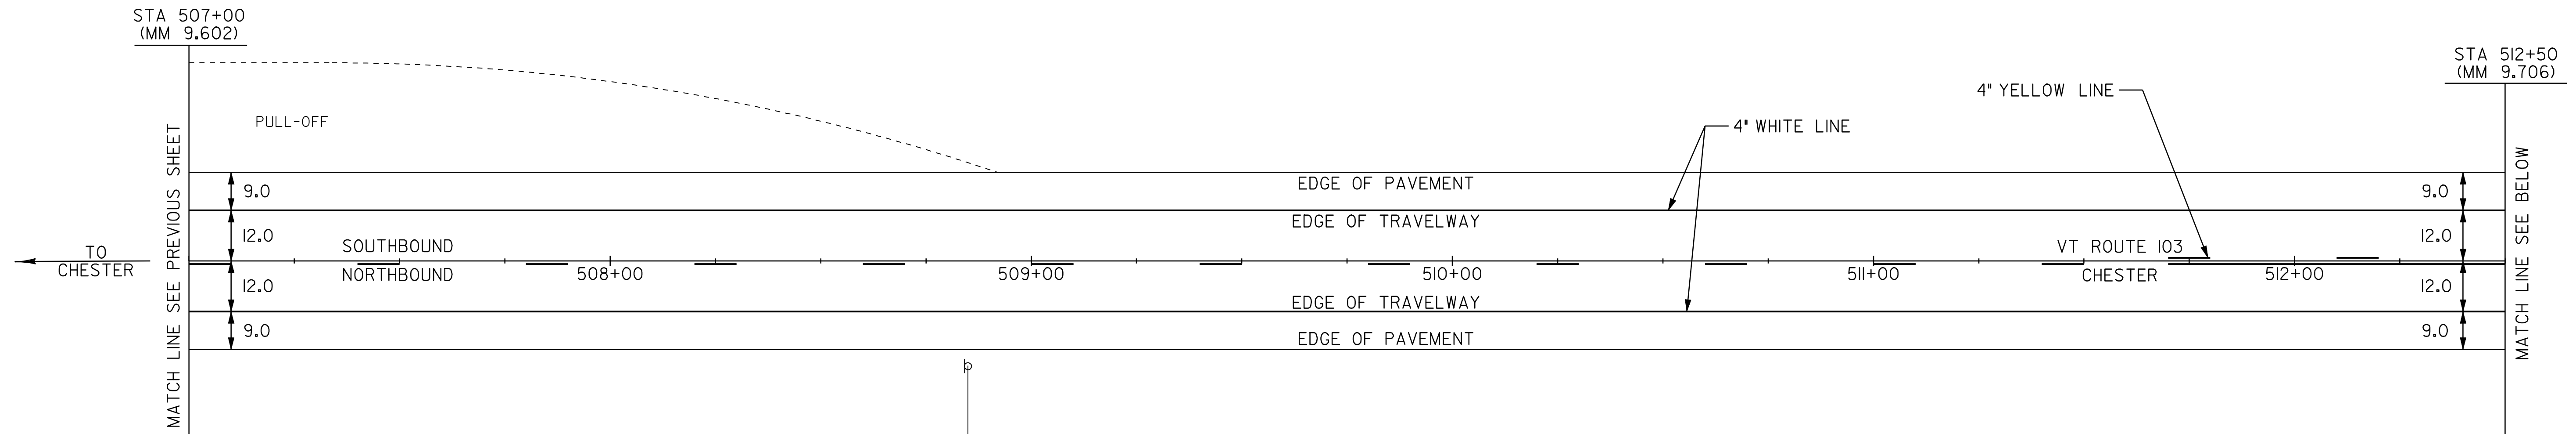

OVERLAID WEARING COURSE
 W/(1") TYPE IVS
 C 0+75 ~ C 104+29 CL

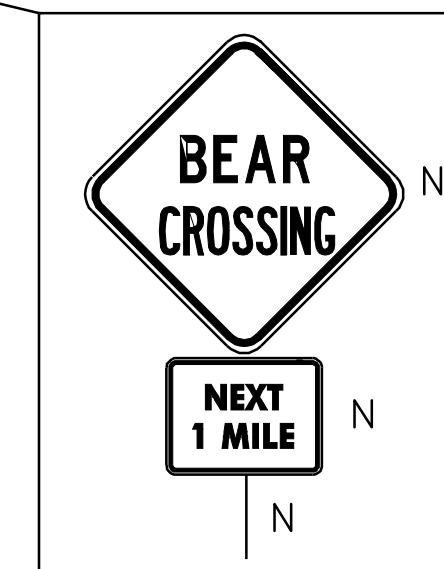

- LEGEND
- R = REMOVE EXISTING
 - S = SALVAGE
 - R&S = REMOVE AND SALVAGE
 - N = NEW
 - RET = RETAIN
 - B-B = BACK TO BACK
 - = NEW RAIL
 - - - = EXISTING RAIL

**PAVING
 PROJECT
 LAYOUT #29**

PROJECT: _CHESTER-LUDLOW	PROJECT NO.: _NH_2326(1)S_
DESIGN FILE NAME: Zpave\Qlb038\pb038.dgn	PLOT DATE: 16-OCT-2009 17:
IPARM FILE NAME: pb0381a29.1	SURVEY DATE: 01/05
SURVEYED BY: CLD_ENGINEERS, INC	DRAWN BY: MRS
SQUAD LEADER: CRB	SHEET: 43 OF 110
_CLD_04-0396	