

TEMPORARY 4" WHITE LINE, PAINT
 DURABLE 4" WHITE LINE, THERMOPLASTIC
 STA C 26+00 TO C 37+00 SOLID LT
 STA C 26+00 TO C 37+00 SOLID RT
 STA C 30+90 TO C 37+00 DASHED RT (LANE)

TEMPORARY 4" YELLOW LINE, PAINT
 DURABLE 4" YELLOW LINE, THERMOPLASTIC
 STA C 26+00 TO C 37+00 SOLID LT & RT


STEEL BEAM GUARDRAIL, GALVANIZED
 STA C 30+43 TO C 30+93 RT
 STA C 33+01 TO C 37+00 RT

MANUFACTURED TERMINAL SECTION, FLARED
 STA C 30+43 RT
 STA C 30+93 RT

ANCHOR FOR STEEL BEAM RAIL
 STA C 33+01 RT

REMOVAL AND DISPOSAL OF GUARDRAIL
 STA C 30+06 TO C 31+29 RT
 STA C 33+01 TO C 37+00 RT

REMOVING SIGNS
 AS SHOWN - 4

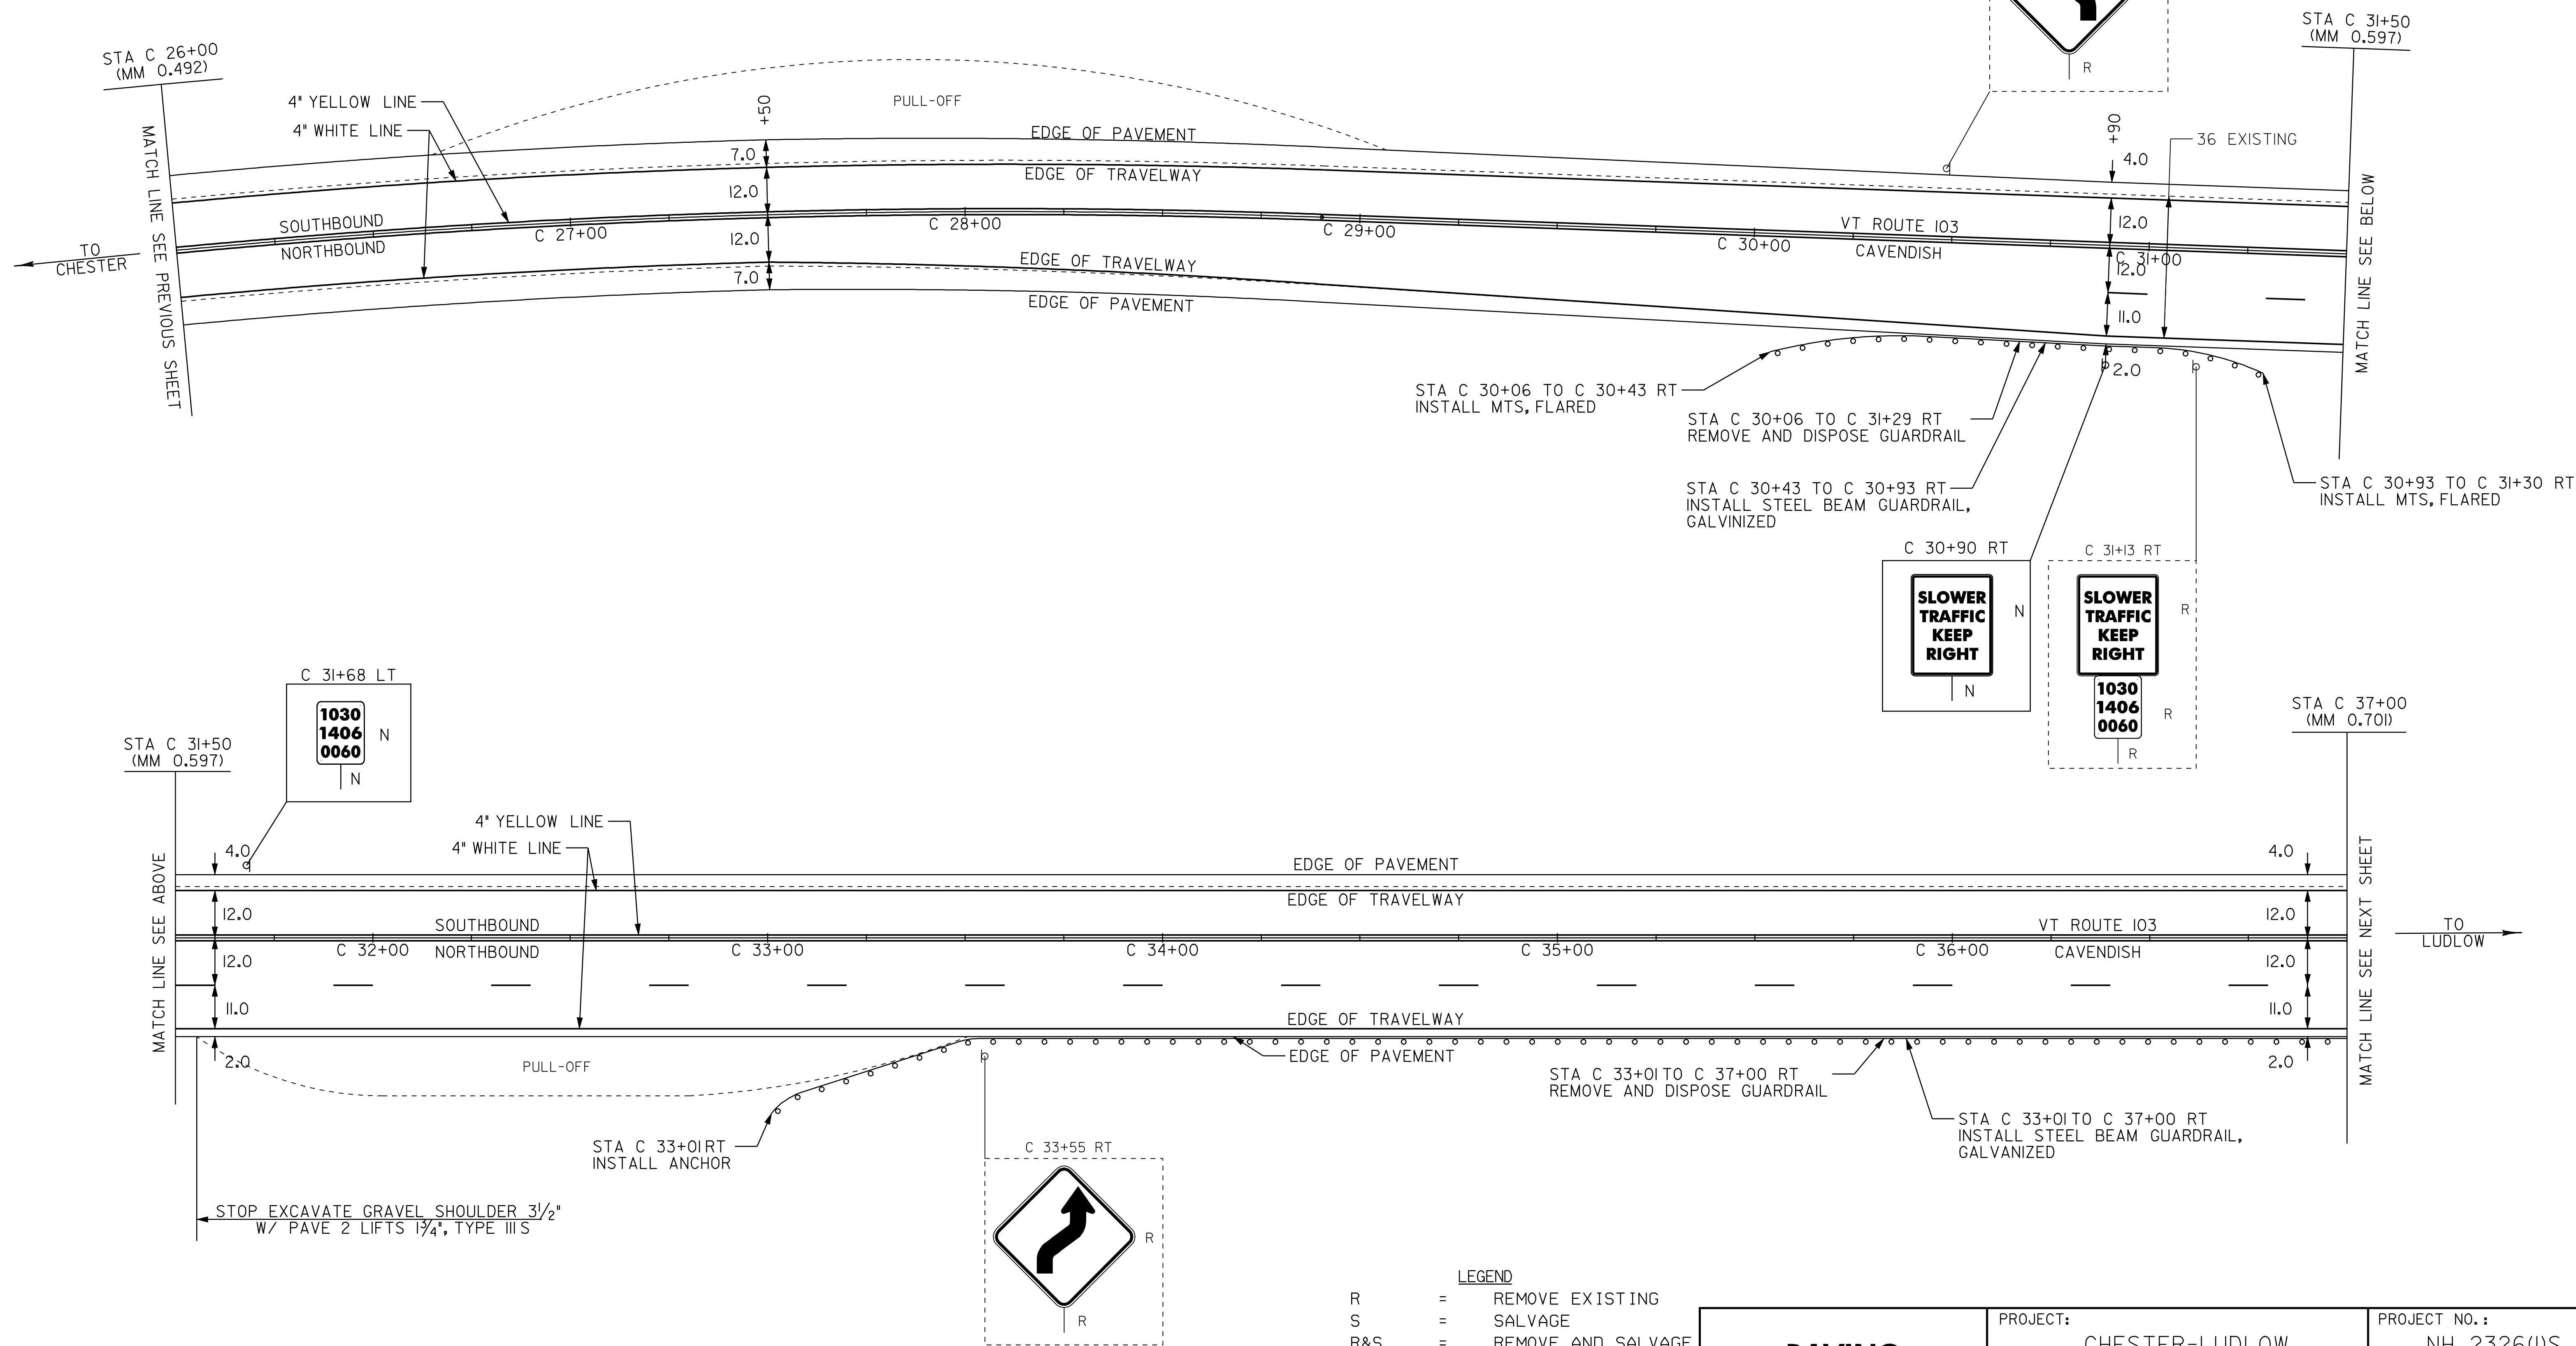

- LEGEND**
- R = REMOVE EXISTING
 - S = SALVAGE
 - R&S = REMOVE AND SALVAGE
 - N = NEW
 - RET = RETAIN
 - B-B = BACK TO BACK
 - = NEW RAIL
 - - - = EXISTING RAIL

PAVING PROJECT LAYOUT #32

PROJECT:	PROJECT NO.:
_CHESTER-LUDLOW	_NH_2326(1)S_
DESIGN FILE NAME: Z:\pave\01b038\pb038.dgn	PLOT DATE: 16-OCT-2009 17:
IPARM FILE NAME: pb0381a32.1	SURVEY DATE: 01/05
SURVEYED BY: CLD_ENGINEERS, INC	DRAWN BY: MRS
SQUAD LEADER: CRB	SHEET: 46 OF 110
_CLD_04-0396	