

TEMPORARY 4" WHITE LINE, PAINT
 DURABLE 4" WHITE LINE, THERMOPLASTIC
 STA C 47+50 TO C 58+00 SOLID LT
 STA C 47+50 TO C 58+00 SOLID RT
 STA C 47+50 TO C 58+50 DASHED RT (LANE)



TEMPORARY 4" YELLOW LINE, PAINT
 DURABLE 4" YELLOW LINE, THERMOPLASTIC
 STA C 47+50 TO C 58+00 SOLID LT & RT

STEEL BEAM GUARDRAIL, GALVANIZED
 STA C 53+26 TO C 58+00 RT
~~ANCHOR FOR STEEL BEAM RAIL~~
~~STA C 53+26 RT~~

REMOVAL AND DISPOSAL OF GUARDRAIL
 STA C 47+50 TO C 47+64 LT
 STA C 54+49 TO C 58+00 RT
 STA C 57+74 TO C 58+00 LT

REMOVING SIGNS
 AS SHOWN - 1

MANUFACTURED TERMINAL SECTION, FLARED
 STA C 54+88.5 RT

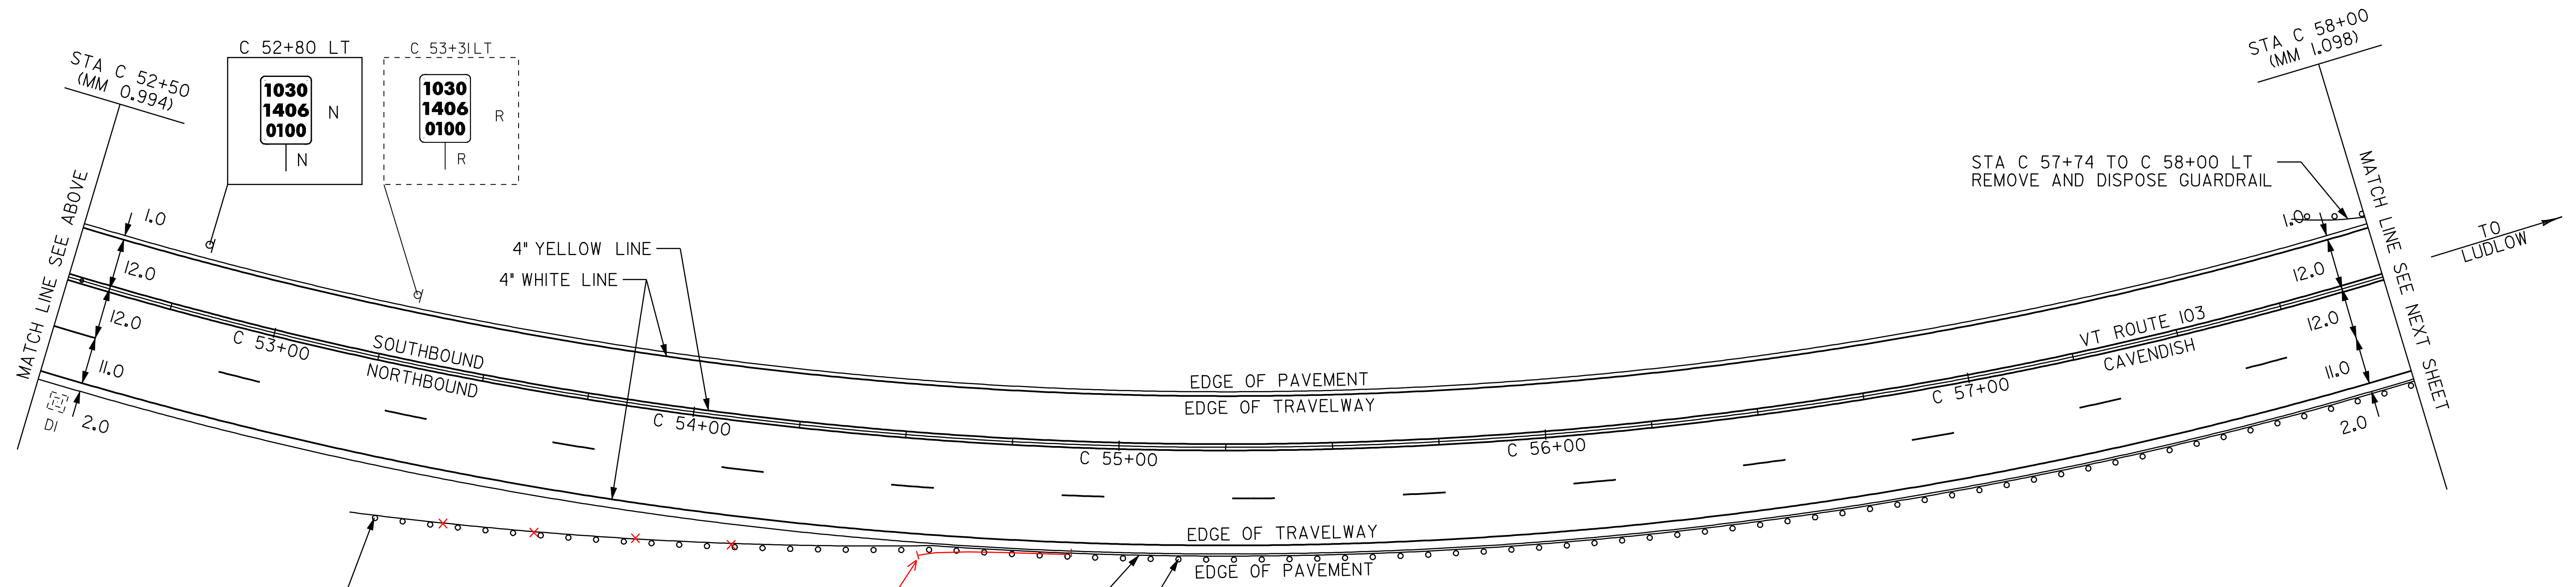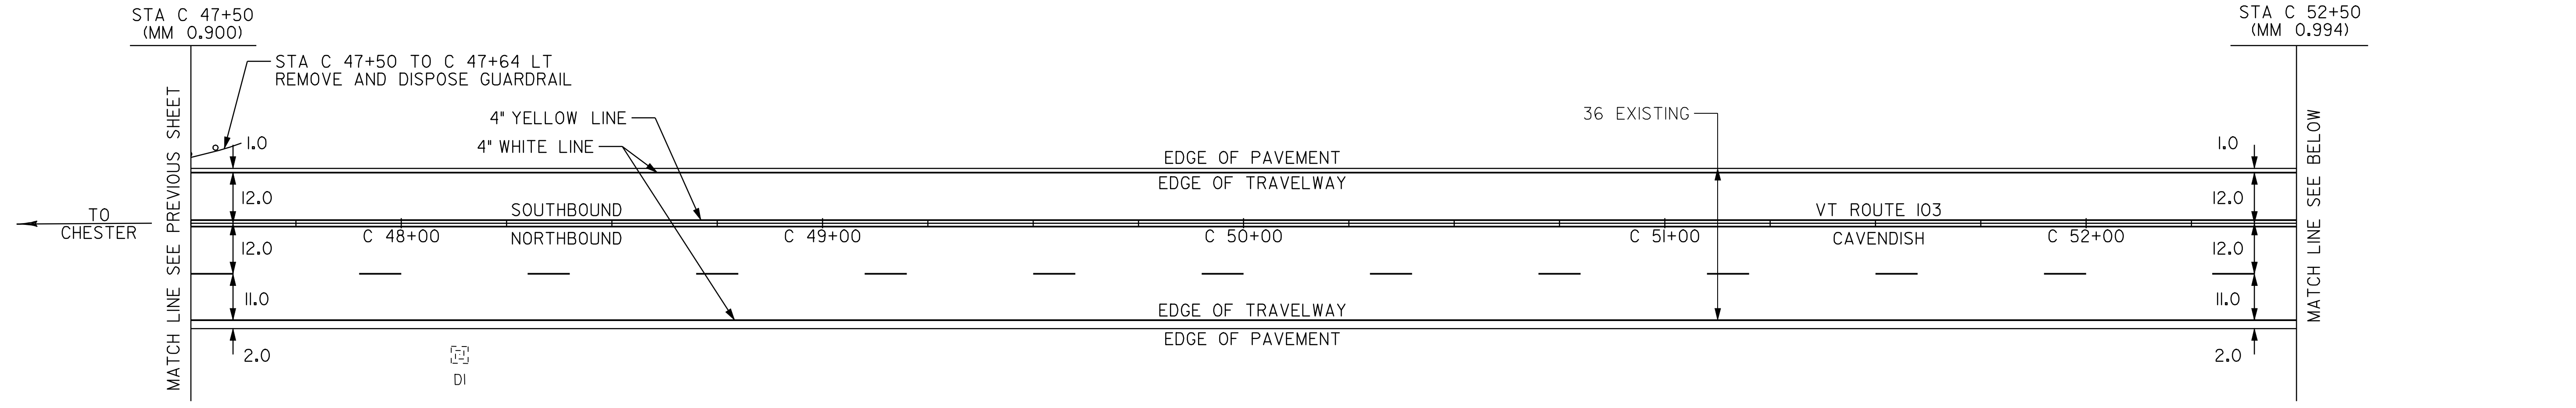

~~STA C 53+26 RT~~
 INSTALL ANCHOR

MTS, FLARED
 STA C 54+51 TO C 54+88 RT

STA C 54+49 TO C 58+00 RT
 REMOVE AND DISPOSE GUARDRAIL

STA C 53+26 TO C 58+00 RT
 INSTALL STEEL BEAM GUARDRAIL,
 GALVANIZED (BURIED END)

LEGEND

- R = REMOVE EXISTING
- S = SALVAGE
- R&S = REMOVE AND SALVAGE
- N = NEW
- RET = RETAIN
- B-B = BACK TO BACK
- = NEW RAIL
- = EXISTING RAIL

**PAVING
 PROJECT
 LAYOUT #34**

PROJECT:	PROJECT NO.:
__CHESTER-LUDLOW	__NH_2326(I)S__
DESIGN FILE NAME: Z:\pave\01b\038\pb038.dgn	PLOT DATE: 16-OCT-2009 17:
IPARM FILE NAME: pb0381a34.i	SURVEY DATE: 01/05
SURVEYED BY: CLD_ENGINEERS, INC	DRAWN BY: MRS
SQUAD LEADER: CRB	SHEET: 48 OF 110
CLD_04-0396	