

TEMPORARY 4" WHITE LINE, PAINT
 DURABLE 4" WHITE LINE, THERMOPLASTIC
 STA C 68+00 TO C 69+30 DASHED RT (LANE)
 STA C 68+00 TO C 72+36 SOLID LT
 STA C 68+00 TO C 79+00 SOLID RT
 STA C 73+16 TO C 79+00 SOLID LT

TEMPORARY 4" YELLOW LINE, PAINT
 DURABLE 4" YELLOW LINE, THERMOPLASTIC
 STA C 68+00 TO C 72+56 SOLID LT & RT
 STA C 72+96 TO C 79+00 SOLID LT & RT


STEEL BEAM GUARDRAIL, GALVANIZED
 STA C 68+00 TO C 69+44 LT
 STA C 73+44 TO C 79+00 LT

MANUFACTURED TERMINAL SECTION, FLARED
 STA C 69+44.56 LT
 STA C 73+44 LT

REMOVAL AND DISPOSAL OF GUARDRAIL
 STA C 68+00 TO C 69+82 LT
 STA C 73+06 TO C 79+00 LT

REMOVING SIGNS
 AS SHOWN - 7

ERECTING SALVAGED SIGNS
 AS SHOWN - 1

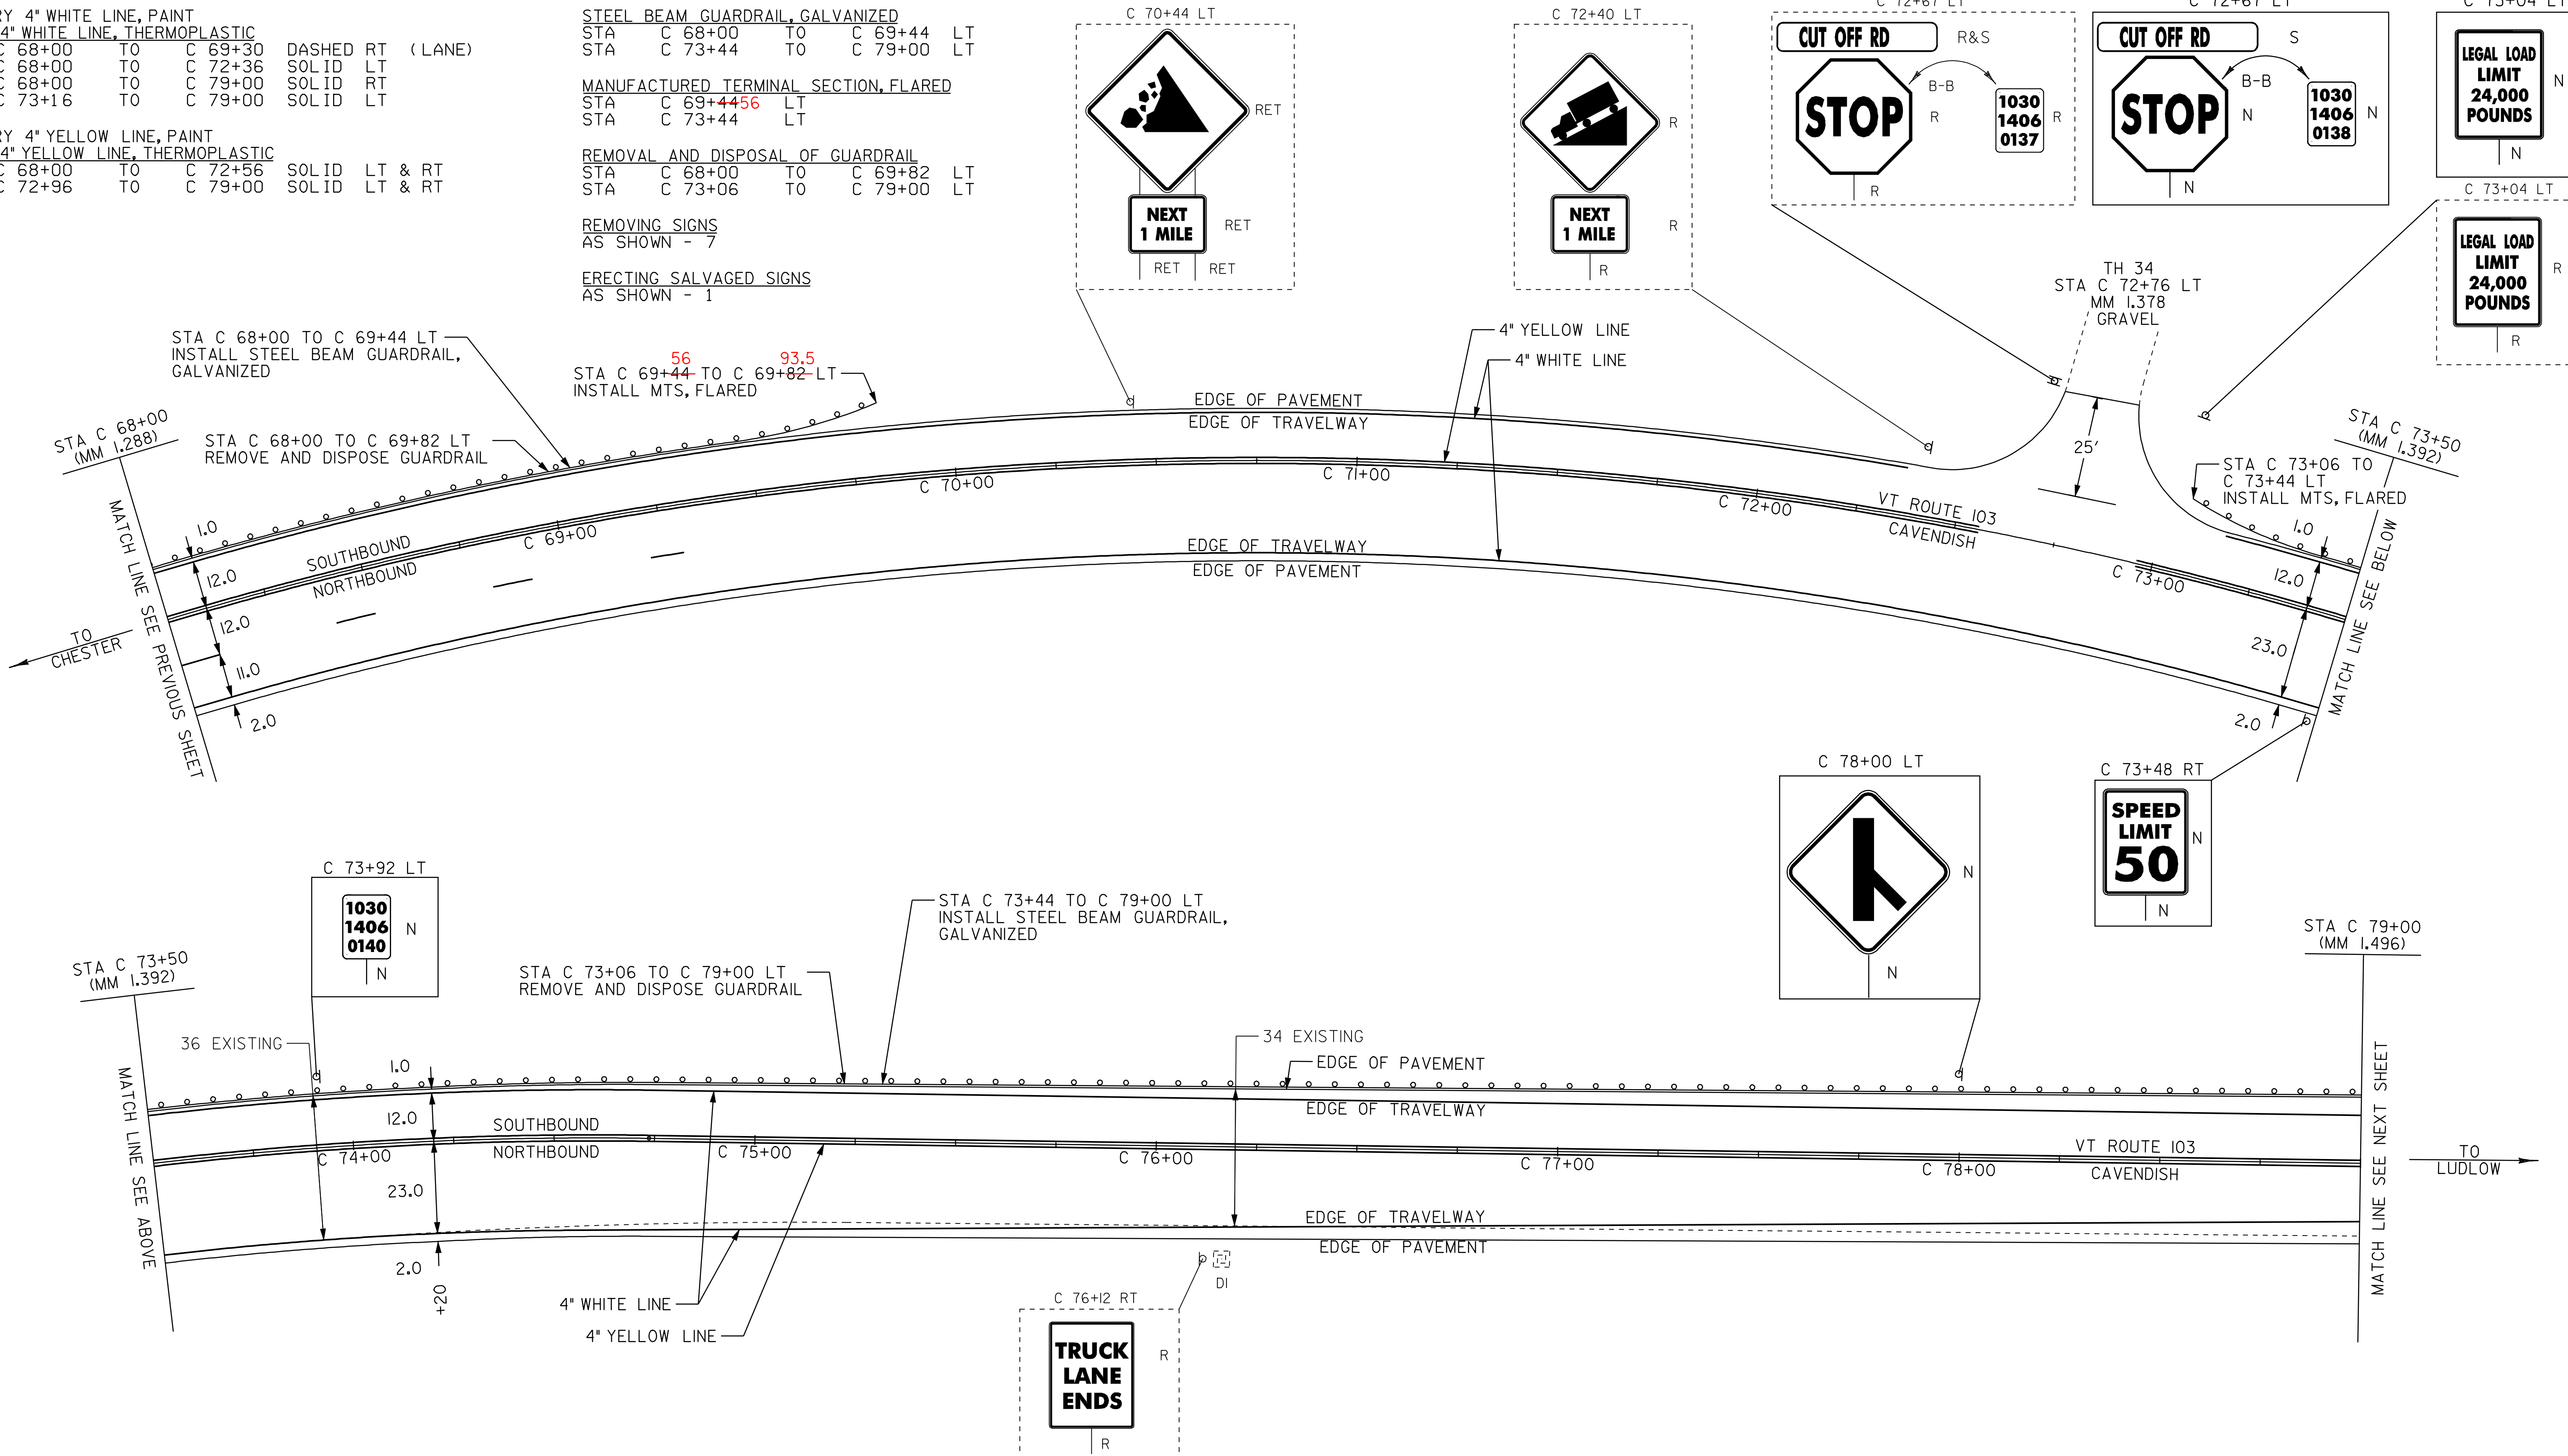

- LEGEND**
- R = REMOVE EXISTING
 - S = SALVAGE
 - R&S = REMOVE AND SALVAGE
 - N = NEW
 - RET = RETAIN
 - B-B = BACK TO BACK
 - = NEW RAIL
 - — — = EXISTING RAIL

PAVING PROJECT LAYOUT #36	PROJECT: CHESTER-LUDLOW	PROJECT NO.: NH 2326(1)S
	DESIGN FILE NAME: \pave\01b038\pb038.dgn	PLOT DATE: 16-OCT-2009 17:05
	IPARM FILE NAME: pb0381a36.i	SURVEY DATE: 01/05/09
	SURVEYED BY: CLD_ENGINEERS, INC	DRAWN BY: MRS
SQUAD LEADER: CRB	SHEET: 50 OF 110	