

TEMPORARY 4" WHITE LINE, PAINT  
 DURABLE 4" WHITE LINE, THERMOPLASTIC  
 STA C 101+00 TO C 106+50 SOLID LT  
 STA C 101+00 TO C 106+50 SOLID RT

TEMPORARY 4" YELLOW LINE, PAINT  
 DURABLE 4" YELLOW LINE, THERMOPLASTIC  
 STA C 101+00 TO C 106+50 SOLID LT & RT


STEEL BEAM GUARDRAIL, GALVANIZED  
 STA C 101+02<sup>03</sup> TO C 106+50 LT  
 STA C 105+57 TO C 106+32 RT

MANUFACTURED TERMINAL SECTION, FLARED  
 STA C 101+02<sup>03</sup> LT  
 STA C 105+57 RT

ANCHOR FOR STEEL BEAM RAIL  
 STA C 106+07 RT

REMOVING SIGNS  
 AS SHOWN - 3

REMOVAL AND DISPOSAL OF GUARDRAIL  
 STA C 101+00 TO C 103+64 LT  
 STA C 105+20 TO C 106+30 RT  
 STA C 105+28 TO C 106+50 LT

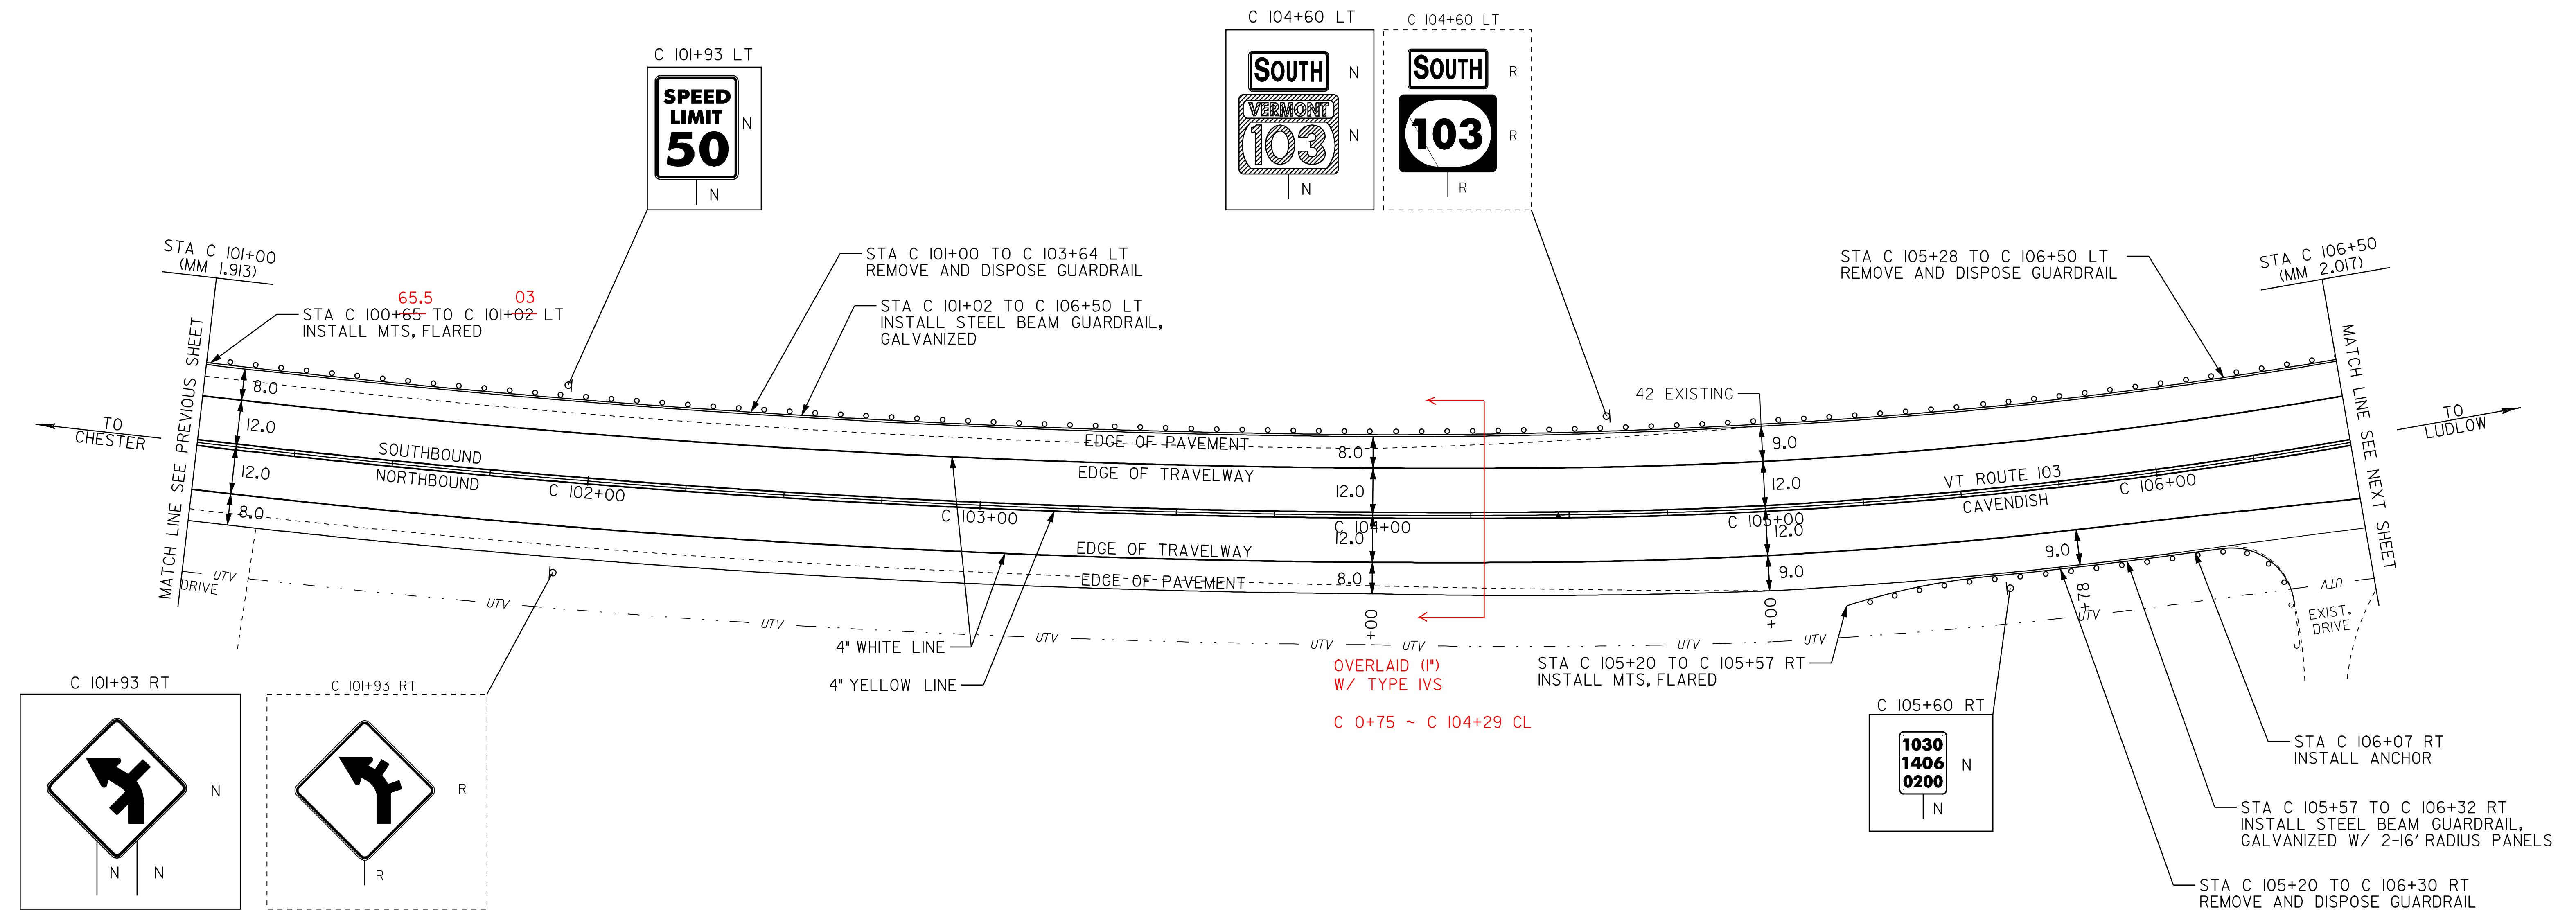

OVERLAID (I")  
 W/ TYPE IVS  
 C 0+75 ~ C 104+29 CL

- LEGEND**
- R = REMOVE EXISTING
  - S = SALVAGE
  - R&S = REMOVE AND SALVAGE
  - N = NEW
  - RET = RETAIN
  - B-B = BACK TO BACK
  - = NEW RAIL
  - = EXISTING RAIL

<b>PAVING PROJECT LAYOUT #39</b>	PROJECT: CHESTER-LUDLOW	PROJECT NO.: NH 2326(I)S
	DESIGN FILE NAME: Z:\pave\01b\038\pb038.dgn	PLOT DATE: 16-OCT-2009 17:
	IPARM FILE NAME: pb0381a39.1	SURVEY DATE: 01/05
	SURVEYED BY: CLD_ENGINEERS, INC	DRAWN BY: MRS
	SQUAD LEADER: CRB	
	CLD 04-0396	SHEET: 53 OF 110