

TEMPORARY 4" WHITE LINE, PAINT  
DURABLE 4" WHITE LINE, THERMOPLASTIC

STA	C 122+50	TO	C 123+26	SOLID	RT
STA	C 122+50	TO	C 123+58	SOLID	LT
STA	C 123+56	TO	C 133+50	SOLID	RT
STA	C 123+82	TO	C 133+50	SOLID	LT

TEMPORARY 4" YELLOW LINE, PAINT  
DURABLE 4" YELLOW LINE, THERMOPLASTIC













STA	C 122+50	TO	C 123+28	SOLID	LT & RT
STA	C 123+48	TO	C 123+70	DOUBLE	RT (TH 48)
STA	C 123+70	TO	C 123+70	DOUBLE	LT (TH 48)
STA	C 123+90	TO	C 124+30	SOLID	LT & RT
STA	C 124+30	TO	C 128+30	SOLID	LT, DASHED
STA	C 128+30	TO	C 133+50	DASHED	

TEMPORARY 24" STOP BAR, PAINT  
DURABLE 24" STOP BAR, THERMOPLASTIC

STA	C 123+48	RT	(TH 48)
STA	C 123+70	LT	(TH 48)

TEMPORARY LETTER OR SYMBOL, PAINT  
DURABLE LETTER OR SYMBOL, THERMOPLASTIC

STA	C 123+54	RT	"STOP" (TH 48)
STA	C 123+64	LT	"STOP" (TH 48)

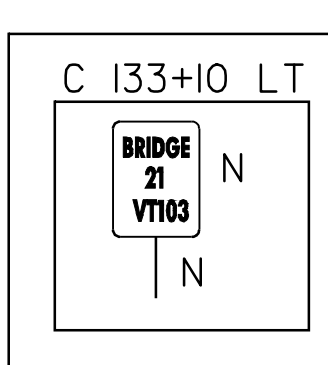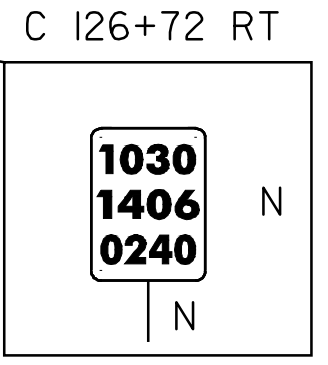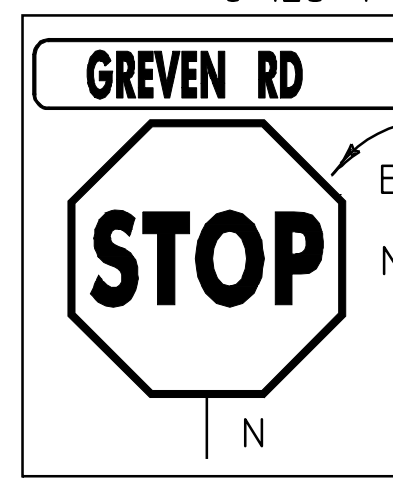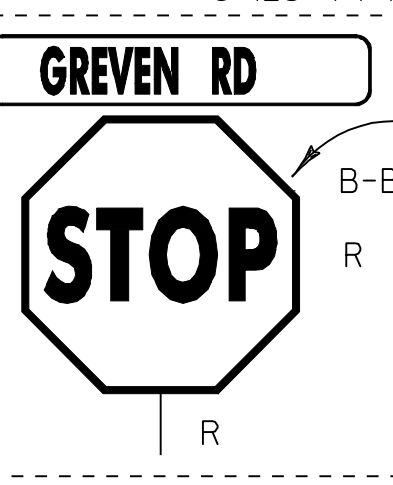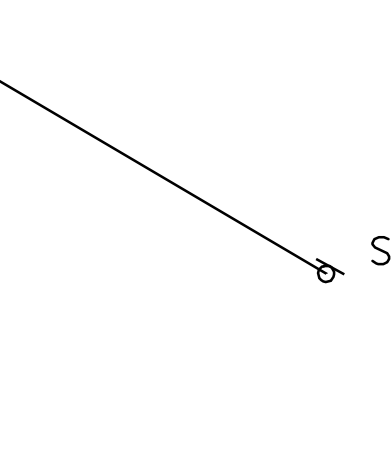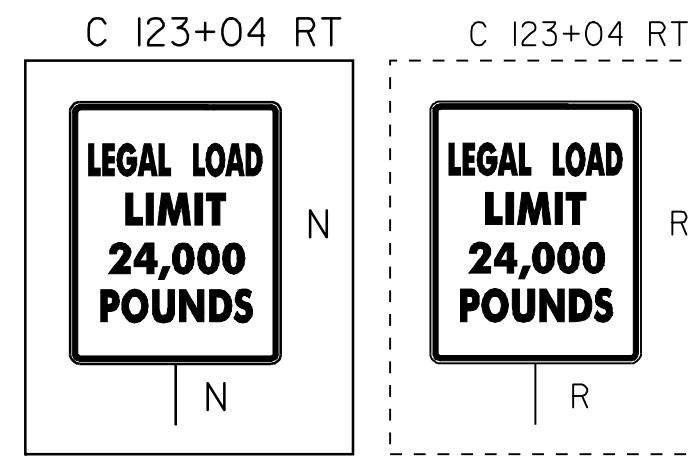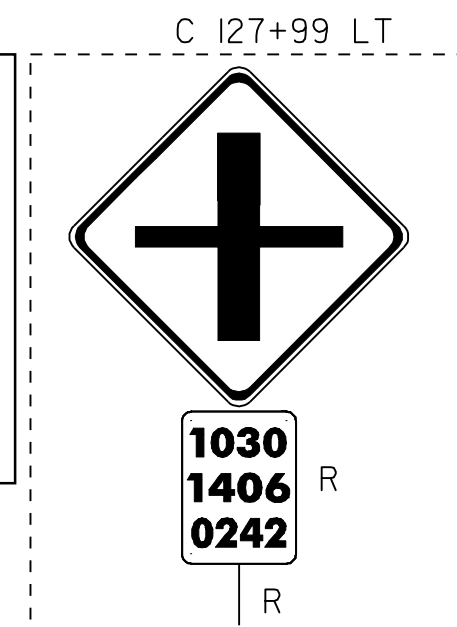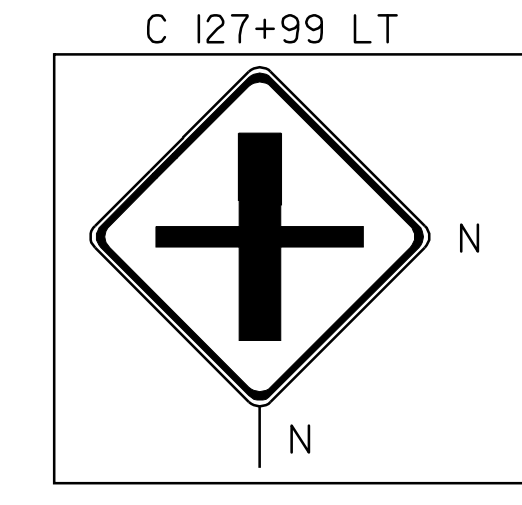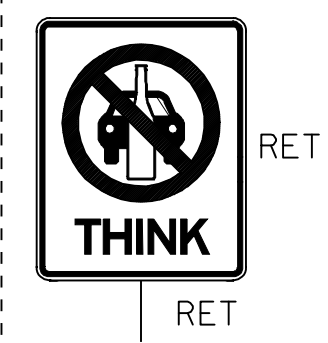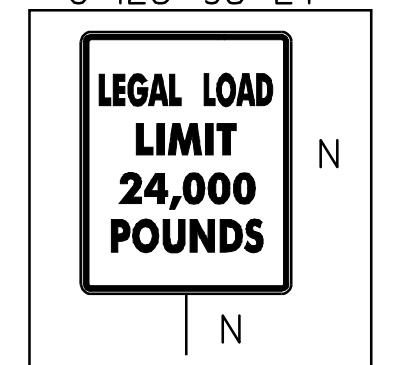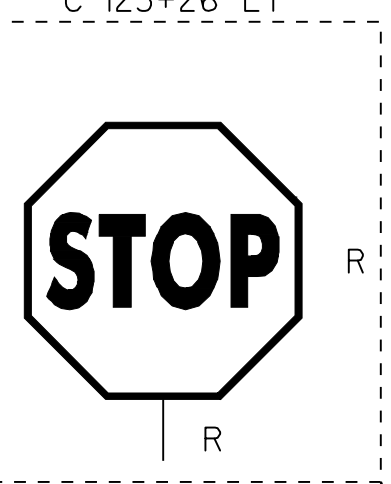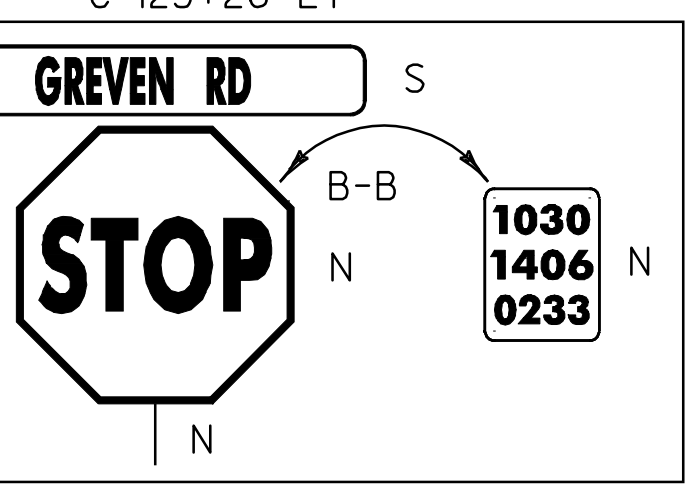

STEEL BEAM GUARDRAIL, GALVANIZED

STA	C 129+95	TO	C 131+20	LT
STA	C 129+95	TO	C 130+82	RT
STA	C 133+17	TO	C 133+50	RT

GUARDRAIL APPROACH SECTION, GALVANIZED TYPE I

STA	C 130+82	TO	C 131+32	RT
STA	C 133+04	TO	C 133+50	LT

GUARDRAIL APPROACH SECTION, GALVANIZED TYPE II

STA	C 131+20	TO	C 131+32	LT
STA	C 133+04	TO	C 133+17	RT

MANUFACTURED TERMINAL SECTION, FLARED

STA	C 129+95	LT
STA	C 129+95	RT

REMOVAL AND DISPOSAL OF GUARDRAIL

STA	C 129+62	TO	C 131+32	LT
STA	C 129+62	TO	C 131+32	RT
STA	C 133+04	TO	C 133+50	LT
STA	C 133+04	TO	C 133+50	RT

REMOVING SIGNS AS SHOWN - 14

ERECTING SALVAGED SIGNS AS SHOWN - 2

LEGEND

- R = REMOVE EXISTING
- S = SALVAGE
- R&S = REMOVE AND SALVAGE
- N = NEW
- RET = RETAIN
- B-B = BACK TO BACK
- = NEW RAIL
- = EXISTING RAIL

**PAVING PROJECT LAYOUT #42**

PROJECT: CHESTER-LUDLOW	PROJECT NO.: NH 2326(1)S
DESIGN FILE NAME: Z:\pave\01b038\pb038.dgn	PLOT DATE: 16-OCT-2009 17:
IPARM FILE NAME: pb0381a42.1	SURVEY DATE: 01/05
SURVEYED BY: CLD_ENGINEERS, INC	DRAWN BY: MRS
SQUAD LEADER: CRB	SHEET: 56 OF 110