
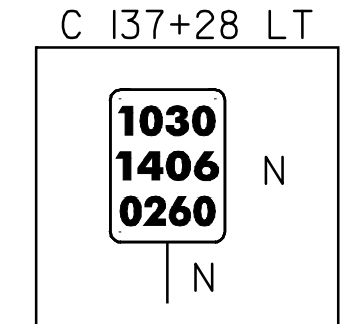
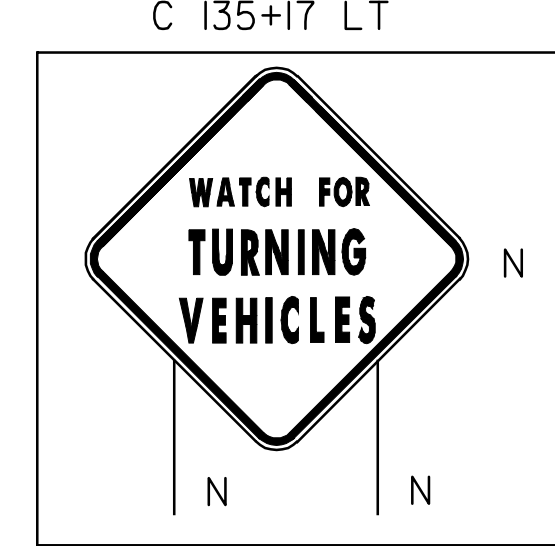


STA C 133+50 TO C 133+54 LT
INSTALL GUARDRAIL APPROACH
SECTION, TYPE I, GALVANIZED

STA C 133+54 TO C 134+42 LT
INSTALL STEEL BEAM GUARDRAIL,
GALVANIZED

STA C 133+50 TO C 134+75 LT
REMOVE AND DISPOSE GUARDRAIL

STA C 133+54 TO C 133+91.5 LT
INSTALL MTS, FLARED

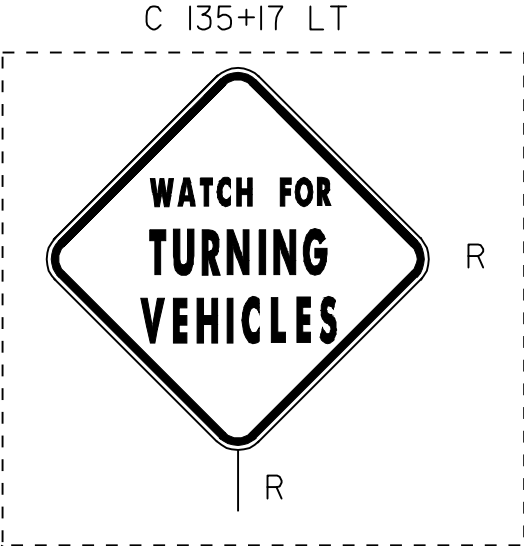

TEMPORARY 4" WHITE LINE, PAINT
DURABLE 4" WHITE LINE, THERMOPLASTIC
STA C 133+50 TO C 143+50 SOLID LT
STA C 133+50 TO C 143+50 SOLID RT

TEMPORARY 4" YELLOW LINE, PAINT
DURABLE 4" YELLOW LINE, THERMOPLASTIC
STA C 133+50 TO C 134+10 DASHED
STA C 134+10 TO C 140+40 DASHED LT, SOLID RT
STA C 140+40 TO C 143+50 SOLID LT & RT


TEMPORARY RAILROAD CROSSING SYMBOL, PAINT
DURABLE RAILROAD CROSSING SYMBOL, THERMOPLASTIC
STA C 141+52 RT

REMOVING SIGNS
AS SHOWN - 9

ERECTING SALVAGED SIGNS
AS SHOWN - 1

ERECTING SALVAGED SIGNS
(NO FED. PART.)
AS SHOWN (TIS) - 2


STA C 138+50
(MM 2.623)

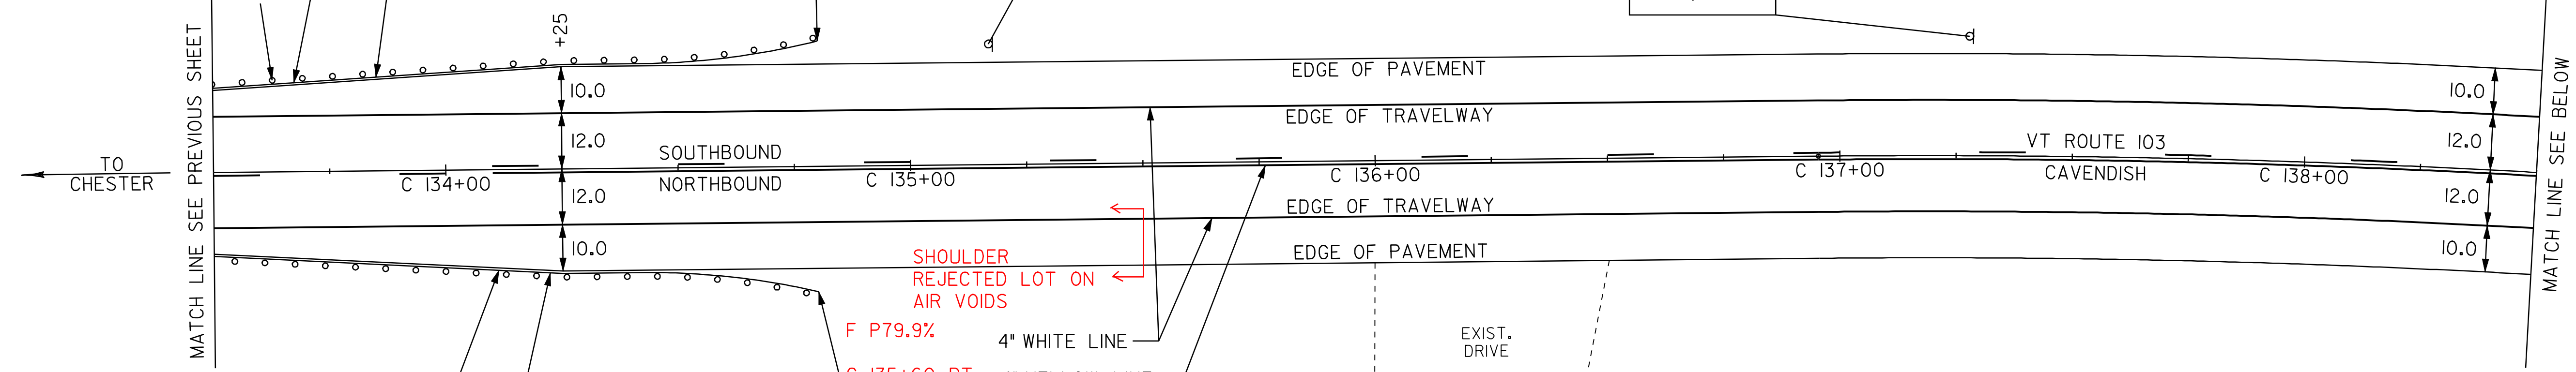

STA C 133+50 TO C 134+75 RT
REMOVE AND DISPOSE GUARDRAIL

STA C 133+50 TO C 134+42 RT
INSTALL STEEL BEAM GUARDRAIL,
GALVANIZED

SHOULDER
REJECTED LOT ON
AIR VOIDS
F P79.9%
C 135+60 RT 4" YELLOW LINE

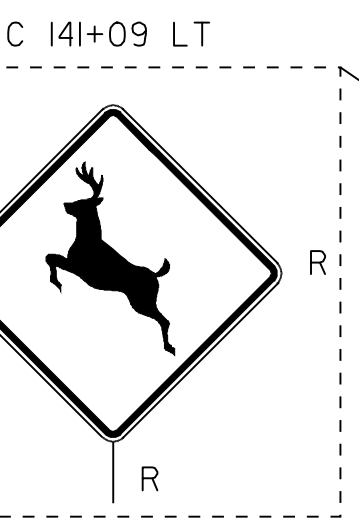

STA C 142+02 TO C 142+14 LT
INSTALL GUARDRAIL APPROACH
SECTION, TYPE II, GALVANIZED
ATTACH TO EXISTING GUARDRAIL

STA C 141+39 TO C 142+02 LT
INSTALL STEEL BEAM GUARDRAIL,
GALVANIZED

STA C 140+97 TO C 142+14 LT
REMOVE AND DISPOSE GUARDRAIL



STA C 142+74 TO C 143+24 LT
INSTALL GUARDRAIL APPROACH
SECTION, TYPE I, GALVANIZED
ATTACH TO EXISTING GUARDRAIL

BRIDGE #21A
STA C 142+02
MM 2.690
COLD PLANE & PAVE

STA C 142+74 TO C 143+50 LT
REMOVE AND DISPOSE GUARDRAIL

STA C 143+24 TO C 143+50 LT
INSTALL STEEL BEAM GUARDRAIL,
GALVANIZED

STA C 143+50
(MM 2.718)

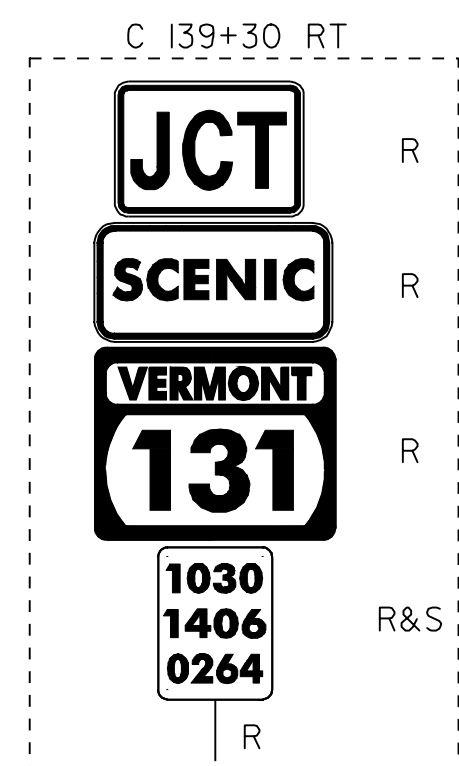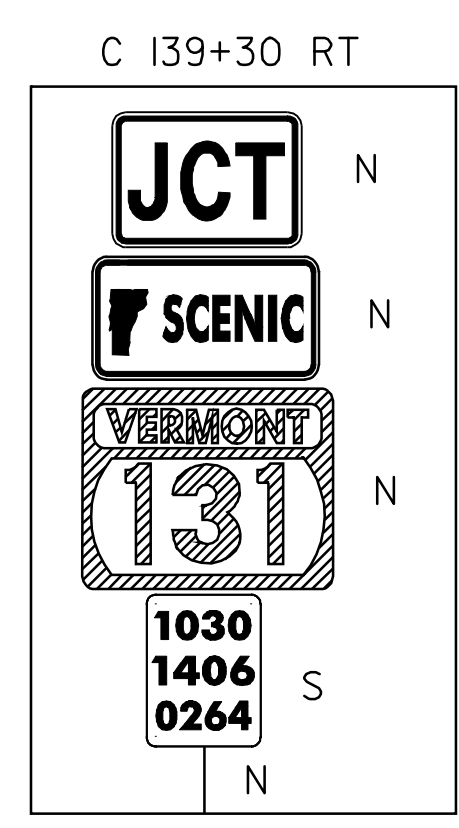

STA C 138+50
(MM 2.623)

4" YELLOW LINE
4" WHITE LINE



STA C 140+89 TO C 141+39 LT
INSTALL MTS, FLARED

STA C 139+00
SOUTHBOUND
NORTHBOUND



STA C 140+06 TO C 140+43 RT
INSTALL MTS, FLARED

STA C 140+08 TO C 141+80 RT
REMOVE AND DISPOSE GUARDRAIL

STA C 140+43 TO C 141+30 RT
INSTALL STEEL BEAM GUARDRAIL,
GALVANIZED

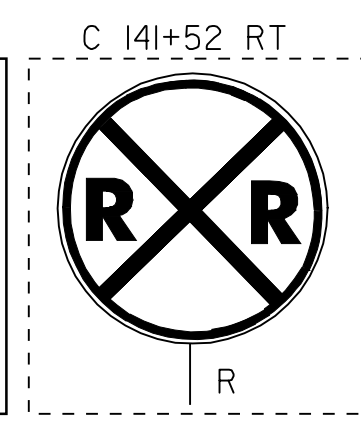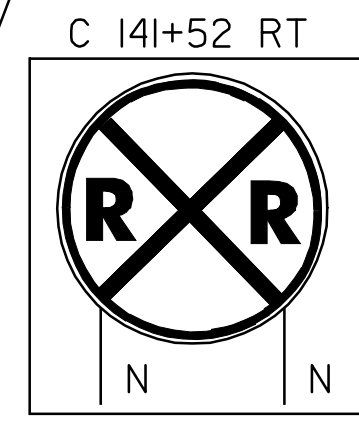

STA C 142+40 TO C 142+53 RT
INSTALL GUARDRAIL APPROACH
SECTION, TYPE II, GALVANIZED
ATTACH TO EXISTING GUARDRAIL

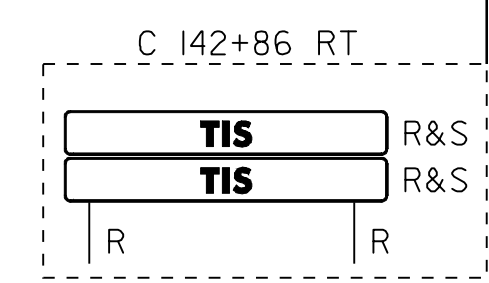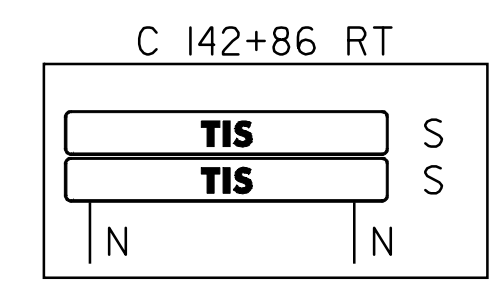

STA C 143+40 TO C 143+50 RT
INSTALL MTS, FLARED

STA C 142+53 TO C 143+40 RT
INSTALL STEEL BEAM GUARDRAIL,
GALVANIZED

STA C 142+40 TO C 143+50 RT
REMOVE AND DISPOSE GUARDRAIL

STEEL BEAM GUARDRAIL, GALVANIZED 54

STA C 133+50	TO	C 134+42	RT
STA C 133+54	TO	C 134+42	LT
STA C 140+43	TO	C 141+30	RT
STA C 141+39-27	TO	C 142+02	LT
STA C 142+53	TO	C 143+40	RT
STA C 143+24	TO	C 143+50	LT

GUARDRAIL APPROACH SECTION, GALVANIZED TYPE I

STA C 133+50	TO	C 133+54	LT
STA C 141+30	TO	C 141+80	RT
STA C 142+74	TO	C 143+24	LT

GUARDRAIL APPROACH SECTION, GALVANIZED TYPE II

STA C 142+02	TO	C 142+14	LT
STA C 142+40	TO	C 142+53	RT

MANUFACTURED TERMINAL SECTION, FLARED

STA C 134+42	LT	C 133+54
STA C 134+42	RT	
STA C 140+43	RT	
STA C 141+39-27	LT	
STA C 143+40	RT	

REMOVAL AND DISPOSAL OF GUARDRAIL

STA C 133+50	TO	C 134+75	LT
STA C 133+50	TO	C 134+75	RT
STA C 140+08	TO	C 141+80	RT
STA C 140+97	TO	C 142+14	LT
STA C 142+40	TO	C 143+50	RT
STA C 142+74	TO	C 143+50	LT

STA C 141+30 TO C 141+80 RT
INSTALL GUARDRAIL APPROACH
SECTION, TYPE I, GALVANIZED
ATTACH TO EXISTING GUARDRAIL

LEGEND

- R = REMOVE EXISTING
- S = SALVAGE
- R&S = REMOVE AND SALVAGE
- N = NEW
- RET = RETAIN
- B-B = BACK TO BACK
- = NEW RAIL
- - - = EXISTING RAIL

**PAVING
PROJECT
LAYOUT #43**

PROJECT: _CHESTER-LUDLOW	PROJECT NO.: _NH_2326(I)S_
DESIGN FILE NAME: Zpave\Qlb038\pb038.dgn	PLOT DATE: 16-OCT-2009 17:
IPARM FILE NAME: pb0381a43.1	SURVEY DATE: Q1205
SURVEYED BY: CLD_ENGINEERS, INC	SQUAD LEADER: CRB
DRAWN BY: MRS	SHEET: 57 OF 107