

TEMPORARY 4" WHITE LINE, PAINT  
 DURABLE 4" WHITE LINE, THERMOPLASTIC  
 STA C 143+50 TO C 148+50 SOLID LT  
 STA C 143+50 TO C 148+50 SOLID RT

TEMPORARY 4" YELLOW LINE, PAINT  
 DURABLE 4" YELLOW LINE, THERMOPLASTIC  
 STA C 143+50 TO C 148+50 SOLID LT & RT


STEEL BEAM GUARDRAIL, GALVANIZED  
 STA C 143+50 TO C 147+12 LT  
 STA C 143+50 TO C 147+12 LT

MANUFACTURED TERMINAL SECTION, FLARED  
 STA C 147+12 LT

REMOVAL AND DISPOSAL OF GUARDRAIL  
 STA C 143+50 TO C 143+71 RT  
 STA C 143+50 TO C 147+45 LT

REMOVING SIGNS  
 AS SHOWN - 6

TEMPORARY & DURABLE 24" STOP BAR  
 STA C 147+64 RT

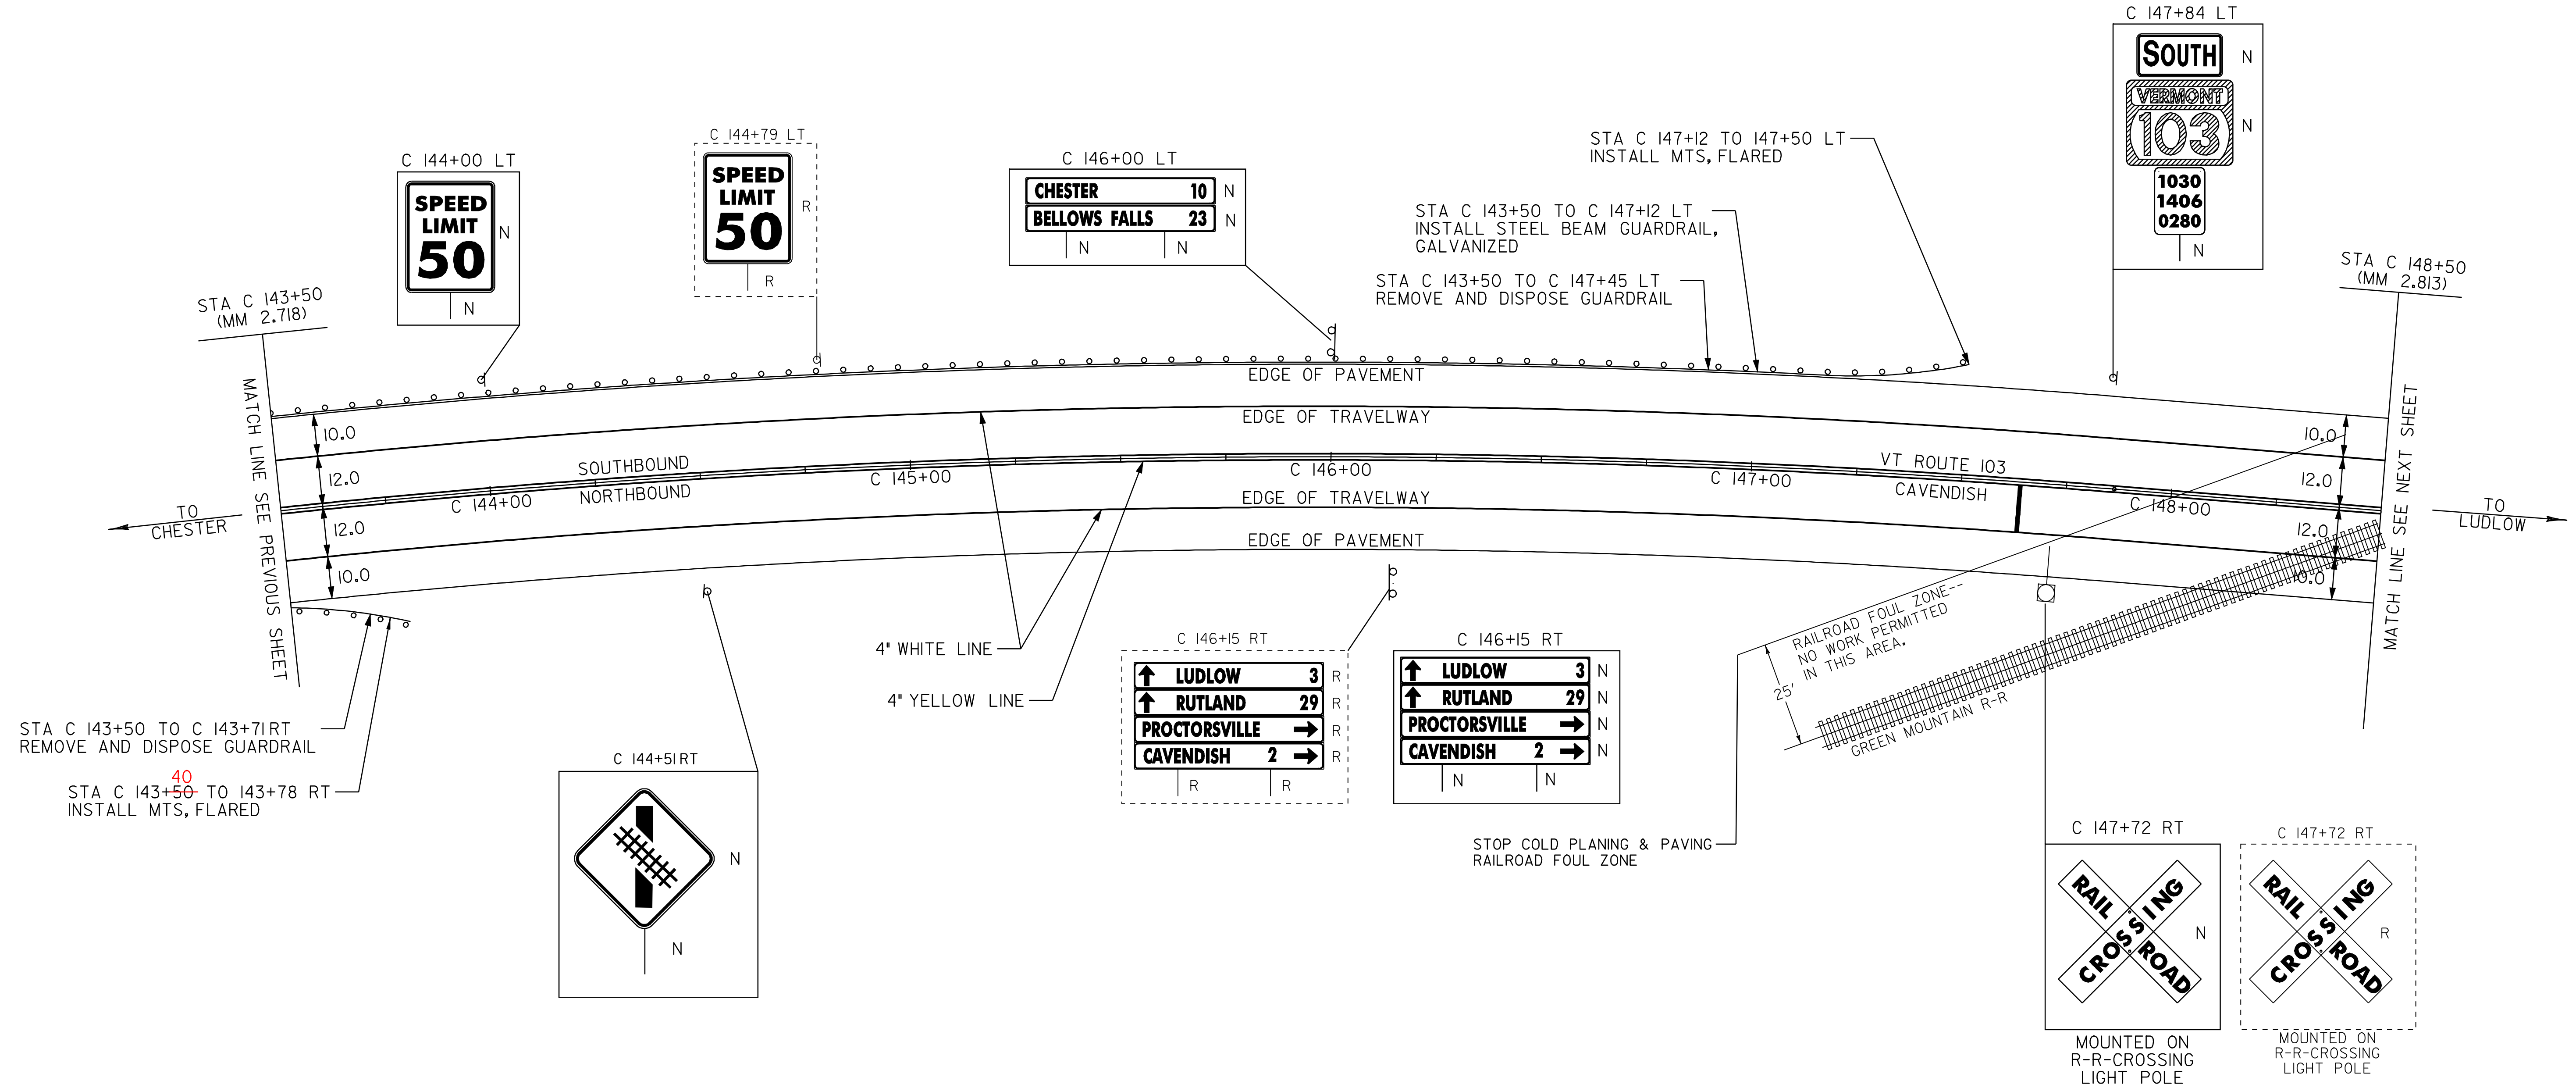

**LEGEND**

R = REMOVE EXISTING  
 S = SALVAGE  
 R&S = REMOVE AND SALVAGE  
 N = NEW  
 RET = RETAIN  
 B-B = BACK TO BACK  
 —○— = NEW RAIL  
 - - - = EXISTING RAIL

<b>PAVING PROJECT LAYOUT #44</b>	PROJECT: CHESTER-LUDLOW	PROJECT NO.: NH 2326(I)S
	DESIGN FILE NAME: Z:\pave\01b038\pb038.dgn	PLOT DATE: 16-OCT-2009 17:
	IPARM FILE NAME: pb0381a44.i	SURVEY DATE: 01/05
	SQUAD LEADER: CLD_ENGINEERS, INC	DRAWN BY: MRS
	CLD 04-0396	SHEET: 58 OF 110