

TEMPORARY 4" WHITE LINE, PAINT
 DURABLE 4" WHITE LINE, THERMOPLASTIC
 STA C 173+50 TO C 174+42 SOLID LT
 STA C 173+50 TO C 184+50 SOLID RT
 STA C 174+64 TO C 184+50 SOLID LT

TEMPORARY 4" YELLOW LINE, PAINT
 DURABLE 4" YELLOW LINE, THERMOPLASTIC
 STA C 173+50 TO C 173+95 DASHED LT, SOLID RT
 STA C 173+95 TO C 174+33 SOLID LT & RT
 STA C 174+53 DOUBLE SOLID LT (TH 45)
 STA C 174+73 TO C 179+50 SOLID LT & RT
 STA C 179+50 TO C 184+50 SOLID LT, DASHED RT

TEMPORARY 24" STOP BAR, PAINT
 DURABLE 24" STOP BAR, THERMOPLASTIC
 STA C 174+53 LT (TH 45)

TEMPORARY LETTER OR SYMBOL, PAINT
 DURABLE LETTER OR SYMBOL, THERMOPLASTIC
 STA C 174+47 LT - "STOP" (TH 45)

STEEL BEAM GUARDRAIL, GALVANIZED
 STA C 174+66 TO C 182+00 LT



MANUFACTURED TERMINAL SECTION, FLARED
 STA C 182+00 LT

REMOVAL AND DISPOSAL OF GUARDRAIL
 STA C 174+66 TO C 182+13 LT

REMOVING SIGNS
 AS SHOWN - 4

ERECTING SALVAGED SIGNS
 AS SHOWN - 1

ANCHOR FOR STEEL BEAM RAIL
 174+96 LT

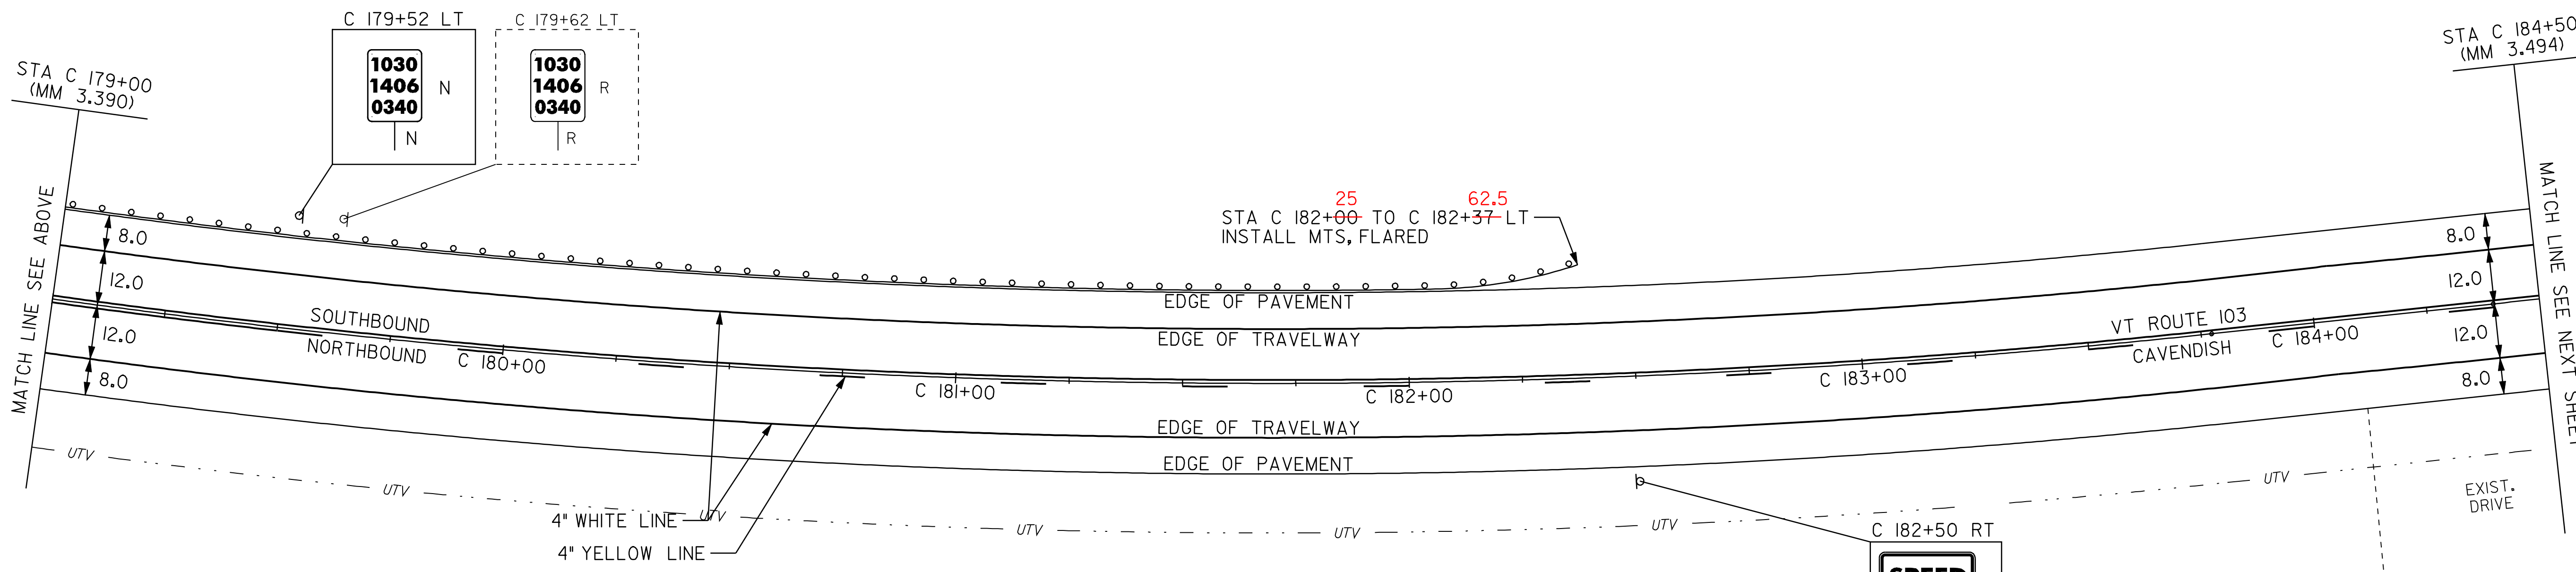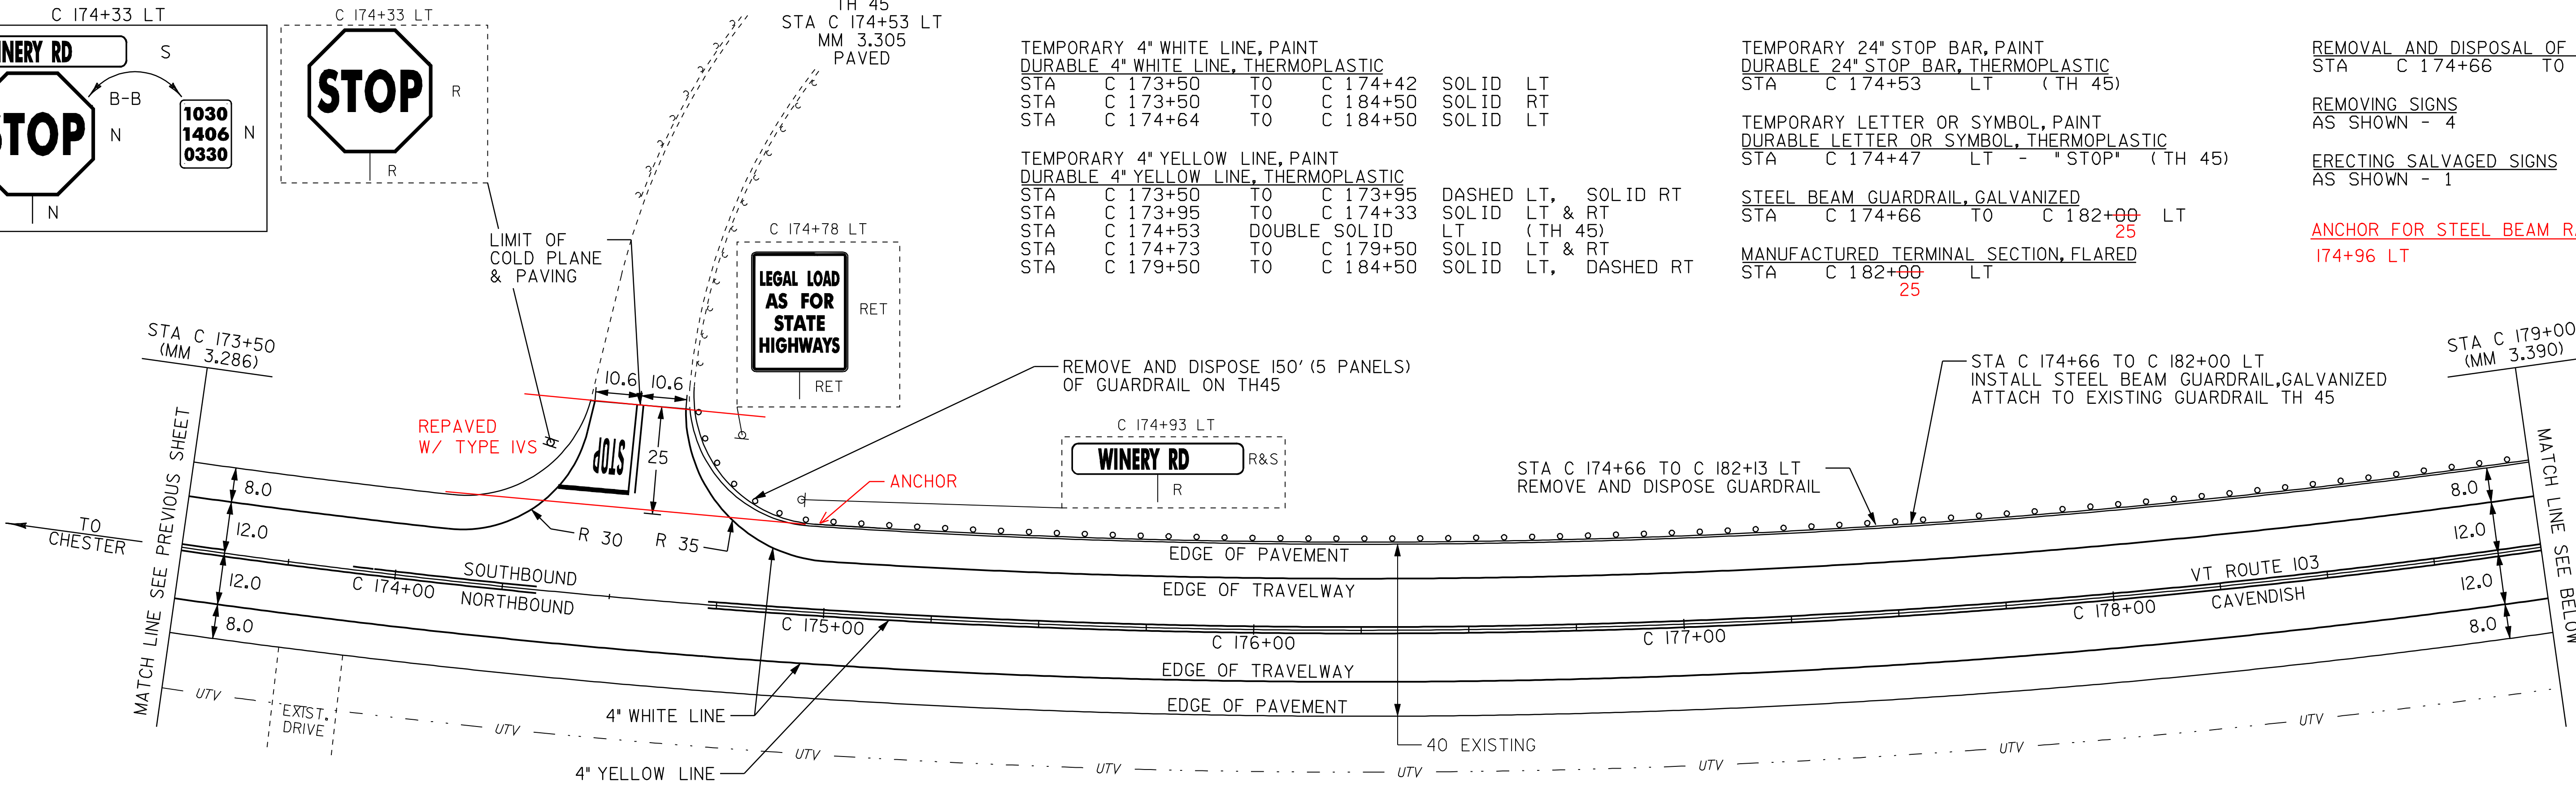

- LEGEND
- R = REMOVE EXISTING
 - S = SALVAGE
 - R&S = REMOVE AND SALVAGE
 - N = NEW
 - RET = RETAIN
 - B-B = BACK TO BACK
 - = NEW RAIL
 - — — = EXISTING RAIL

PAVING PROJECT LAYOUT #48

PROJECT: CHESTER-LUDLOW	PROJECT NO.: NH 2326(I)S
DESIGN FILE NAME: Z:\pave\01b038\pb038.dgn	PLOT DATE: 16-OCT-2009 17:
IPARM FILE NAME: pb0381a48.1	SURVEY DATE: 01/05
SURVEYED BY: CLD_ENGINEERS, INC	SQUAD LEADER: CRB
DRAWN BY: MRS	SHEET: 62 OF 110