

TEMPORARY 4" WHITE LINE, PAINT  
 DURABLE 4" WHITE LINE, THERMOPLASTIC  
 STA L 9+50 TO L 11+48 SOLID RT  
 STA L 9+50 TO L 16+69 SOLID LT  
 STA L 11+68 TO L 20+50 SOLID RT  
 STA L 16+91 TO L 20+50 SOLID LT

TEMPORARY 4" YELLOW LINE, PAINT  
 DURABLE 4" YELLOW LINE, THERMOPLASTIC  
 STA L 9+50 TO L 11+36 SOLID LT & RT  
 STA L 11+57 DOUBLE SOLID RT (TH 70)  
 STA L 11+76 TO L 16+60 SOLID LT & RT  
 STA L 16+78 DOUBLE SOLID LT (TH 29)  
 STA L 17+00 TO L 20+50 SOLID LT & RT

TEMPORARY 24" STOP BAR, PAINT  
 DURABLE 24" STOP BAR, THERMOPLASTIC  
 STA L 11+57 RT (TH 70)  
 STA L 16+78 LT (TH 29)


TEMPORARY LETTER OR SYMBOL, PAINT  
 DURABLE LETTER OR SYMBOL, THERMOPLASTIC  
 STA L 11+64 RT - "STOP" (TH 70)  
 STA L 16+71 LT - "STOP" (TH 29)

REMOVING SIGNS  
 AS SHOWN - 6

ERECTING SALVAGED SIGNS  
 AS SHOWN - 3

**ANCHOR FOR STEEL BEAM RAIL**  
 STA L 13+36 LT  
 STA L 16+60 LT

**STEEL BEAM GUARDRAIL, GALVINIZED**  
 L 13+35 ~ L 16+60 LT 8' POSTS

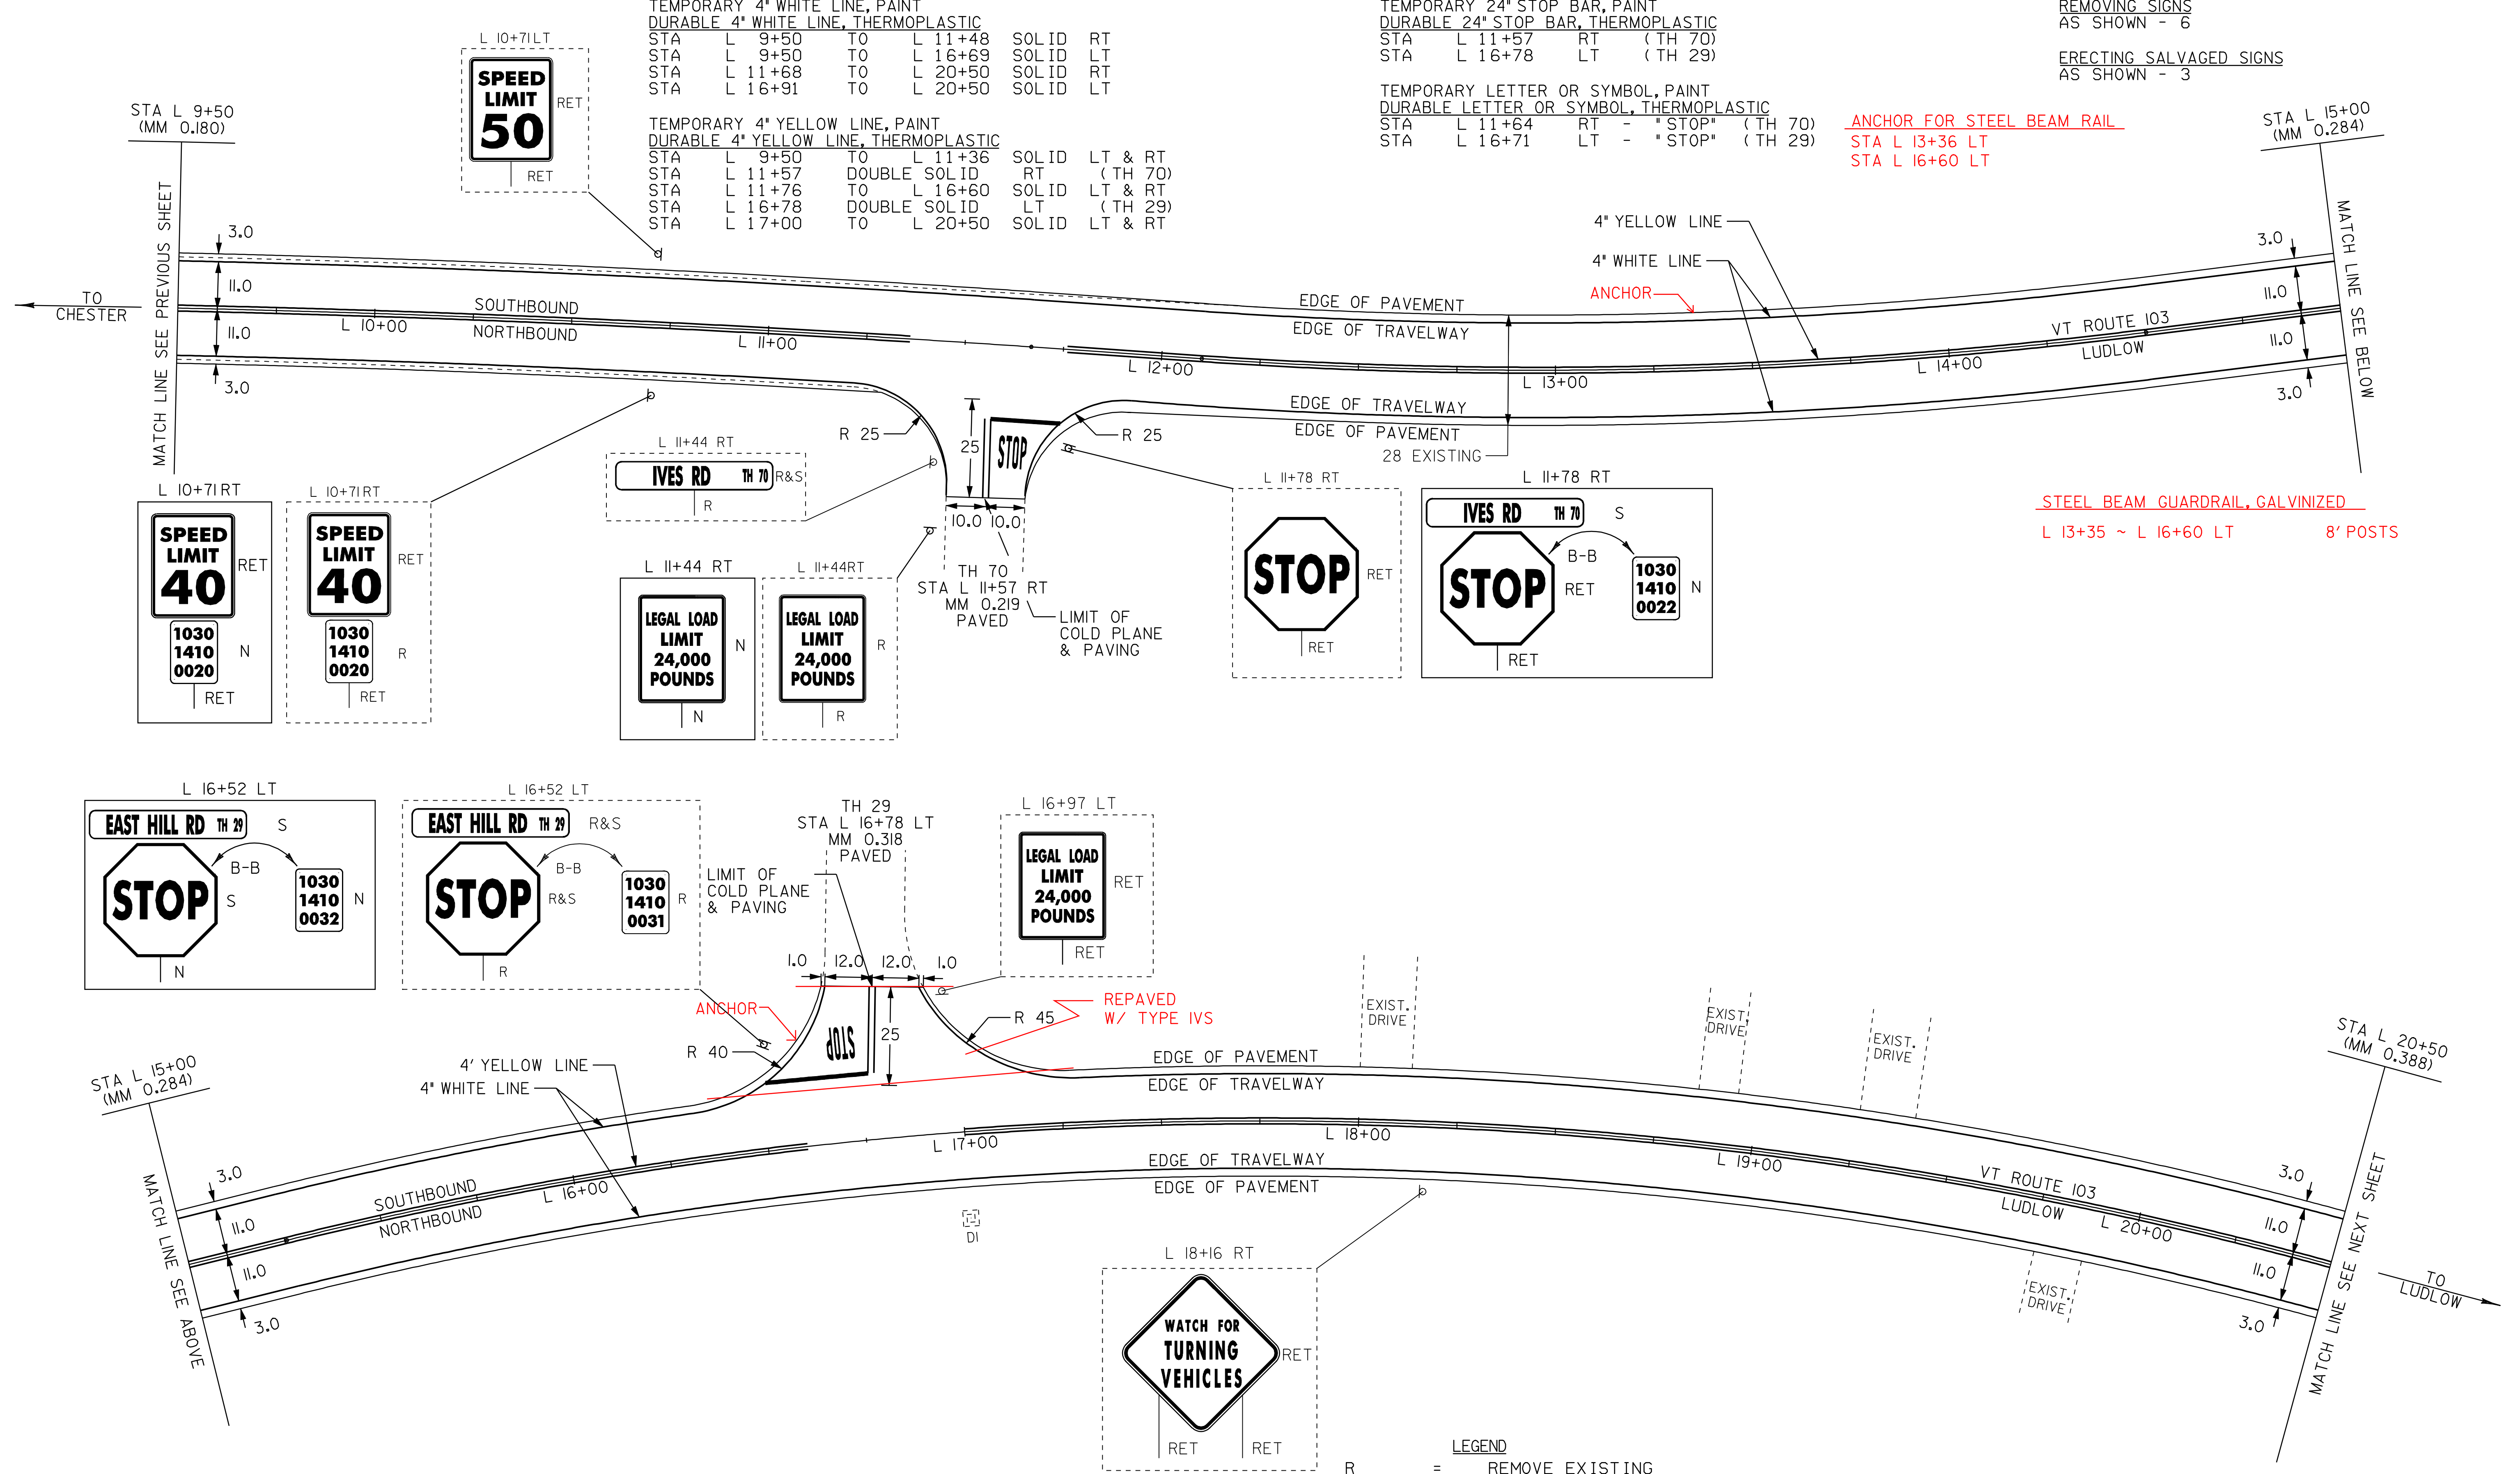

- LEGEND**
- R = REMOVE EXISTING
  - S = SALVAGE
  - R&S = REMOVE AND SALVAGE
  - N = NEW
  - RET = RETAIN
  - B-B = BACK TO BACK
  - = NEW RAIL
  - - - = EXISTING RAIL

<b>PAVING PROJECT LAYOUT #51</b>	PROJECT: CHESTER-LUDLOW	PROJECT NO.: NH 2326(1)S
	DESIGN FILE NAME: Zpave\Q1bQ38\pbQ38.dgn	PLOT DATE: 16-OCT-2009 17:00
	IPARM FILE NAME: pb0381a51.i	SURVEY DATE: Q1205
	SURVEYED BY: CLD_ENGINEERS, INC	DRAWN BY: MRS
SQUAD LEADER: CRB	SHEET: 65 OF 110	