


TEMPORARY 4" WHITE LINE, PAINT
 DURABLE 4" WHITE LINE, THERMOPLASTIC
 STA L 64+00 TO L 68+60 SOLID LT
 STA L 64+00 TO L 68+60 SOLID RT

REMOVING SIGNS
 AS SHOWN - 1

TEMPORARY 4" YELLOW LINE, PAINT
 DURABLE 4" YELLOW LINE, THERMOPLASTIC
 STA L 64+00 TO L 68+60 SOLID LT & RT

VT ROUTE 103
STA L 68+60.00
(MM 1.299)
END PROJECT
NH 2326(1)S

LIMIT OF OVERLAY 2'
 END OVERLAY

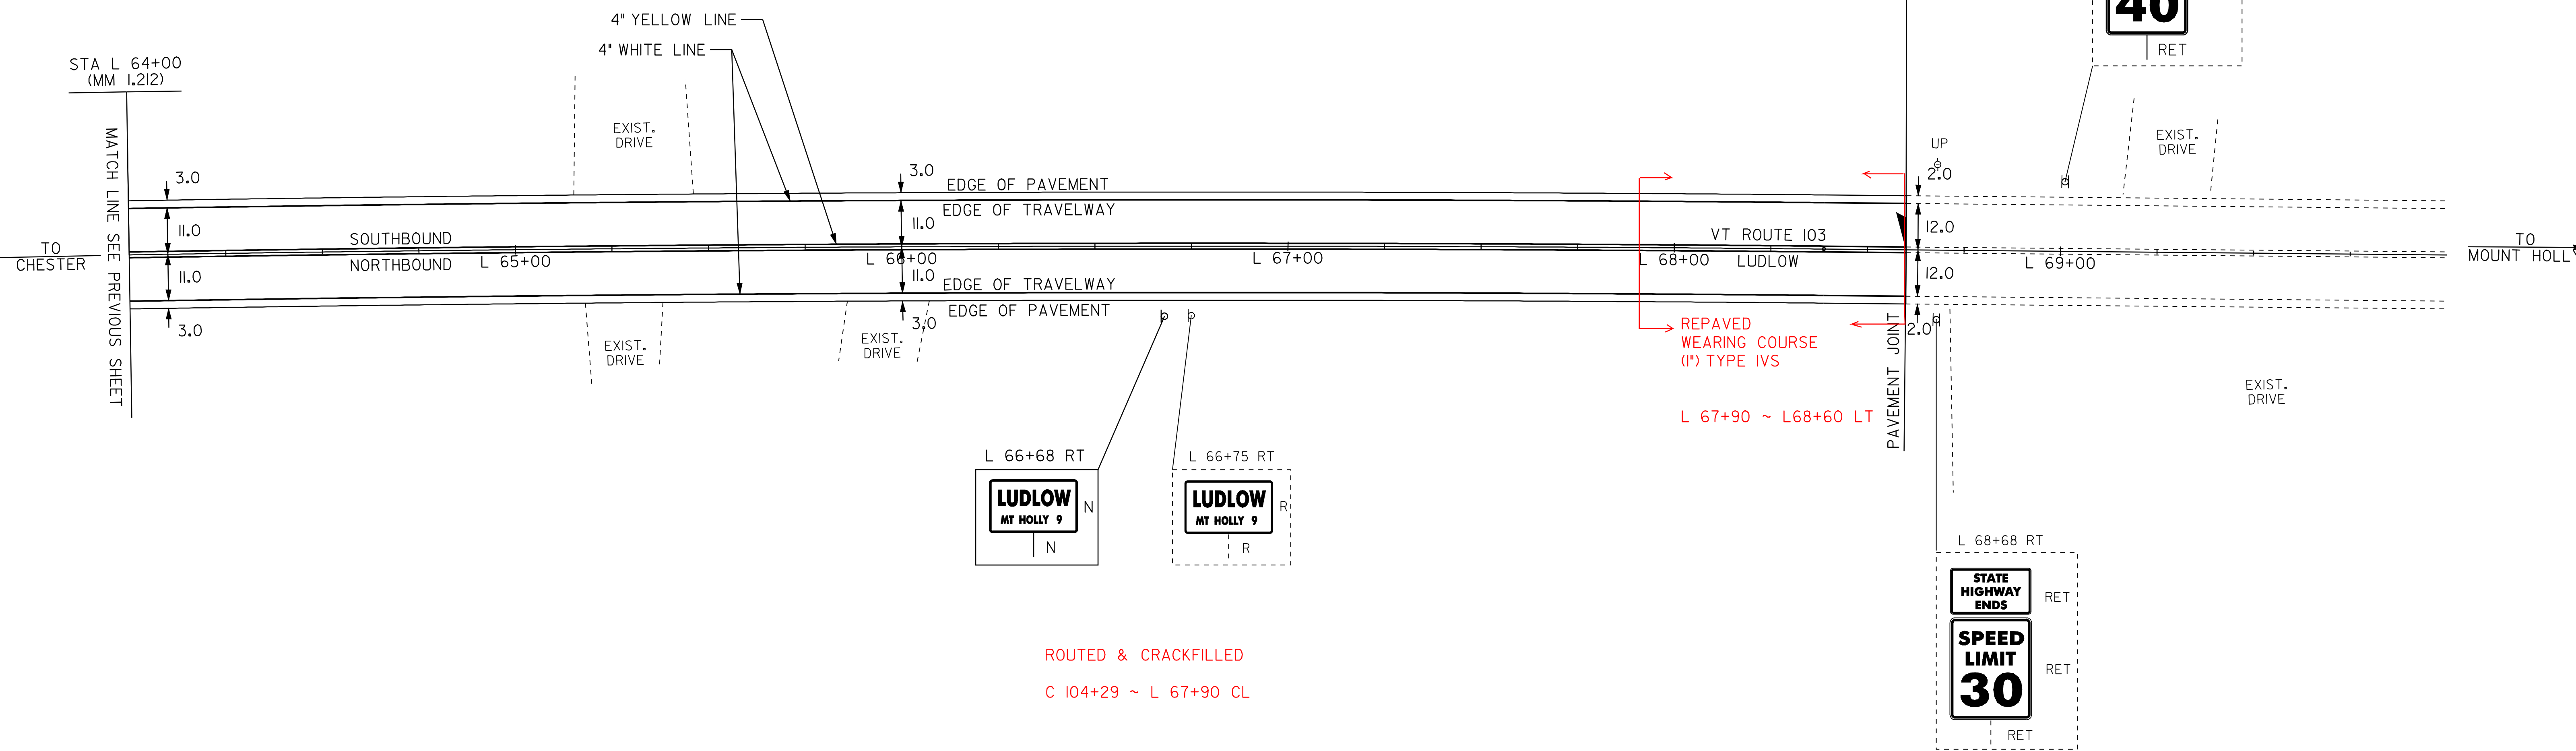

ROUTED & CRACKFILLED
 C 104+29 ~ L 67+90 CL

LEGEND

- R = REMOVE EXISTING
- S = SALVAGE
- R&S = REMOVE AND SALVAGE
- N = NEW
- RET = RETAIN
- B-B = BACK TO BACK
- = NEW RAIL
- = EXISTING RAIL

PAVING PROJECT LAYOUT #56

PROJECT:	<u>CHESTER-LUDLOW</u>	PROJECT NO.:	<u>NH 2326(1)S</u>
DESIGN FILE NAME:	<u>Z:\pave\01b038\pb038.dgn</u>	PLOT DATE:	<u>16-OCT-2009 17:</u>
IPARM FILE NAME:	<u>pb0381a56.i</u>	SURVEY DATE:	<u>01/05</u>
SURVEYED BY:	<u>CLD_ENGINEERS, INC</u>	DRAWN BY:	<u>MRS</u>
SQUAD LEADER:	<u>CRB</u>	SHEET:	<u>70 OF 110</u>
<u>CLD 04-0396</u>			