
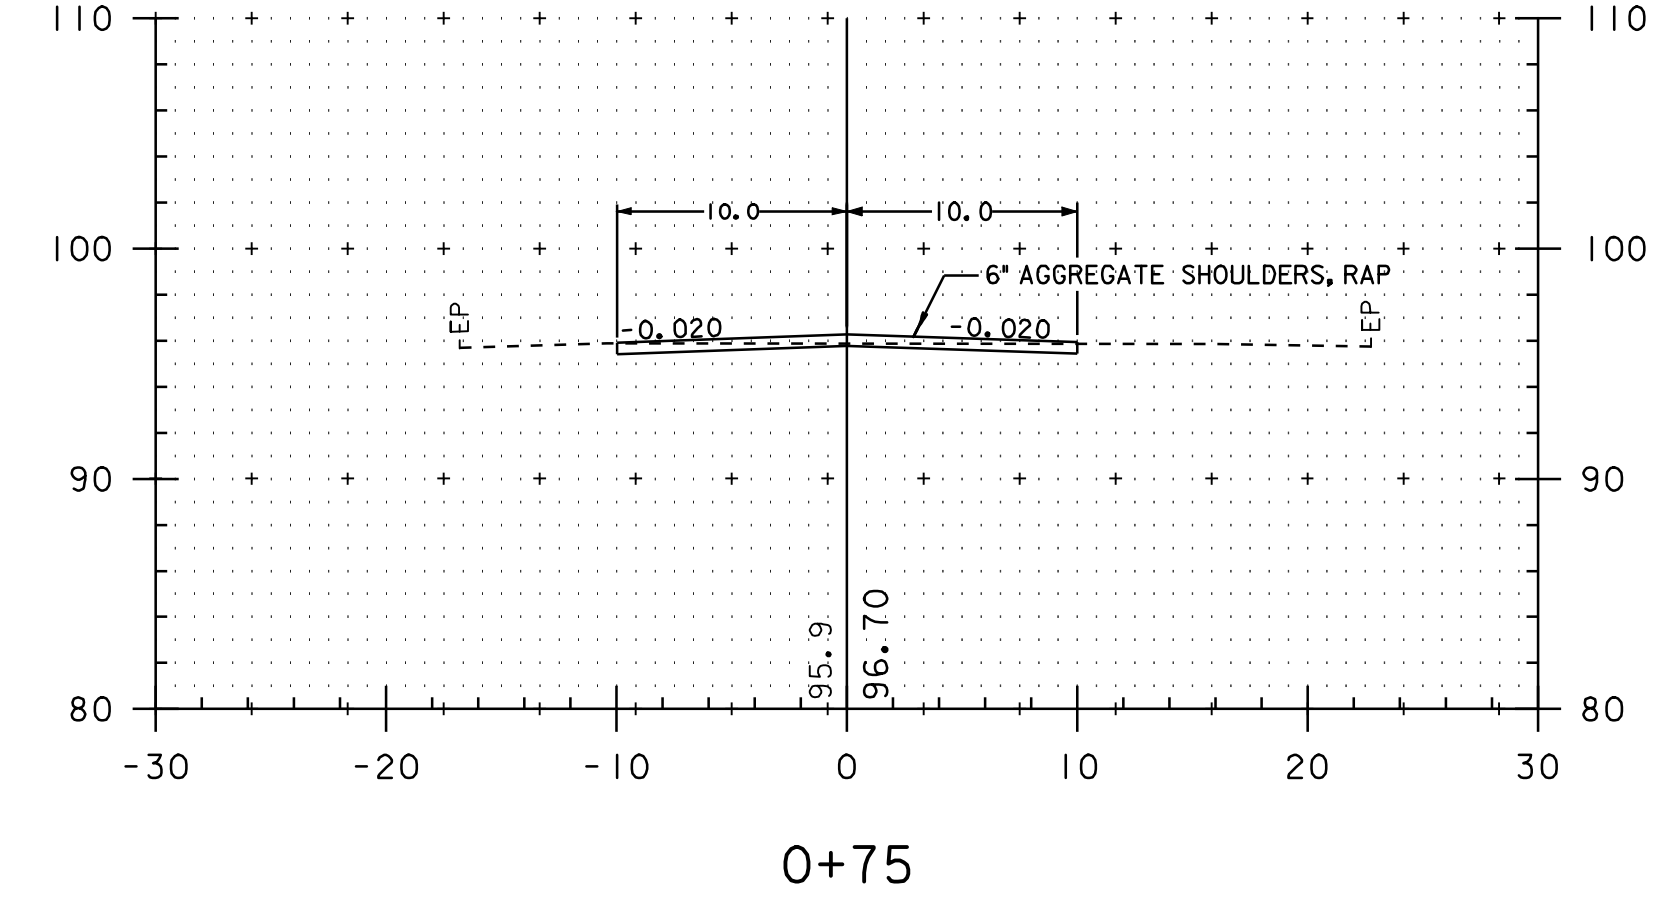
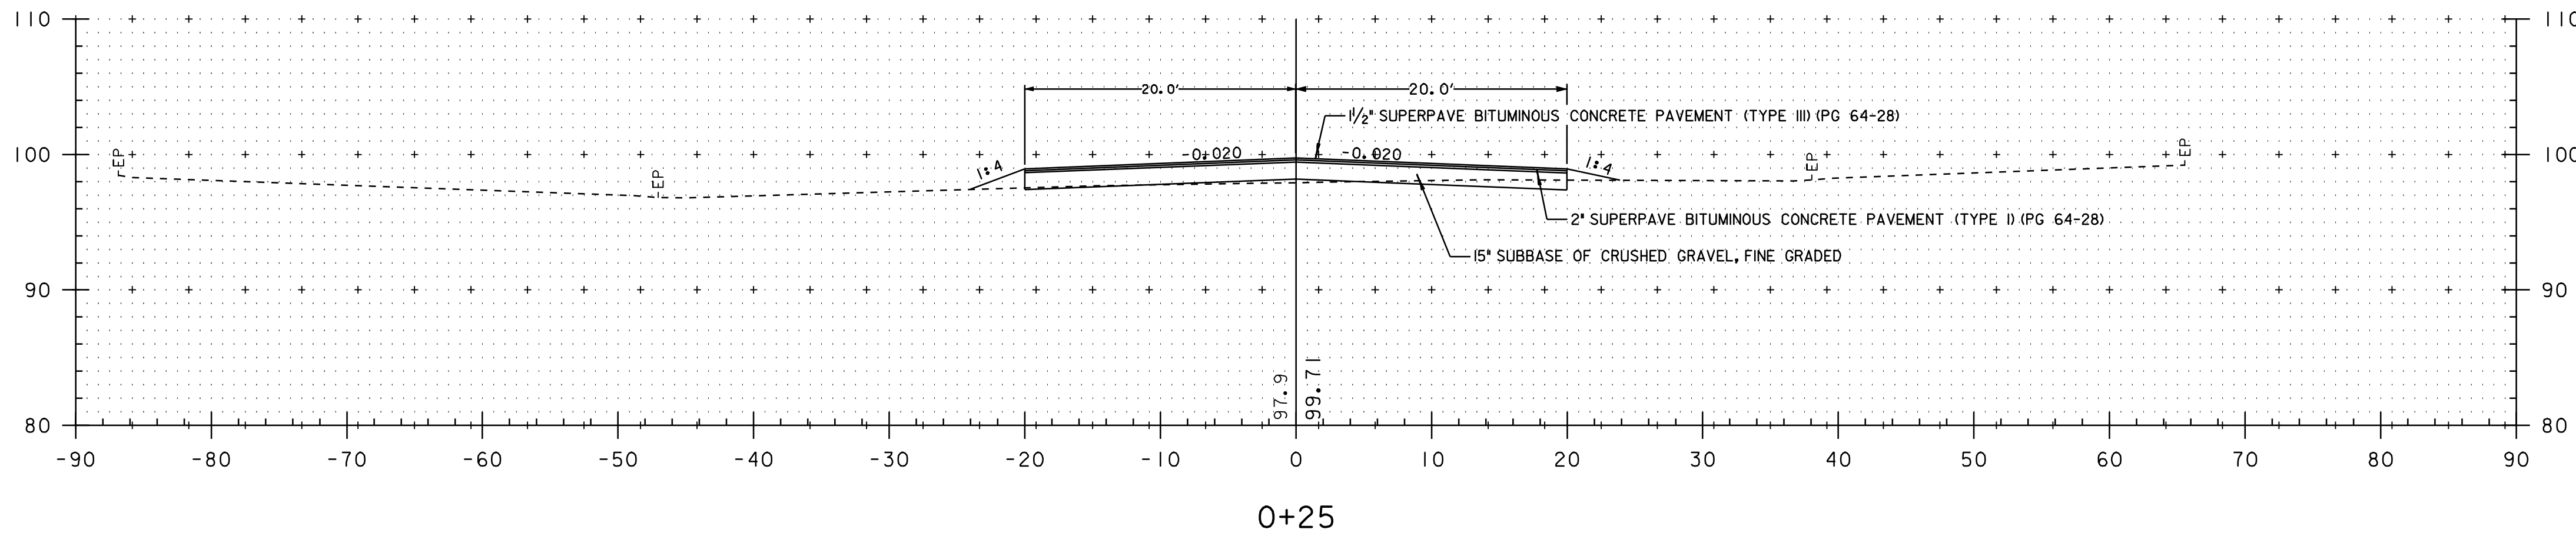
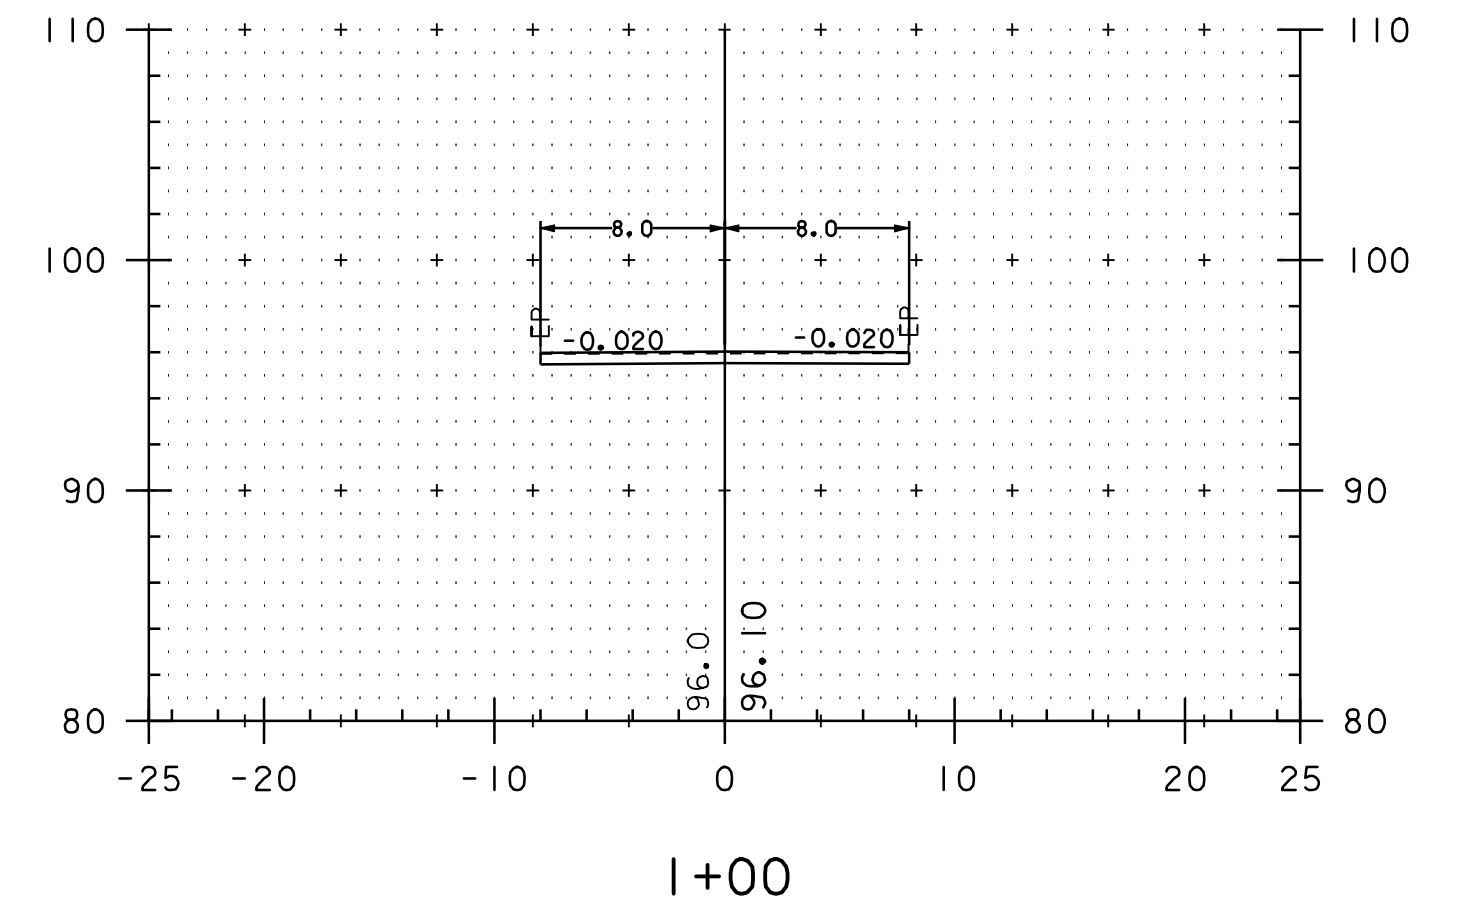
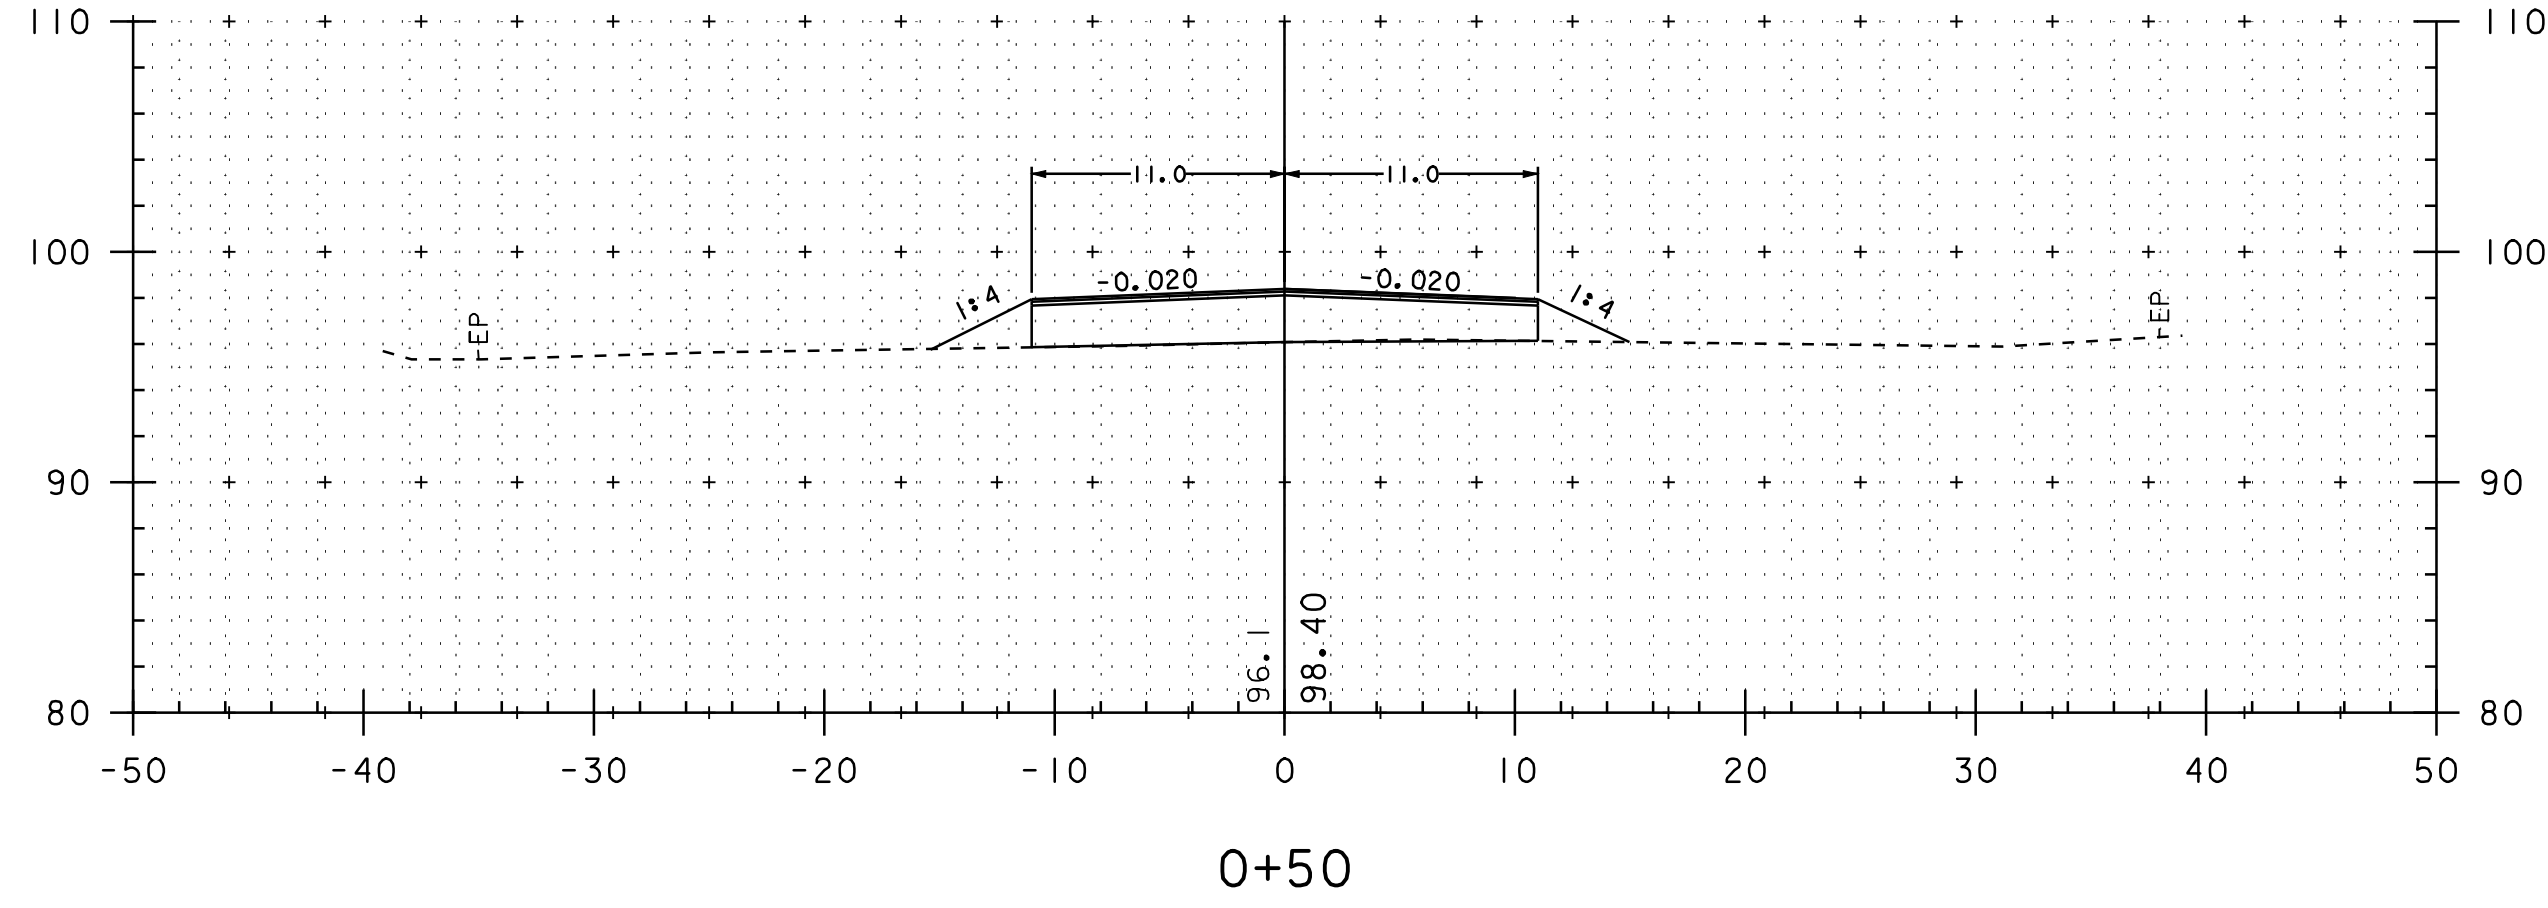


- 1 1/2" SUPERPAVE BITUMINOUS CONCRETE PAVEMENT (TYPE III S) (PG 64-28)
- 2" SUPERPAVE BITUMINOUS CONCRETE PAVEMENT (TYPE II S) (PG 64-28)
- 6" AGGREGATE SHOULDERS RAP
- 15" SUBBASE OF CRUSHED GRAVEL, FINE GRADED (UNDER PAVEMENT)
- 12" SUBBASE OF CRUSHED GRAVEL, FINE GRADED (UNDER PAVEMENT)

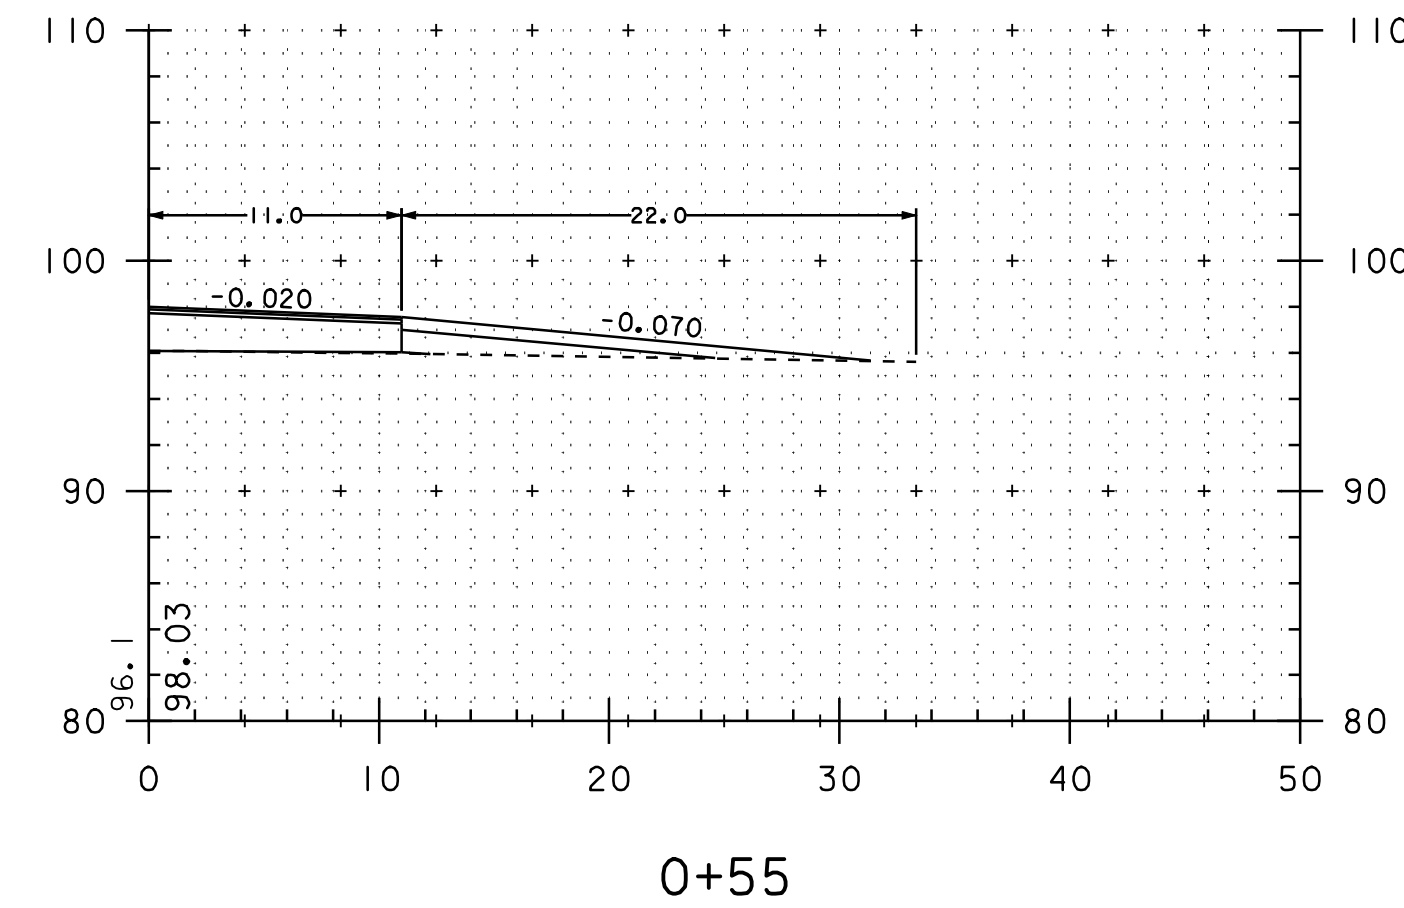

TH 17 CROSS SECTIONS SHEET	PROJECT: <u>CHESTER-LUDLOW</u>	PROJECT NO.: <u>NH_2326(I)S</u>
	DESIGN FILE NAME: /pave/01b038/pb038.dgn	PLOT DATE: 16-OCT-2009 17:
	IPARM FILE NAME: pb038pcs01.i	SURVEY DATE: 01/05
	SURVEYED BY: <u>CLD_ENGINEERS, INC</u>	DRAWN BY: MRS
SQUAD LEADER: <u>CRB</u>	SHEET: 73 OF 110	
<u>CLD-04-0396</u>		