


CURVE 17

SUPERELEVATION DIAGRAM
NTS

CHESTER
PC = 363+80 R = 1060 FT
PT = 365+60 V = 50 MPH

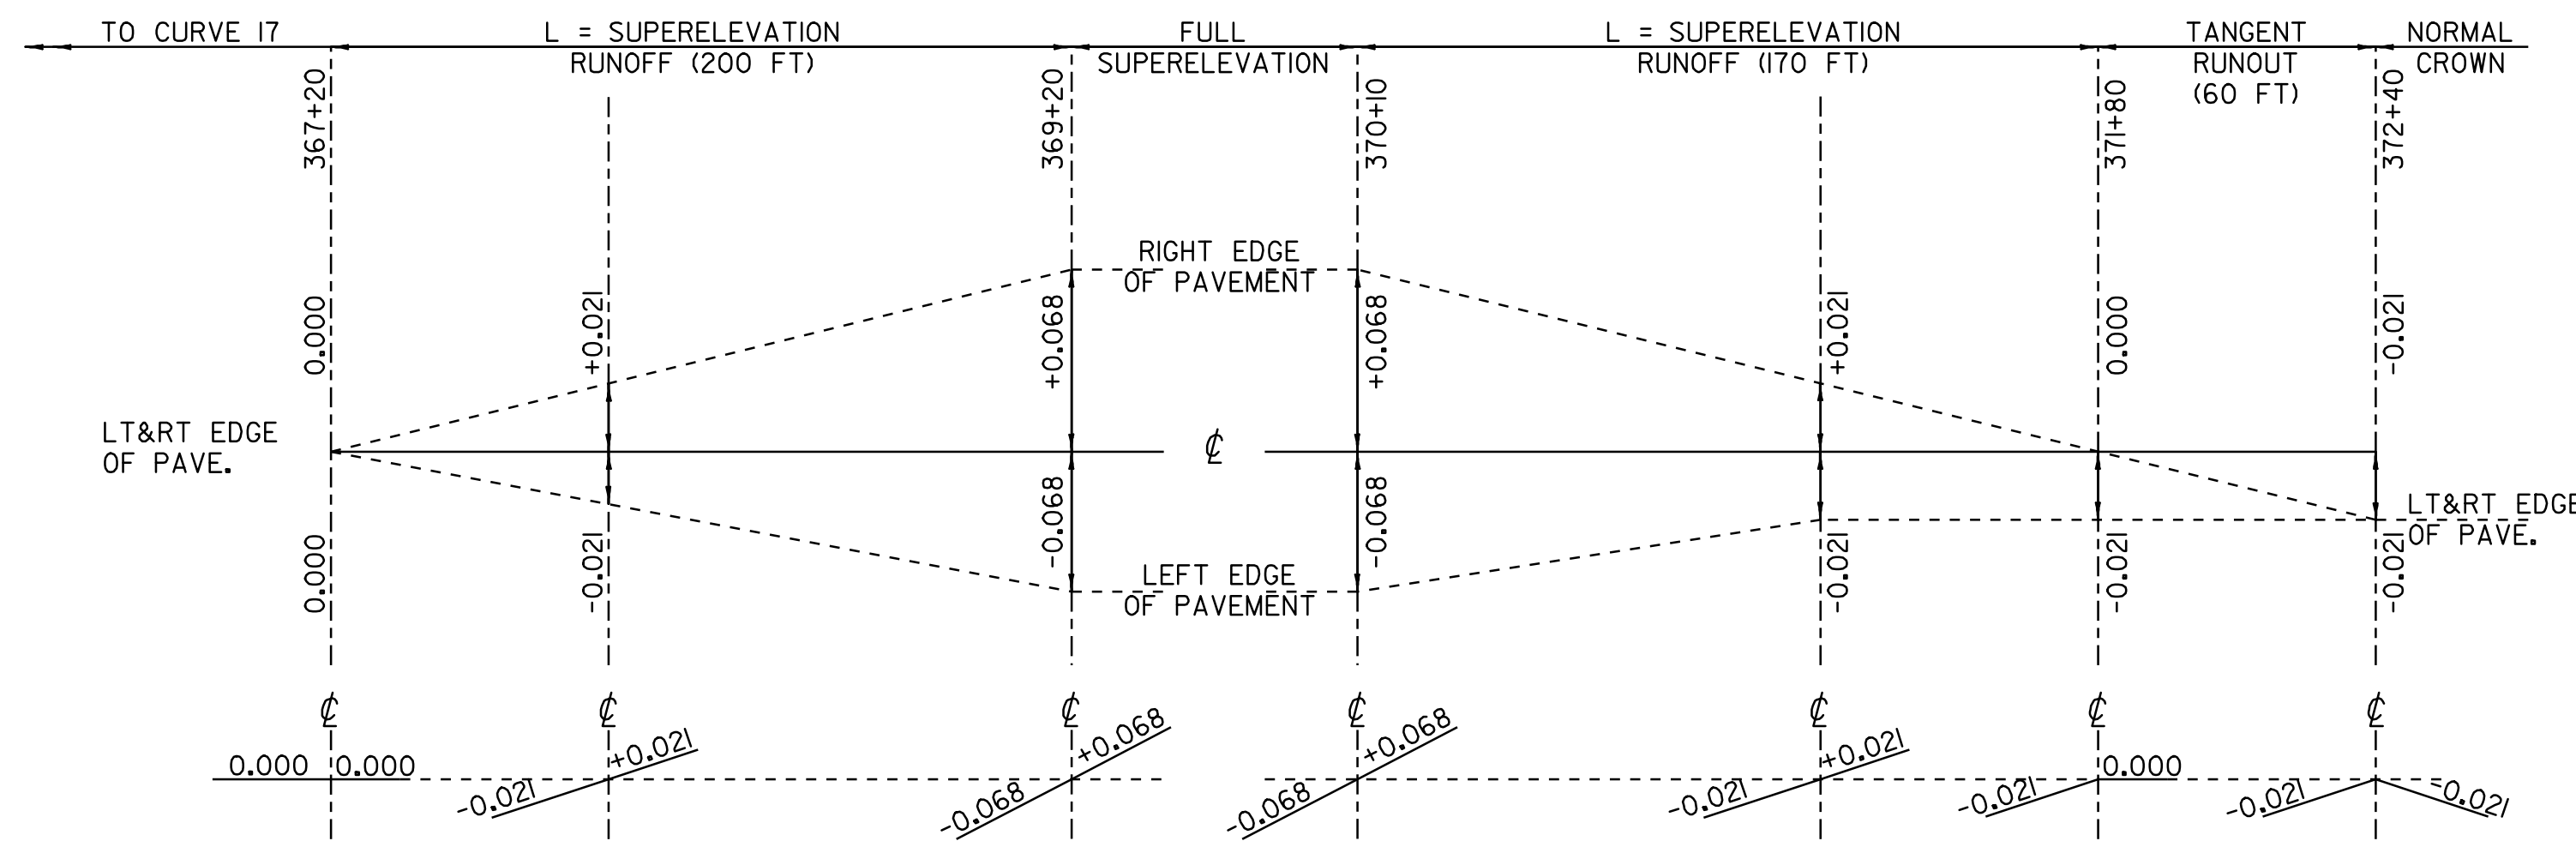

CURVE 18

SUPERELEVATION DIAGRAM
NTS

CHESTER
PC = 368+60 R = 1270 FT
PT = 370+70 V = 50 MPH

**SUPERELEVATION
BANKING DIAGRAM
SHEET #5**

SURVEYED BY	CLD	DATE	1/05
DRAWN BY	MRS	DATE	7/06
SQUAD LEADER	CRB		
DESIGN FILE NO.	/pave/01b038/pb038.dgn		
IPARM FILE	pb038d109.i	DATE PLOTTED	6 OCT-2009 17
PROJ. NAME	CHESTER - LUDLOW		
PROJ. NO.	NH 2326(1)S		
SHEET	78	OF	110 SHEETS