

646.85 - REMOVAL OF EXISTING PAVEMENT MARKINGS

- NB OFF RAMP - (STOP)
- NB OFF RAMP - (AHEAD)
- NB RAMP - (STOP BAR)
- NB OFF RAMP - (STOP @ STOP BAR)
- US 2 STA. 123+59 LT - (AHEAD)
- US 2 STA. 123+99 LT - (SIGNAL)

646.46 - DURABLE 24" STOP BAR

- US 2 STA. 119+50 RT - 12 LF
- US 2 STA. 120+46 - 120+73 (75' RT) - 27 LF
- US 2 STA. 121+10 LT - 12 LF

646.50 - DURABLE LETTER OR SYMBOL

- NB RAMP @ EXISTING (STOP AHEAD)
- LOCATION - (SIGNAL AHEAD)

675.50 - REMOVING SIGNS

- NB RAMP - (STOP AHEAD)
- US 2 STA. 120+31 RT - (STOP)
- US 2 STA. 120+85 RT - (STOP)
- US 2 STA. 123+79 LT - (SIGNAL AHEAD)

675.20 - TRAFFIC SIGNS, TYPE A

- NB RAMP @ (STOP AHEAD) LOCATION - (SIGNAL AHEAD)

621.20 - STEEL BEAM GUARD RAIL


- US 2 STA. 120+12 - 120+47 LT

621.54 - MODIFIED ECCENTRIC LOADER TERMINAL

- US 2 STA. 120+42 - 120+47 LT


NOTES

- \* ALL EXISTING LANE CONFIGURATIONS TO REMAIN.
- \* ALL EXISTING PAVEMENT MARKINGS TO REMAIN UNLESS OTHERWISE NOTED.

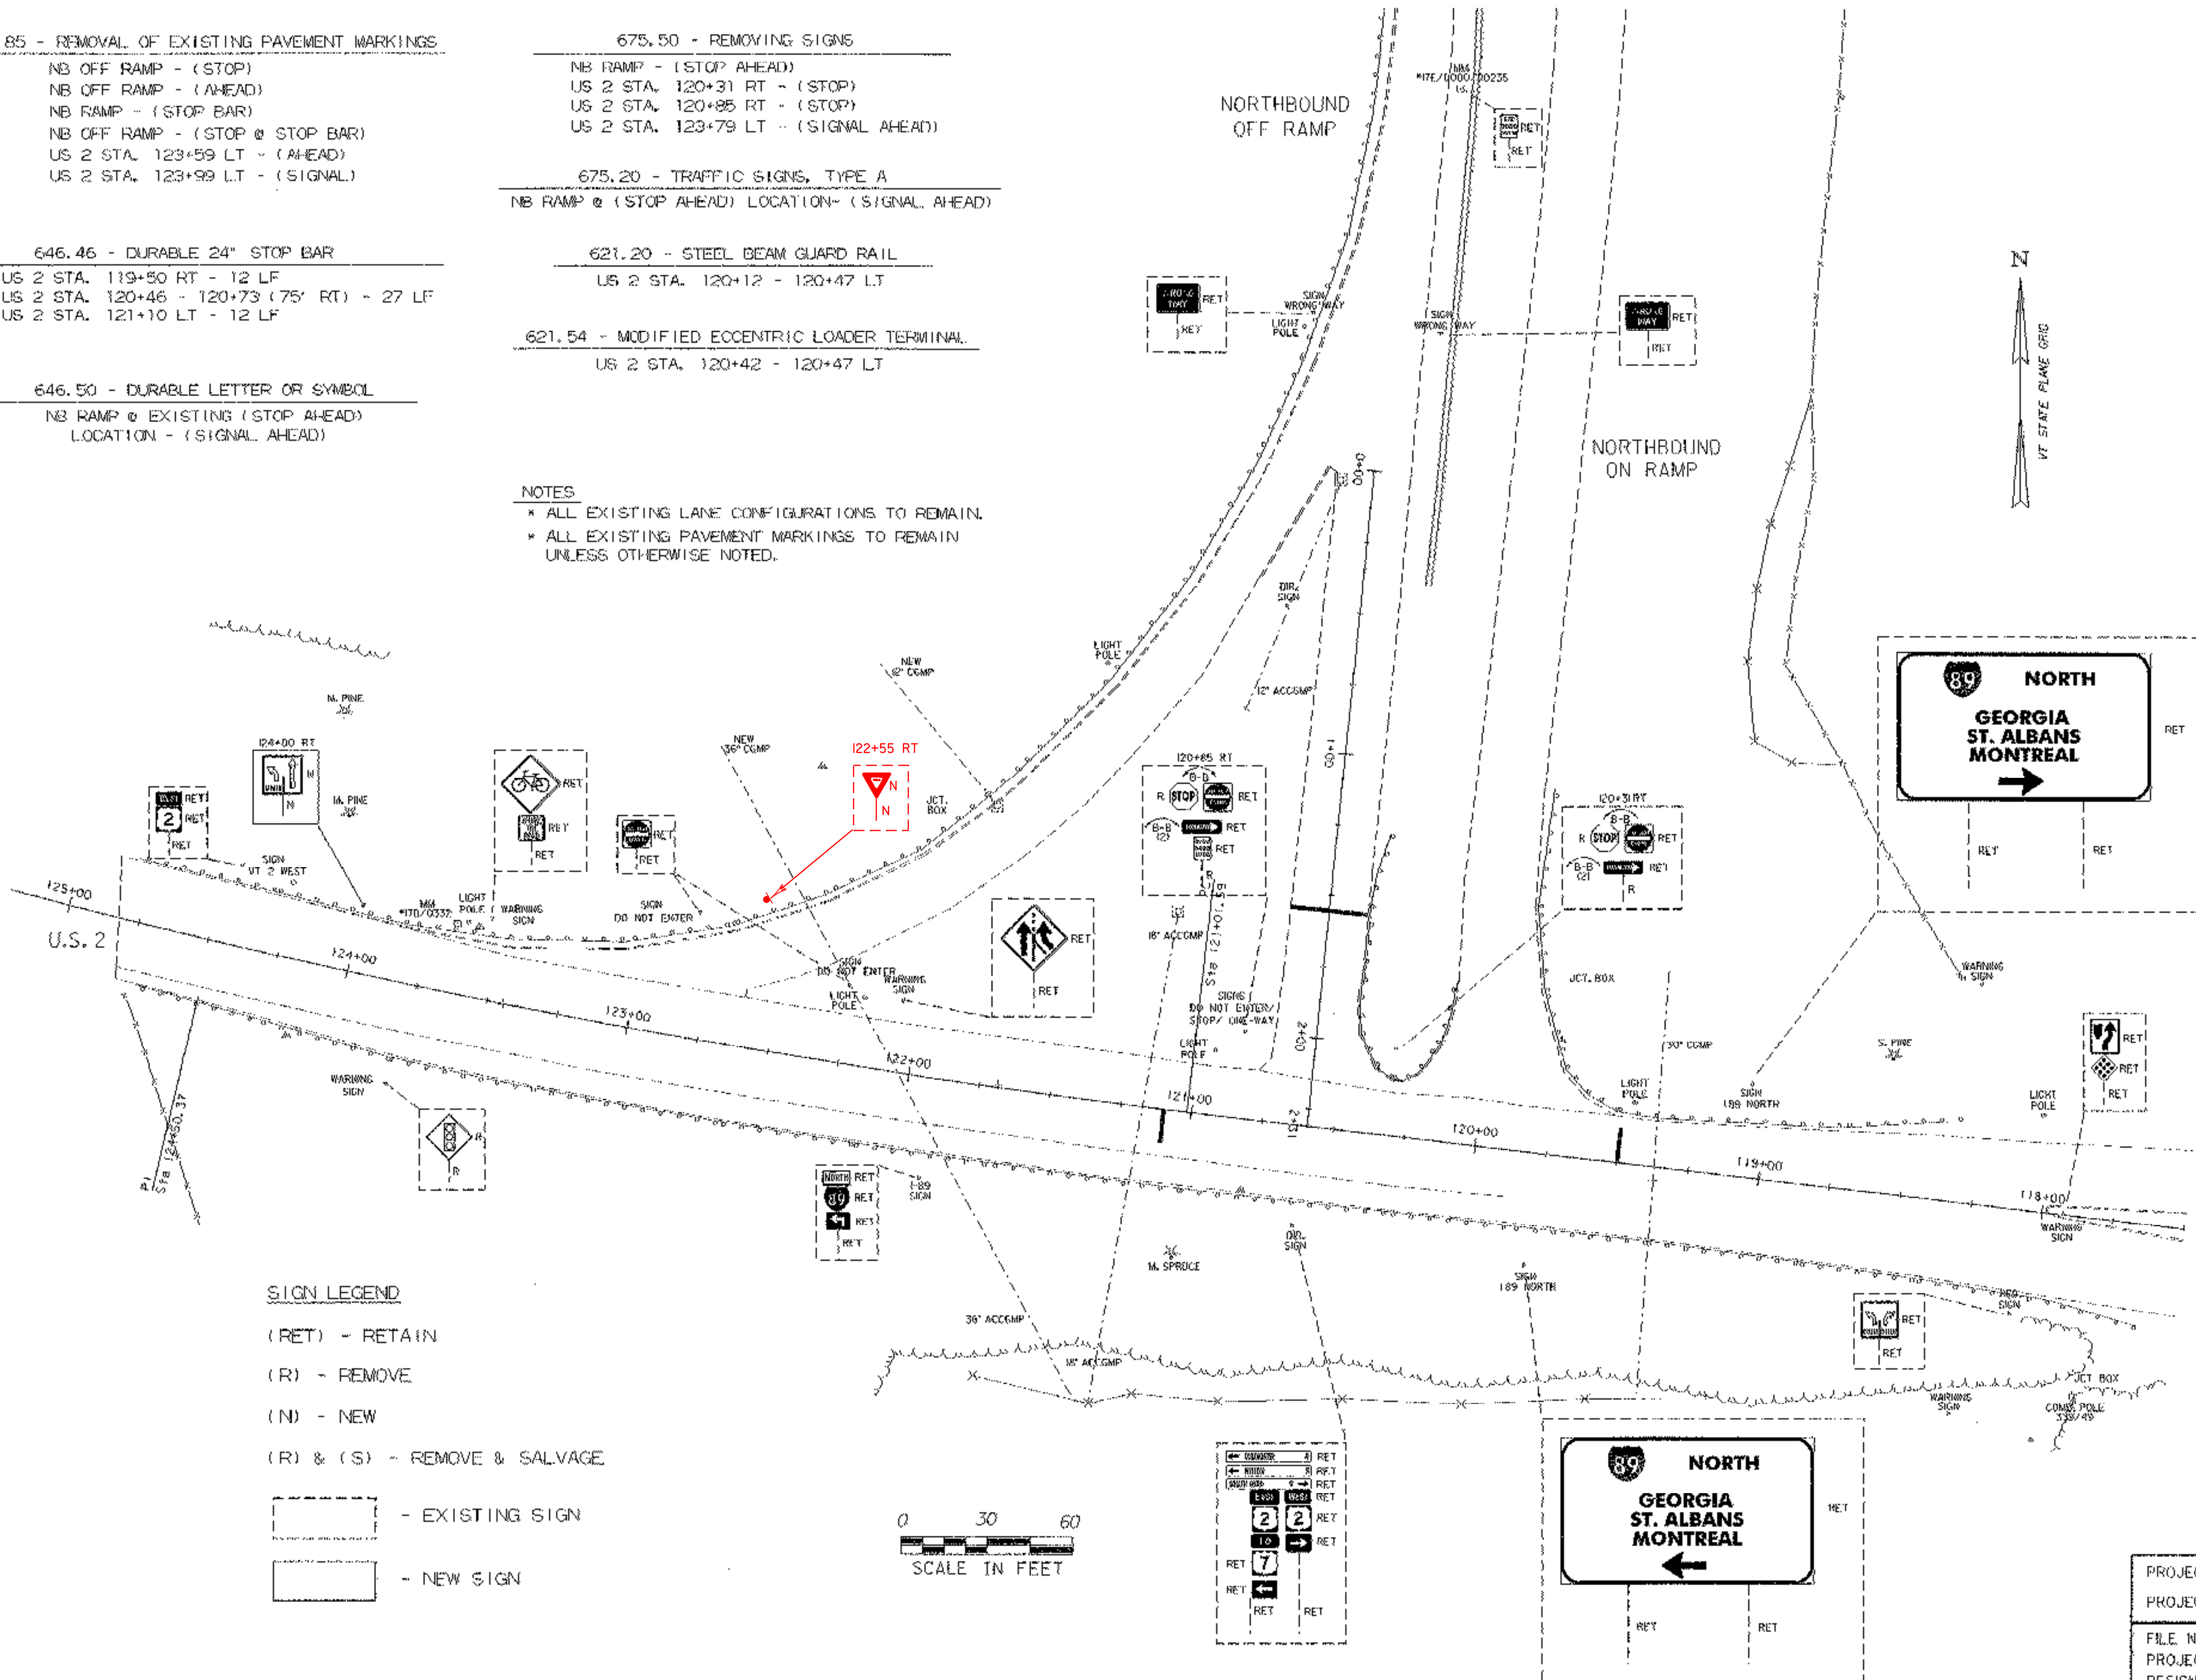

SIGN LEGEND

- (RET) - RETAIN
- (R) - REMOVE
- (N) - NEW
- (R) & (S) - REMOVE & SALVAGE
- [Dashed Box] - EXISTING SIGN
- [Solid Box] - NEW SIGN

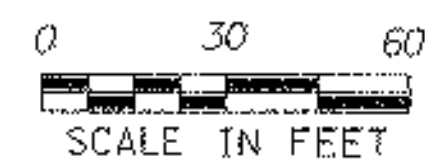

PROJECT NAME:	COLCHESTER	PLOT DATE:	18-SEP-2003
PROJECT NUMBER:	NHG_SGNL(22)	DRAWN BY:	B.MCAVOY
FILE NAME:	xbl34bdr.dgn	CHECKED BY:	
DESIGNED BY:	B.MCAVOY	SHEET	1 OF 15