

**VT ROUTE 3  
STA 0+33.00  
(MM 0.006)**

**BEGIN PROJECT  
STP 2312(1)S**

TEMPORARY 4" YELLOW LINE, PAINT  
DURABLE 4" YELLOW LINE, THERMOPLASTIC

STA 0+29 TO 0+96 SOLID RT  
STA 0+59 TO 5+50 SOLID LT & RT  
STA 1+50 TO 2+12 SOLID LT & RT

TEMPORARY 4" WHITE LINE, PAINT  
DURABLE 4" WHITE LINE, THERMOPLASTIC

STA 0+31 TO 0+96 SOLID RT  
STA 0+39 TO 5+50 SOLID LT  
STA 0+42 TO 5+50 SOLID RT  
STA 0+59 TO 1+51 SOLID LT (LANE LINE)  
STA 1+51 TO 3+50 DOTTED LT

TEMPORARY LETTER OR SYMBOL, PAINT

STA 0+72 LT - LEFT TURN ARROW  
STA 0+72 LT - THRU ARROW  
STA 0+72 LT - RIGHT TURN ARROW  
STA 0+77 TO 0+84 RT - YIELD MARKINGS (5)  
STA 1+46 LT - LEFT TURN ARROW  
STA 1+46 LT - THRU ARROW  
STA 1+46 LT - RIGHT TURN ARROW

DURABLE LETTER OR SYMBOL, THERMOPLASTIC

STA 0+72 LT - LEFT TURN ARROW  
STA 0+72 LT - THRU ARROW  
STA 0+72 LT - RIGHT TURN ARROW  
STA 0+77 TO 0+84 RT - YIELD MARKINGS (5)  
STA 1+09 LT - "ONLY"  
STA 1+46 LT - LEFT TURN ARROW  
STA 1+46 LT - THRU ARROW  
STA 1+46 LT - RIGHT TURN ARROW

TEMPORARY 24" STOP BAR, PAINT  
DURABLE 24" STOP BAR, THERMOPLASTIC  
STA 0+59 LT

PAINTED CURB

STA 0+22 TO 0+30 RT ( ISLAND)  
STA 0+22 TO 0+77 RT ( ISLAND)  
STA 0+30 TO 0+77 RT ( ISLAND)  
STA 0+52 TO 0+82 LT & RT ( ISLAND)  
STA 1+20 TO 1+50 LT & RT ( ISLAND)

PAINTED ISLAND

STA 0+52 TO 1+50 CL

REHAB. DROP INLET,  
CATCH BASINS, OR MANHOLES, CLASS I  
STA 1+48 LT

REMOVAL AND DISPOSAL OF GUARDRAIL  
STA 1+68 TO 4+55 LT

STEEL BEAM GUARDRAIL, GALVANIZED  
STA 1+49.5 TO 4+24.5 LT

ANCHOR FOR STEEL BEAM RAIL  
STA 1+49.5


MANUFACTURED TERMINAL SECTION, FLARED  
STA 4+24.5 TO 4+62.0 LT

REMOVAL AND DISPOSAL OF GUIDE POSTS  
STA 4+62 LT

SPECIAL PROVISION  
(REMOVING SIGN POSTS)  
STA 1+40 LT

REMOVING SIGNS  
AS SHOWN - 8 6

ERECTING SALVAGED SIGNS  
AS SHOWN - 1

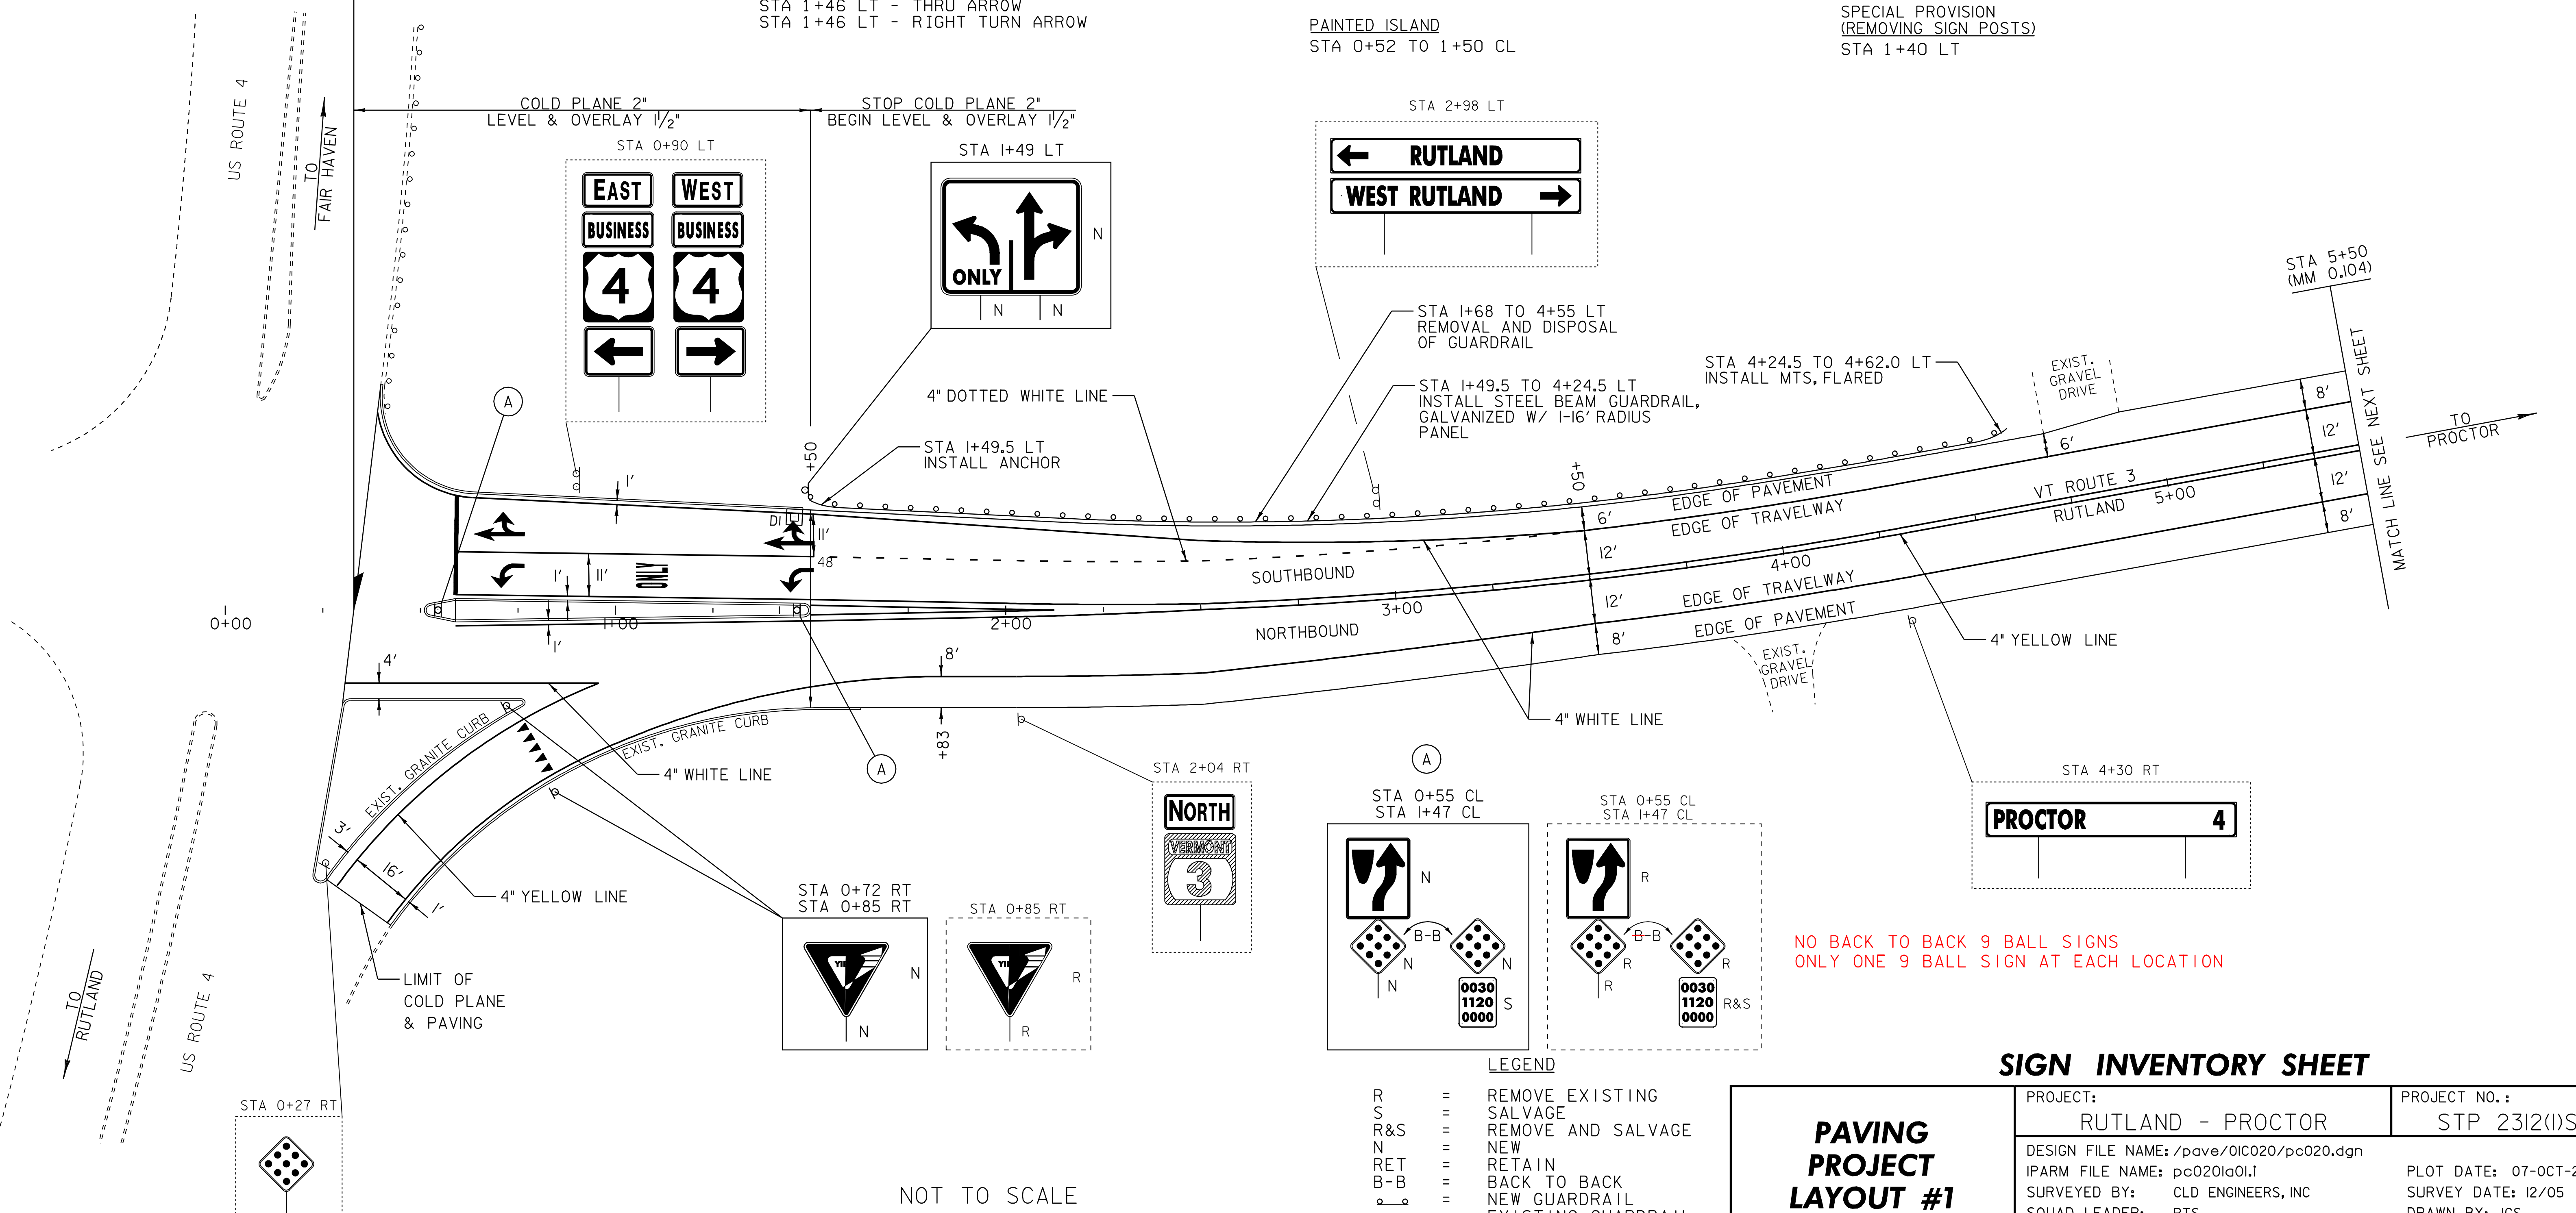

NO BACK TO BACK 9 BALL SIGNS  
ONLY ONE 9 BALL SIGN AT EACH LOCATION

**SIGN INVENTORY SHEET**

LEGEND

R	=	REMOVE EXISTING
S	=	SALVAGE
R&S	=	REMOVE AND SALVAGE
N	=	NEW
RET	=	RETAIN
B-B	=	BACK TO BACK
—	=	NEW GUARDRAIL
—	=	EXISTING GUARDRAIL

<b>PAVING PROJECT LAYOUT #1</b>	PROJECT: RUTLAND - PROCTOR	PROJECT NO.: STP 2312(1)S
	DESIGN FILE NAME: /pave/01C020/pc020.dgn	PLOT DATE: 07-OCT-2008 11:
	IPARM FILE NAME: pc020la01.i	SURVEY DATE: 12/05
	SURVEYED BY: CLD ENGINEERS, INC	DRAWN BY: JCS
	SQUAD LEADER: PTS	SHEET: 10 OF 33
	CLD REF. NO. 05-0390	

NOT TO SCALE