

TEMPORARY 4" YELLOW LINE, PAINT
 DURABLE 4" YELLOW LINE, THERMOPLASTIC
 STA 5+50 TO 16+00 SOLID LT & RT

TEMPORARY 4" WHITE LINE, PAINT
 DURABLE 4" WHITE LINE, THERMOPLASTIC
 STA 5+50 TO 16+00 SOLID LT & RT

TEMPORARY LETTER OR SYMBOL, PAINT
 DURABLE LETTER OR SYMBOL, THERMOPLASTIC
 STA 7+47 LT - "AHEAD"
 STA 7+87 LT - "SIGNAL"

TEMPORARY RAILROAD CROSSING SYMBOL, PAINT
 DURABLE RAILROAD CROSSING SYMBOL, THERMOPLASTIC
 STA 15+84 RT

BITUMINOUS CONCRETE GUTTERS AND TRAFFIC ISLANDS
 STA 10+37 RT - REHAB

REHAB. DROP INLETS, CATCH BASINS, OR MANHOLES, CLASS I
 STA 9+95 RT - DROP INLET
 STA 14+25 RT - DROP INLET
 STA 5+75 LT

REMOVAL AND DISPOSAL OF GUARDRAIL
 STA 7+03 TO 11+04 LT
 STA 9+77 TO 16+00 RT
 STA 11+35 TO 16+00 LT

STEEL BEAM GUARDRAIL, GALVANIZED W/8' POSTS
 STA 7+40.5 TO 10+65.5 LT
 STA 8+42.5 TO ~~16+00.0~~ RT 10+29.5 RT
~~STA 11+66.5 TO 16+00.0 LT~~


MANUFACTURED TERMINAL SECTION, FLARED
 STA 7+03.0 TO 7+40.5 LT
 STA 8+05.0 TO 8+42.5 RT

REMOVING SIGNS
 AS SHOWN - 2

MANUFACTURED TERMINAL SECTION, TANGENT
 STA 10+65.5 TO 11+03.0 LT
 STA 11+29.0 TO 11+66.5 LT

BITUMINOUS CONCRETE CURB, TYPE B
 STA 10+07 TO 16+00 RT

STEEL BEAM GUARDRAIL, GAL.
 STA 10+92.5 TO 16+00 RT
 STA 11+66.5 TO 16+00 LT

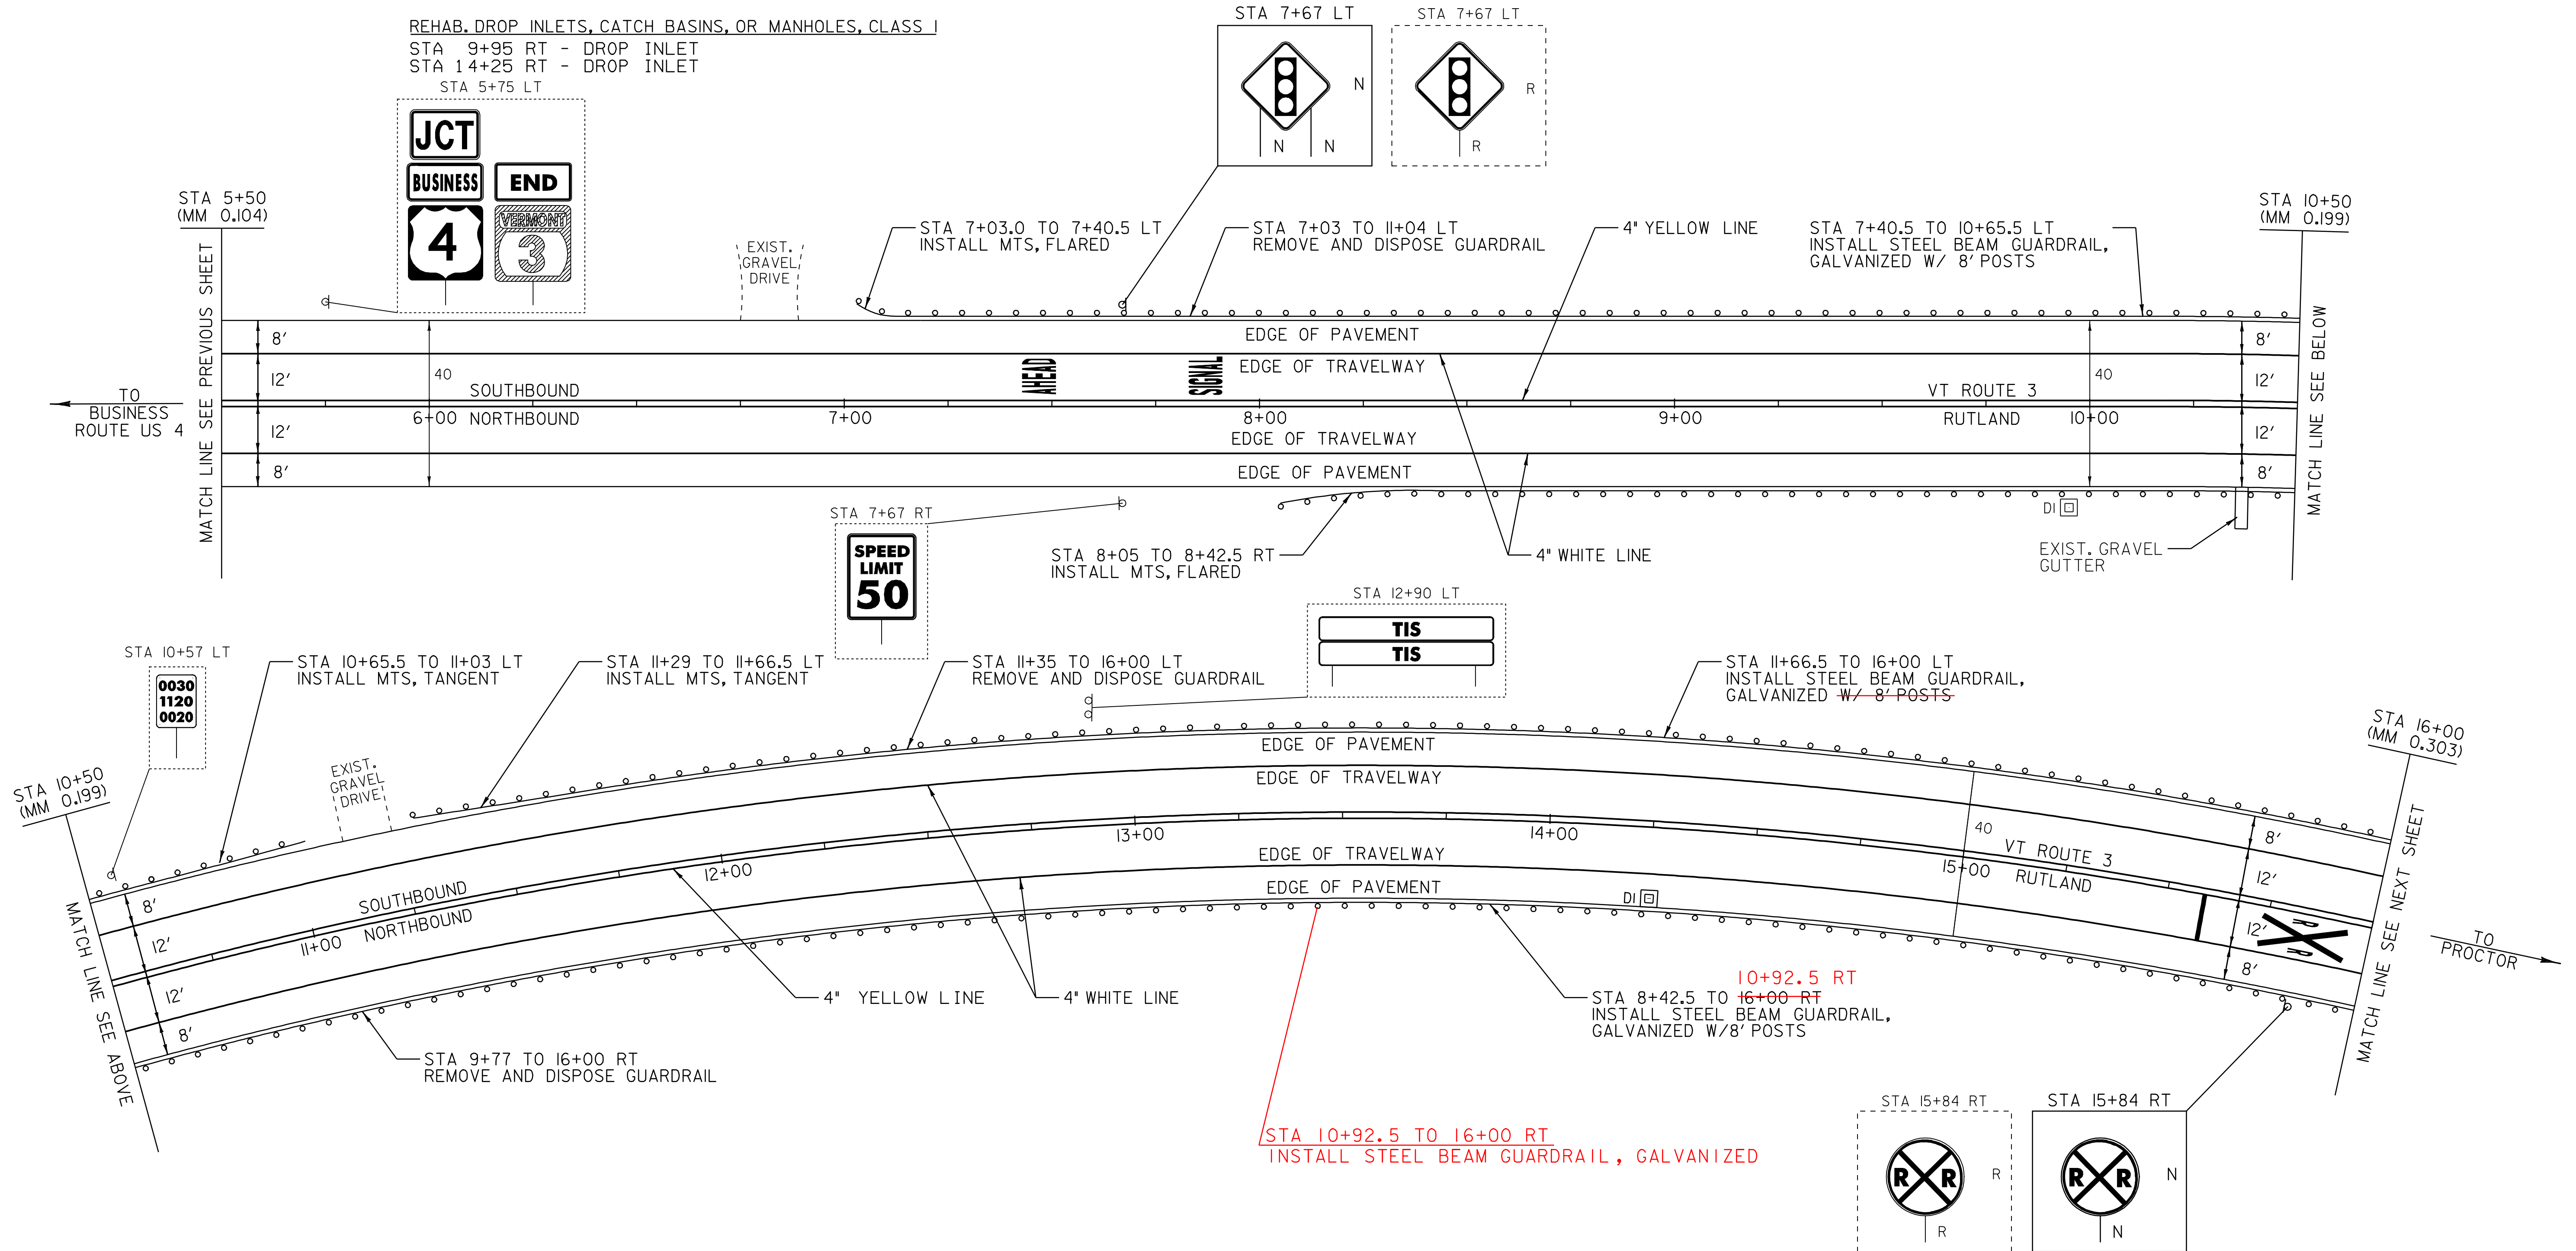

NOT TO SCALE

LEGEND

- R = REMOVE EXISTING
- S = SALVAGE
- R&S = REMOVE AND SALVAGE
- N = NEW
- RET = RETAIN
- B-B = BACK TO BACK
- = NEW GUARDRAIL
- = EXISTING GUARDRAIL

PAVING PROJECT LAYOUT #2

SIGN INVENTORY SHEET

PROJECT: RUTLAND - PROCTOR	PROJECT NO.: STP 2312(I)S
DESIGN FILE NAME: /pave/01C020/pc020.dgn	PLOT DATE: 07-OCT-2008 11:58
IPARM FILE NAME: pc020la02.i	SURVEY DATE: 12/05
SURVEYED BY: CLD ENGINEERS, INC	DRAWN BY: JCS
SQUAD LEADER: PTS	SHEET: 11 OF 33
CLD REF. NO. 05-0390	