


TEMPORARY 4" YELLOW LINE, PAINT
 DURABLE 4" YELLOW LINE, THERMOPLASTIC
 STA P 7+00 TO 9+74 SOLID LT & RT
 STA P 10+14 TO 10+30 SOLID LT & RT
 STA P 10+30 TO 14+25 SOLID LT, DASHED RT
 STA P 14+25 TO 17+00 DASHED

TEMPORARY 4" WHITE LINE, PAINT
 DURABLE 4" WHITE LINE, THERMOPLASTIC
 STA P 7+00 TO 17+00 SOLID LT
 STA P 7+00 TO 9+54 SOLID RT
 STA P 10+34 TO 17+00 SOLID RT

REMOVING SIGNS
 AS SHOWN - 6

ERECTING SALVAGED SIGNS
 AS SHOWN - 2

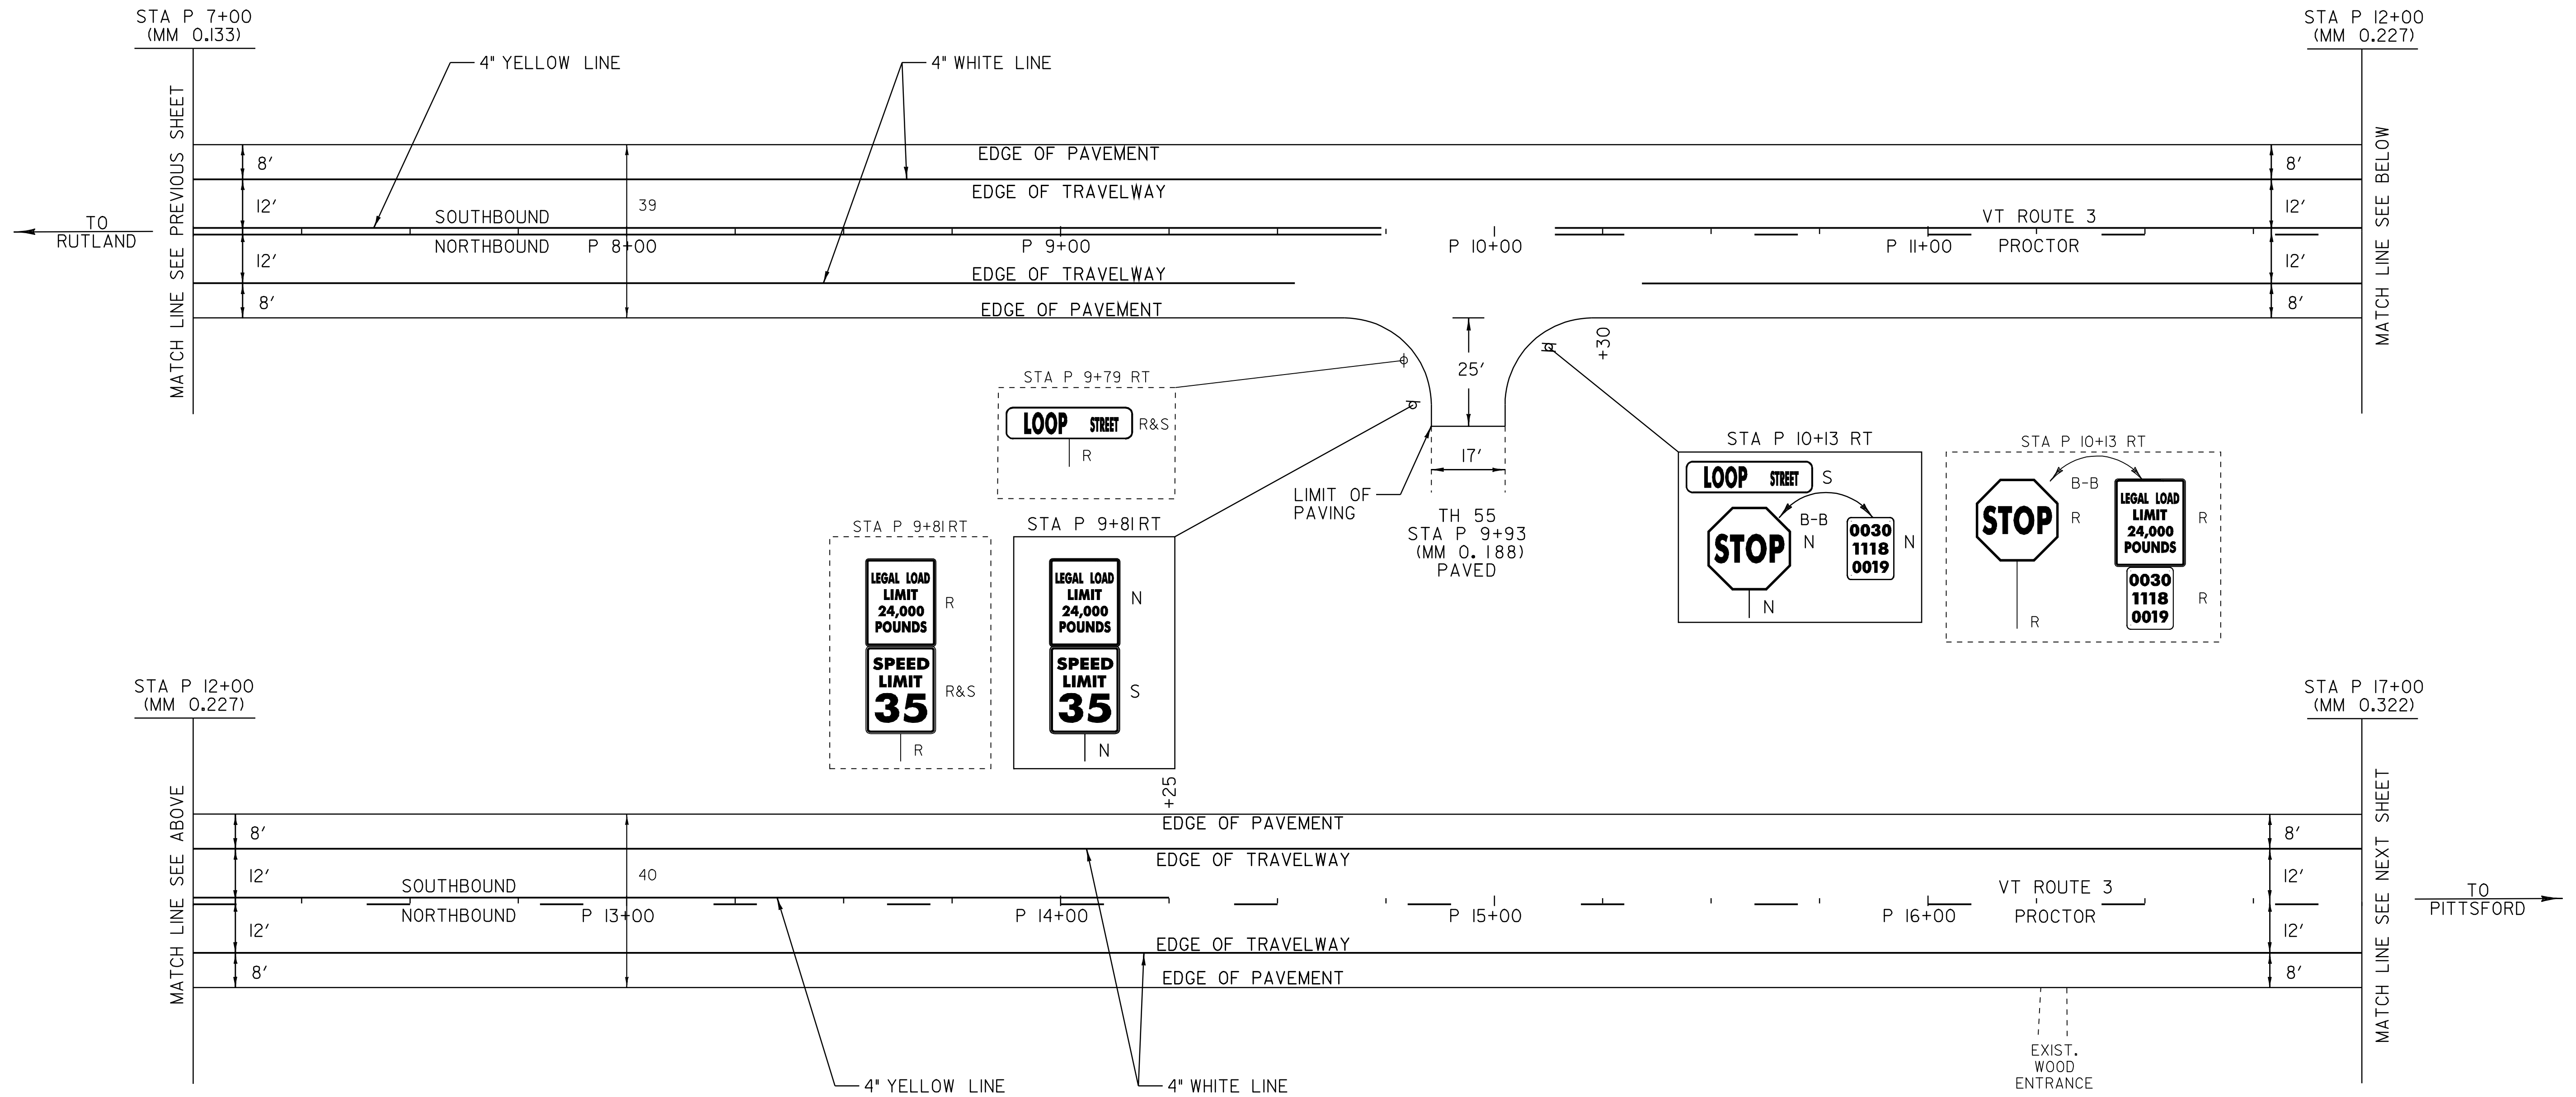

NOT TO SCALE

LEGEND

- R = REMOVE EXISTING
- S = SALVAGE
- R&S = REMOVE AND SALVAGE
- N = NEW
- RET = RETAIN
- B-B = BACK TO BACK
- = NEW GUARDRAIL
- = EXISTING GUARDRAIL

**PAVING
 PROJECT
 LAYOUT #11**

SIGN INVENTORY SHEET

PROJECT: RUTLAND - PROCTOR	PROJECT NO.: STP 2312(I)S
DESIGN FILE NAME: /pave/01C020/pc020.dgn	PLOT DATE: 07-OCT-2008 11:
IPARM FILE NAME: pc020dall.i	SURVEY DATE: 12/05
SURVEYED BY: CLD ENGINEERS, INC	DRAWN BY: JCS
SQUAD LEADER: PTS	SHEET: 20 OF 33
CLD REF. NO. 05-0390	