

TEMPORARY 4" YELLOW LINE, PAINT
 DURABLE 4" YELLOW LINE, THERMOPLASTIC
 STA P 86+50 TO 95+11 SOLID LT & RT
 STA P 95+31 DOUBLE SOLID RT (TH 56)
 STA P 95+51 TO 95+70 SOLID LT & RT


TEMPORARY 4" WHITE LINE, PAINT
 DURABLE 4" WHITE LINE, THERMOPLASTIC
 STA P 86+50 TO 95+20 SOLID RT
 STA P 86+50 TO 95+70 SOLID LT
 STA P 95+42 TO 95+70 SOLID RT

TEMPORARY LETTER OR SYMBOL, PAINT
 DURABLE LETTER OR SYMBOL, THERMOPLASTIC
 STA P 95+37 RT - "STOP" (TH 56)

TEMPORARY 24" STOP BAR, PAINT
 DURABLE 24" STOP BAR, THERMOPLASTIC
 STA P 95+37 RT (TH 56)

REMOVING SIGNS
 AS SHOWN - 4

ERECTING SALVAGED SIGNS
 AS SHOWN - 2

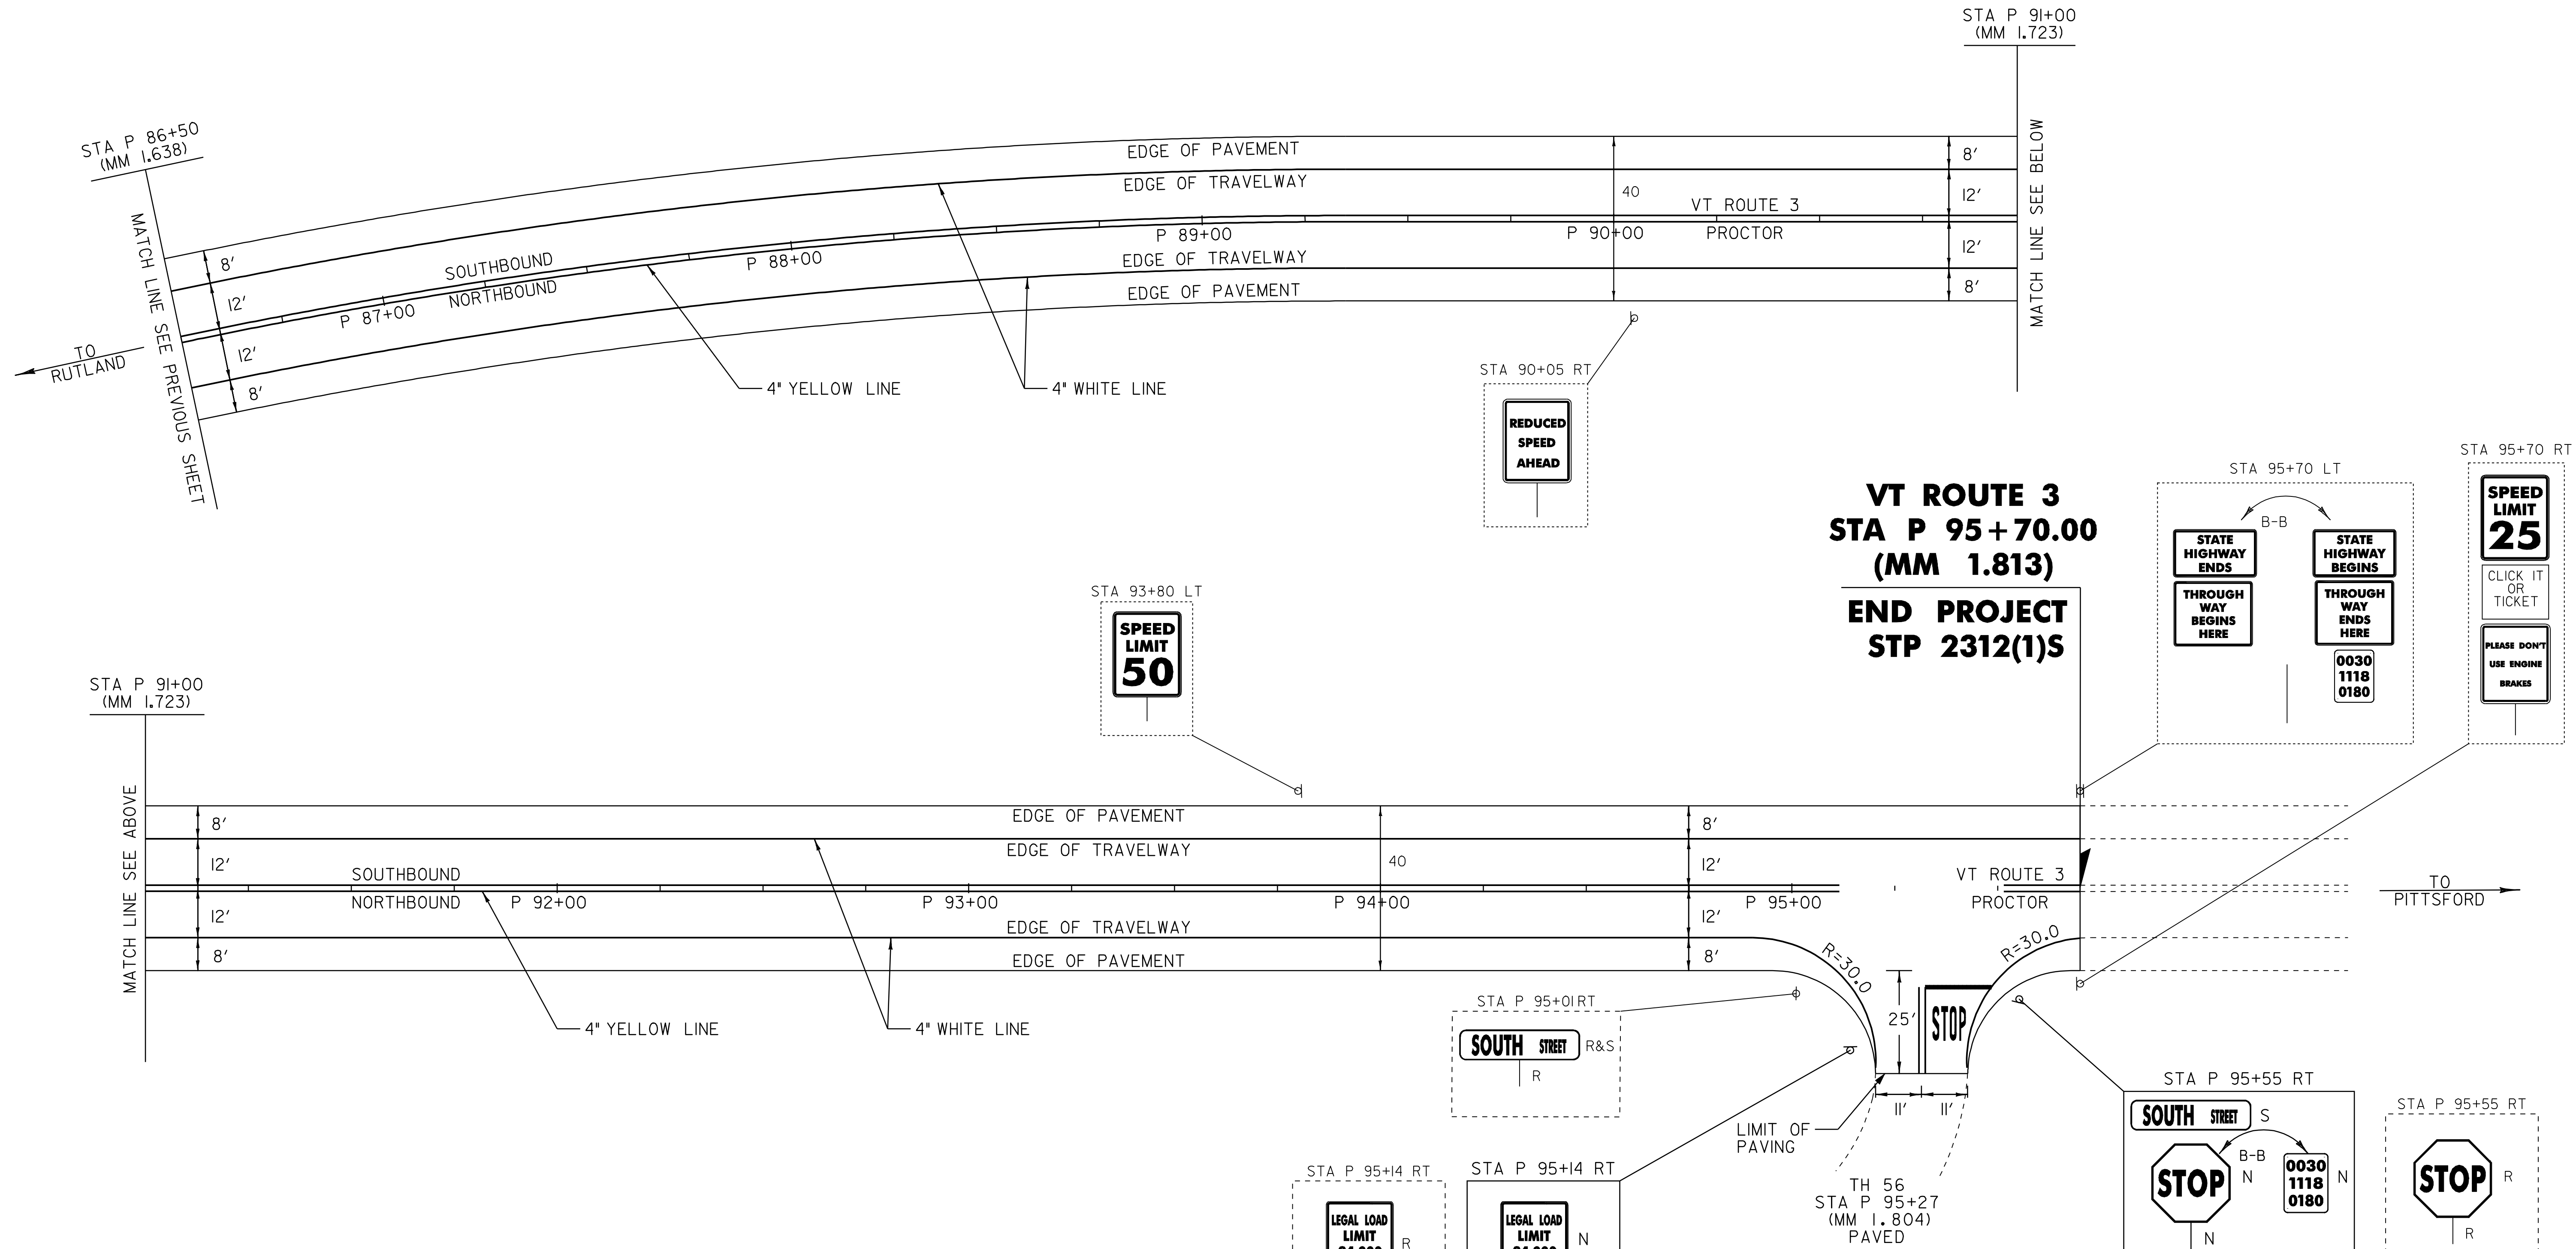

NOT TO SCALE

LEGEND

- R = REMOVE EXISTING
- S = SALVAGE
- R&S = REMOVE AND SALVAGE
- N = NEW
- RET = RETAIN
- B-B = BACK TO BACK
- = NEW GUARDRAIL
- - - = EXISTING GUARDRAIL

PAVING PROJECT LAYOUT #19

SIGN INVENTORY SHEET

PROJECT: RUTLAND - PROCTOR	PROJECT NO.: STP 2312(1)S
DESIGN FILE NAME: /pave/01C020/pc020.dgn	PLOT DATE: 07-OCT-2008 11:58
IPARM FILE NAME: pc020ldl9.i	SURVEY DATE: 12/05
SURVEYED BY: CLD ENGINEERS, INC	DRAWN BY: JCS
SQUAD LEADER: PTS	SHEET: 28 OF 33
CLD REF. NO. 05-0390	