




**US ROUTE 5
BEGIN STP 2310 (1)**

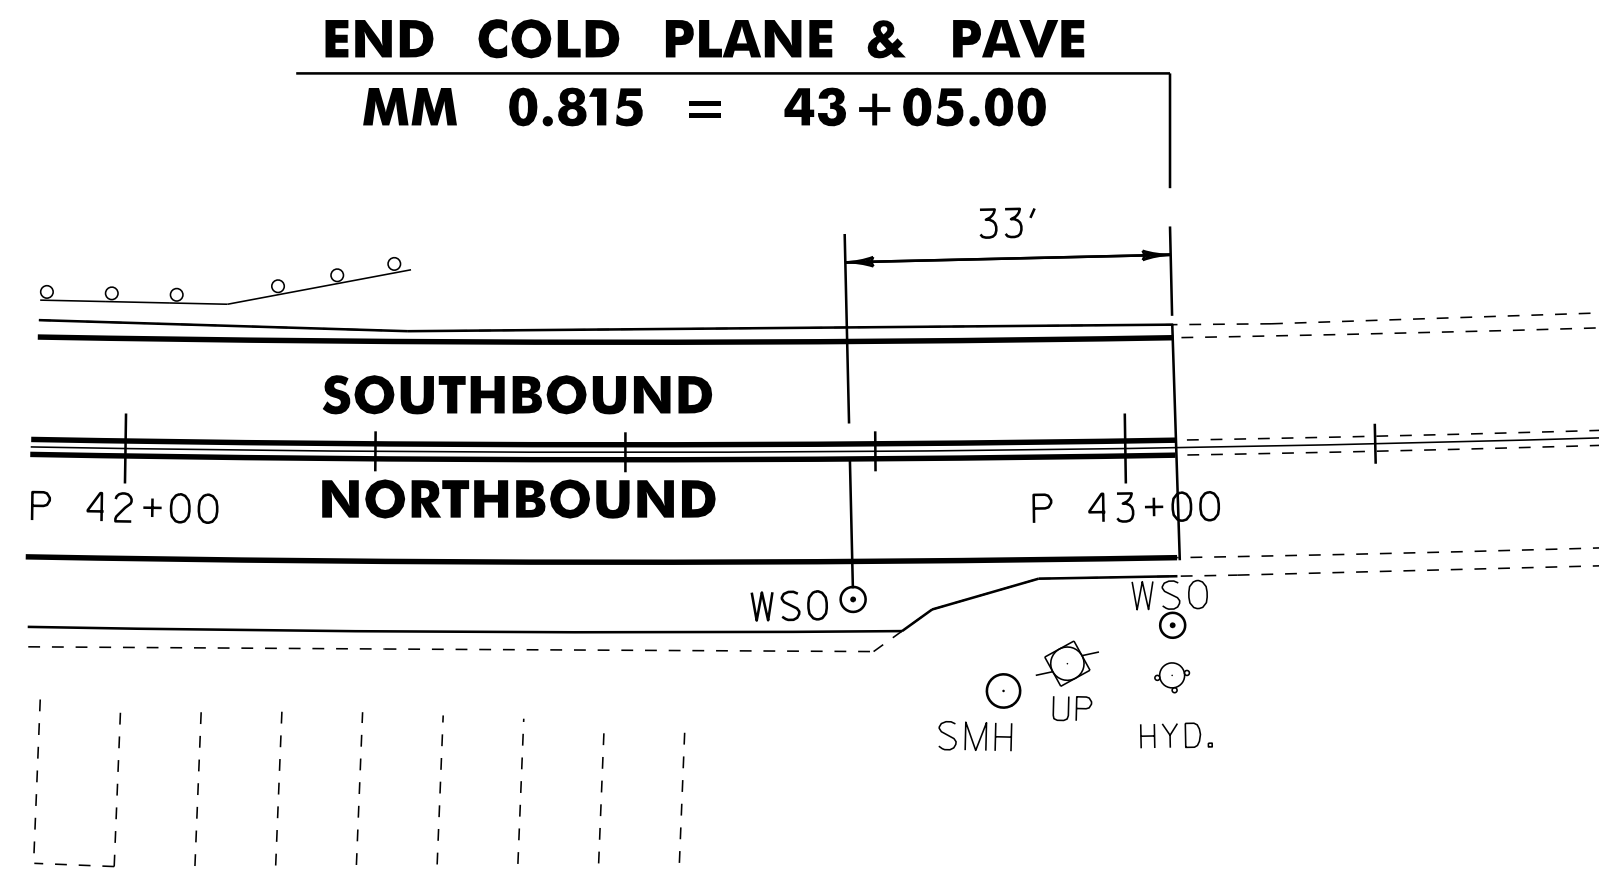


**US ROUTE 5
END STP 2310 (1)**

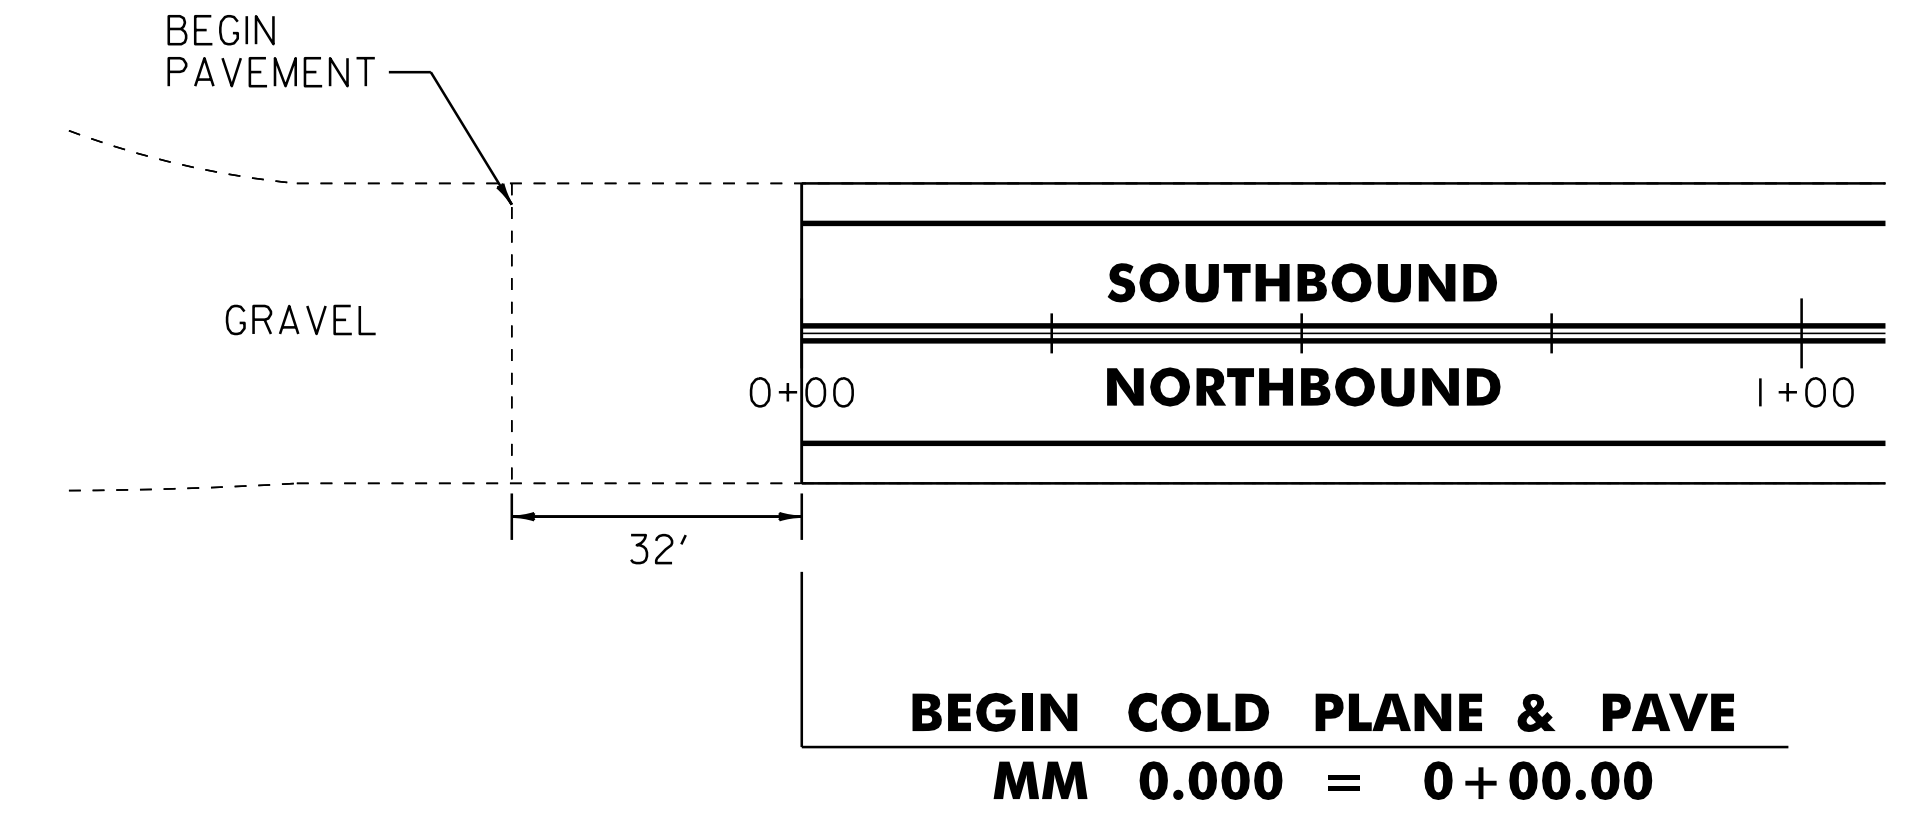

PUTNEY STATE HIGHWAY

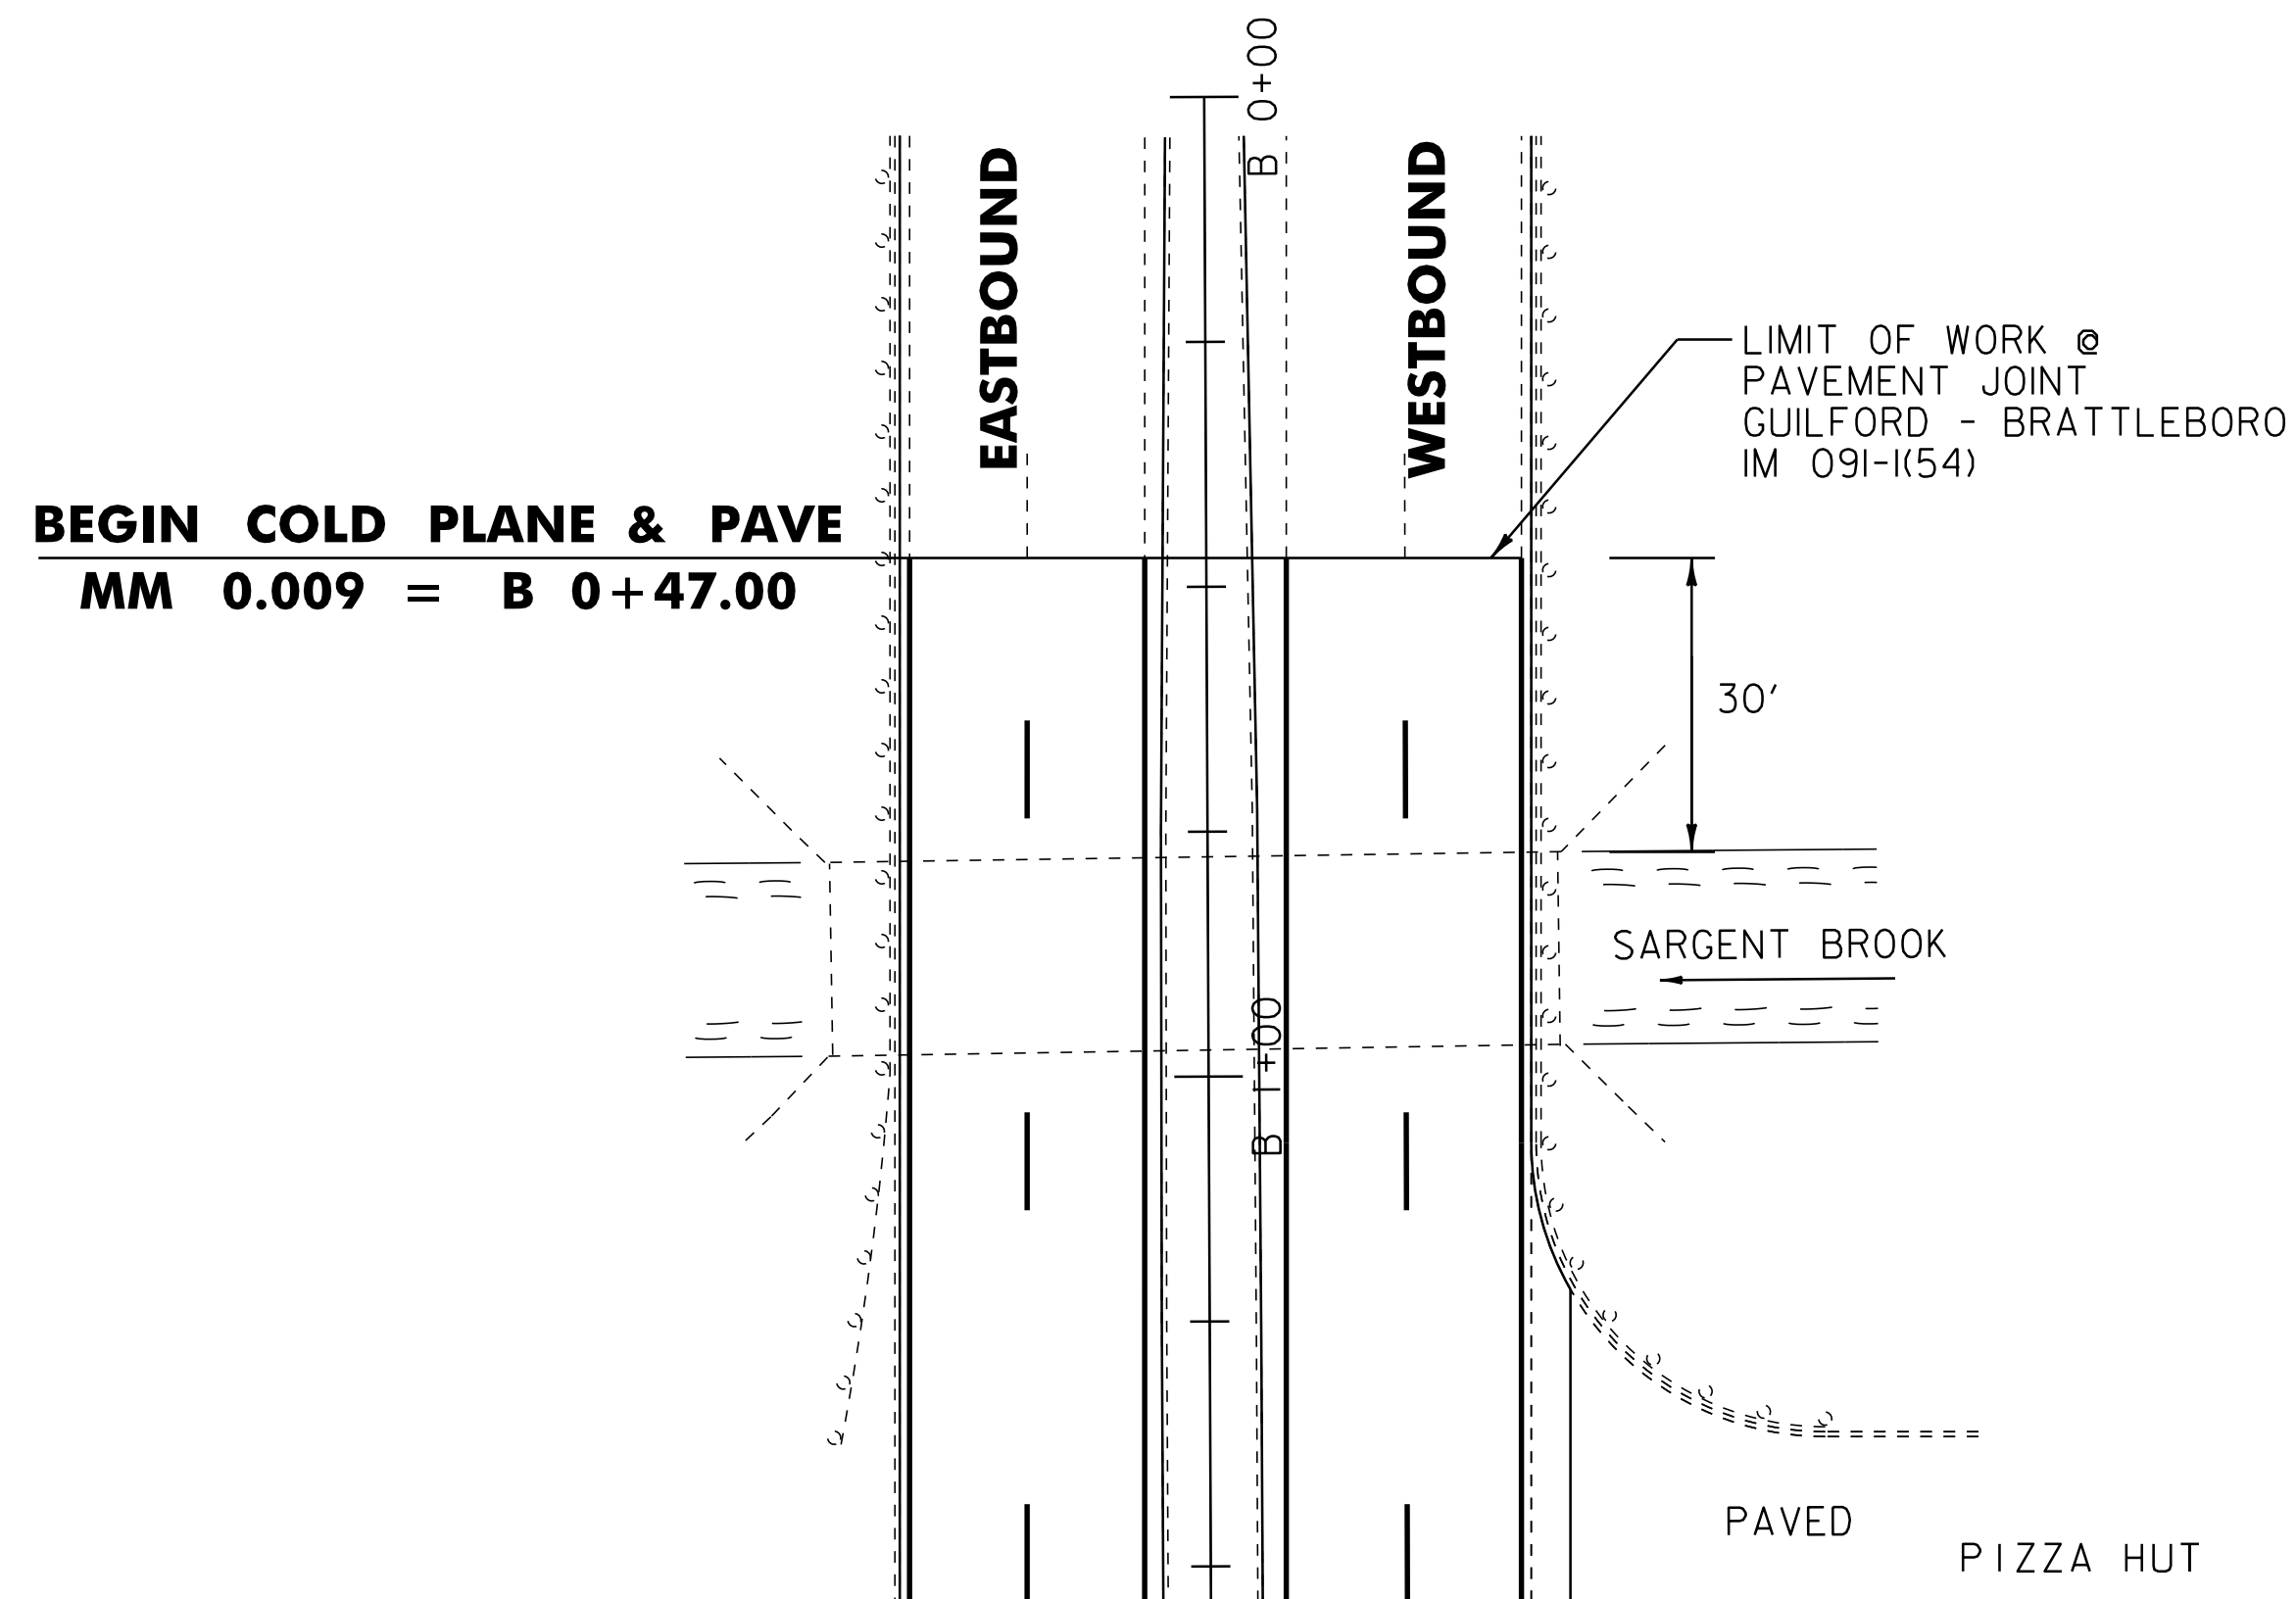

BRATTLEBORO STATE HIGHWAY

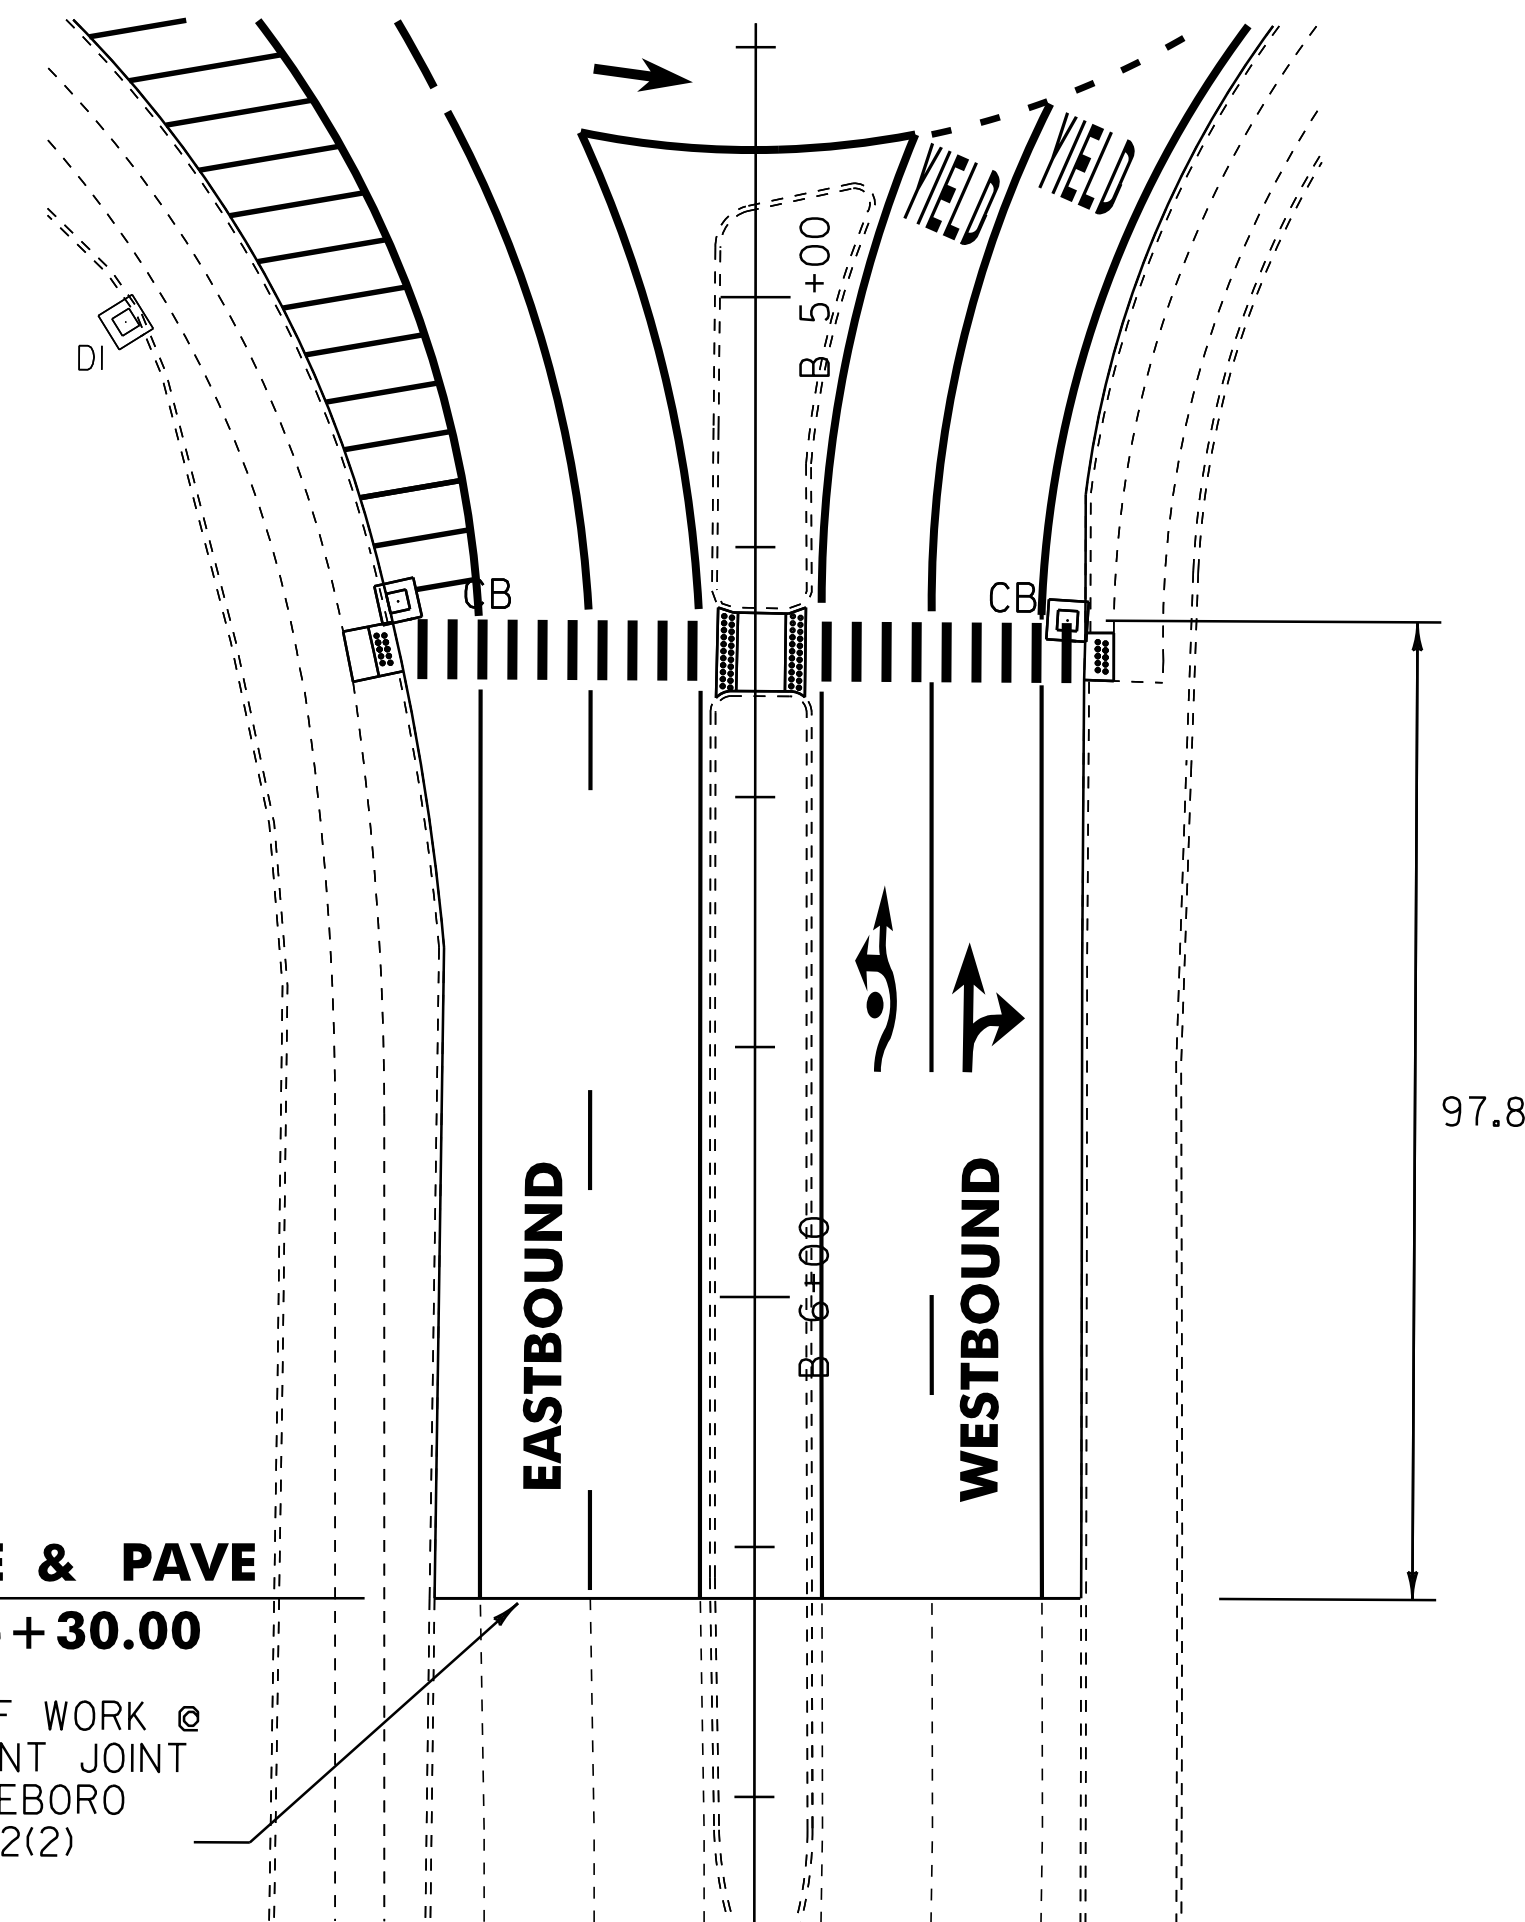

VT ROUTE 9

NOT TO SCALE

TIE SHEET

PROJECT NAME: BRATTLEBORO-PUTNEY	PLOT DATE: 02-MAY-2012 17:2
PROJECT NUMBER: STP 2310(1)	DRAWN BY: WWG
FILE NAME: /pave/01c032/pc032	CHECKED BY: NLL/PTS
PROJECT LEADER: PTS	SHEET 3 OF 118
DESIGNED BY: NLL	
IPARM FILE NAME: 01C032_03	