

TEMPORARY 4" WHITE LINE, PAINT
 DURABLE 64" WHITE LINE, THERMOPLASTIC RECESSED POLYUREA
 161+50 TO 164+77 SOLID LT
 161+50 TO 165+20 SOLID RT
 165+20 TO 165+45 SOLID RT (TH 355)
 165+59 TO 167+00 SOLID LT
 165+67 TO 165+71 SOLID RT (TH 355)
 165+71 TO 167+00 SOLID RT

TEMPORARY 4" YELLOW LINE, PAINT
 DURABLE 64" YELLOW LINE, THERMOPLASTIC RECESSED POLYUREA
 161+50 TO 164+95 SOLID LT & RT
 165+55 DOUBLE SOLID RT (TH 355)
 165+74 TO 167+00 SOLID LT & RT

TEMPORARY 24" STOP BAR, PAINT
 DURABLE 24" STOP BAR, THERMOPLASTIC
 165+05 TO 165+18 LT (TH 350)
 165+55 TO 165+66 RT (TH 355)

TEMPORARY LETTER OR SYMBOL, PAINT
 DURABLE LETTER OR SYMBOL, THERMOPLASTIC
 165+11 LT - STOP (TH 350)
 165+60 RT - STOP (TH 355)

TEMPORARY CROSSWALK MARKING, PAINT
 DURABLE CROSSWALK MARKING, THERMOPLASTIC
 165+06 TO 165+28 LT

DETECTABLE WARNING SURFACE (DWS)
 165+04 LT
 165+30 LT

PORTLAND CEMENT CONCRETE SIDEWALK, 5 INCH
 164+98 TO 165+04 LT (CONCRETE LANDING)
 165+30 TO 165+35 LT (CONCRETE LANDING)

REHAB. DROP INLETS, CATCH BASINS, OR MANHOLES, CLASS I, II, OR III
 163+28 RT (DI)
 164+87 RT (CB)
 164+95 LT (CB)
 166+98 RT (DI) CHANGED ELEVATION OF DI (SEE NOTE BELOW)

ADJUST ELEVATION OF VALVE BOX (NON PART.) (TO BE ADJUSTED BY OWNER)
 165+11 LT (TH 350)
 165+14 LT (TH 350) (BEYOND LIMITS)
 165+45 LT
 165+48 LT


CHANGING ELEVATION OF SEWER MANHOLES (NON PART.) (TO BE ADJUSTED BY OWNER)
 165+22 LT (TH 350)
 165+22 RT
 166+36 RT

~~THINNING AND TRIMMING FOR SIGNS (SEE DETAIL ON SHEET 6)~~
~~165+36 LT (TH 350)~~

BITUMINOUS CONCRETE GUTTERS AND TRAFFIC ISLANDS
 161+50 TO 165+17 RT
 159+50 25

REMOVING SIGNS AS SHOWN - 11

ERECTING SALVAGED SIGNS AS SHOWN - 5

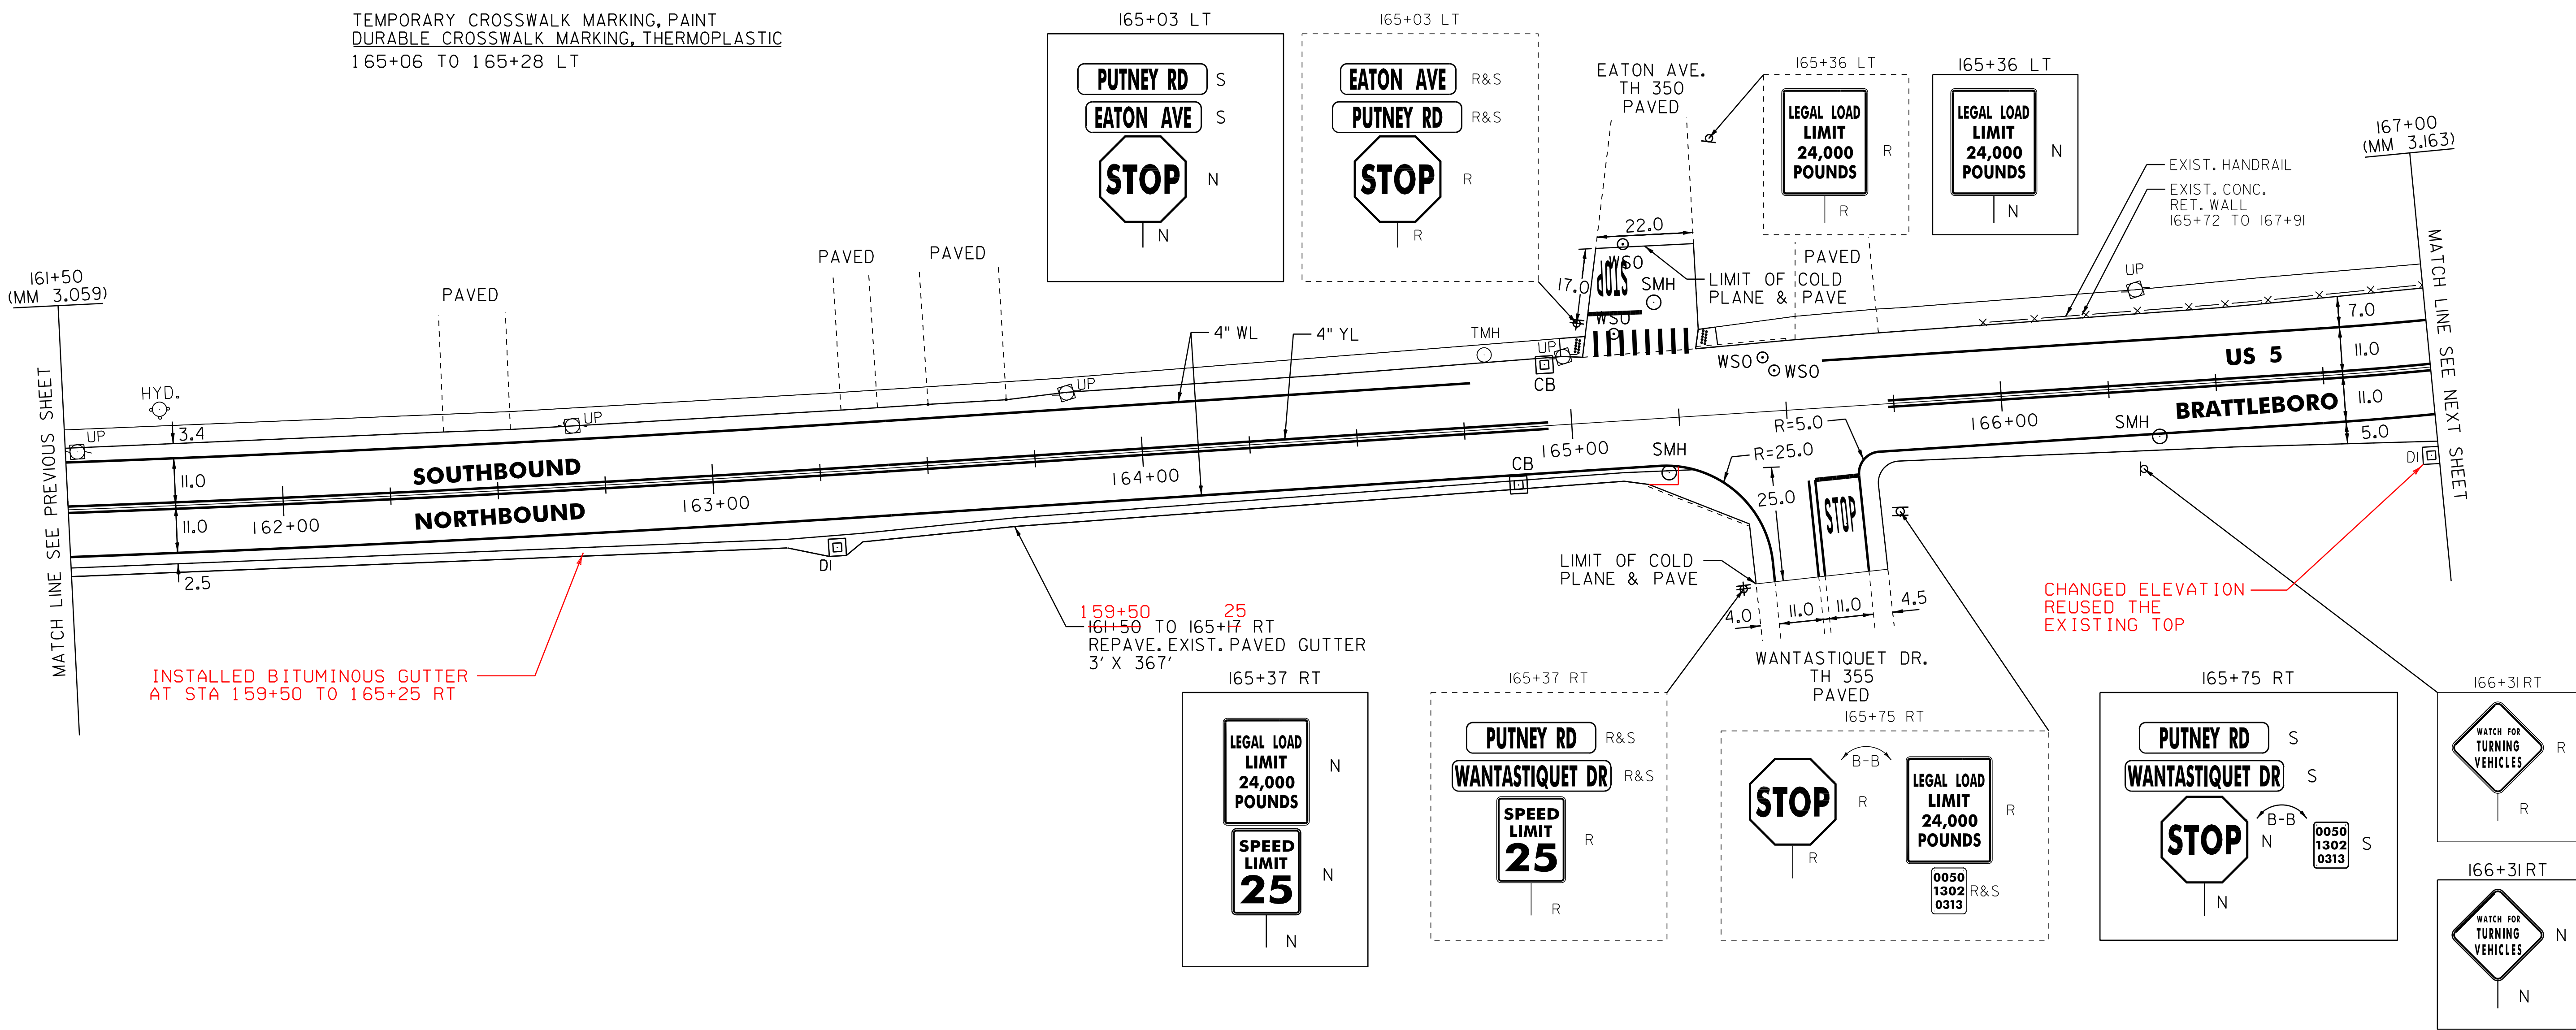

NOT TO SCALE

- LEGEND**
- R = REMOVE EXISTING
 - S = SALVAGE
 - R&S = REMOVE AND SALVAGE
 - N = NEW
 - RET = RETAIN
 - B-B = BACK TO BACK
 - = EXISTING GUARDRAIL
 - = PROPOSED GUARDRAIL
 - YL = YELLOW LINE
 - WL = WHITE LINE
 - = DELINEATOR

ROADWAY LAYOUT 2 US 5

PROJECT NAME: BRATTLEBORO-PUTNEY
 PROJECT NUMBER: STP 2310(I)

FILE NAME: /pave/01c032/pc032
 PROJECT LEADER: PTS
 DESIGNED BY: NLL
 IPARM FILE NAME: OIC032.23

PLOT DATE: 02-MAY-2012 17:22
 DRAWN BY: WWG
 CHECKED BY: NLL/PTS
 SHEET 23 OF 118