

TEMPORARY 4" WHITE LINE, PAINT  
 DURABLE 4" WHITE LINE, THERMOPLASTIC  
 167+00 TO 172+50 SOLID LT & RT

TEMPORARY 4" YELLOW LINE, PAINT  
 DURABLE 4" YELLOW LINE, THERMOPLASTIC  
 167+00 TO 172+50 SOLID LT & RT

REHAB. DROP INLETS, CATCH BASINS,  
 OR MANHOLES, CLASS I, II, OR III  
 167+03 LT (CB)  
 168+53 LT (CB)  
 170+02 LT (CB)

REMOVAL AND DISPOSAL OF GUARDRAIL  
 169+57 TO 170+07 RT


STEEL BEAM GUARDRAIL, GALVANIZED  
 169+57 TO 170+07 RT

ANCHOR FOR STEEL BEAM RAIL  
 169+57 RT

~~DELINEATOR WITH STEEL POST~~  
 169+57 RT

REMOVE AND RESET GUARDRAIL  
 169+92.5 TO 170+05 LT

REMOVING SIGNS  
 AS SHOWN - 1

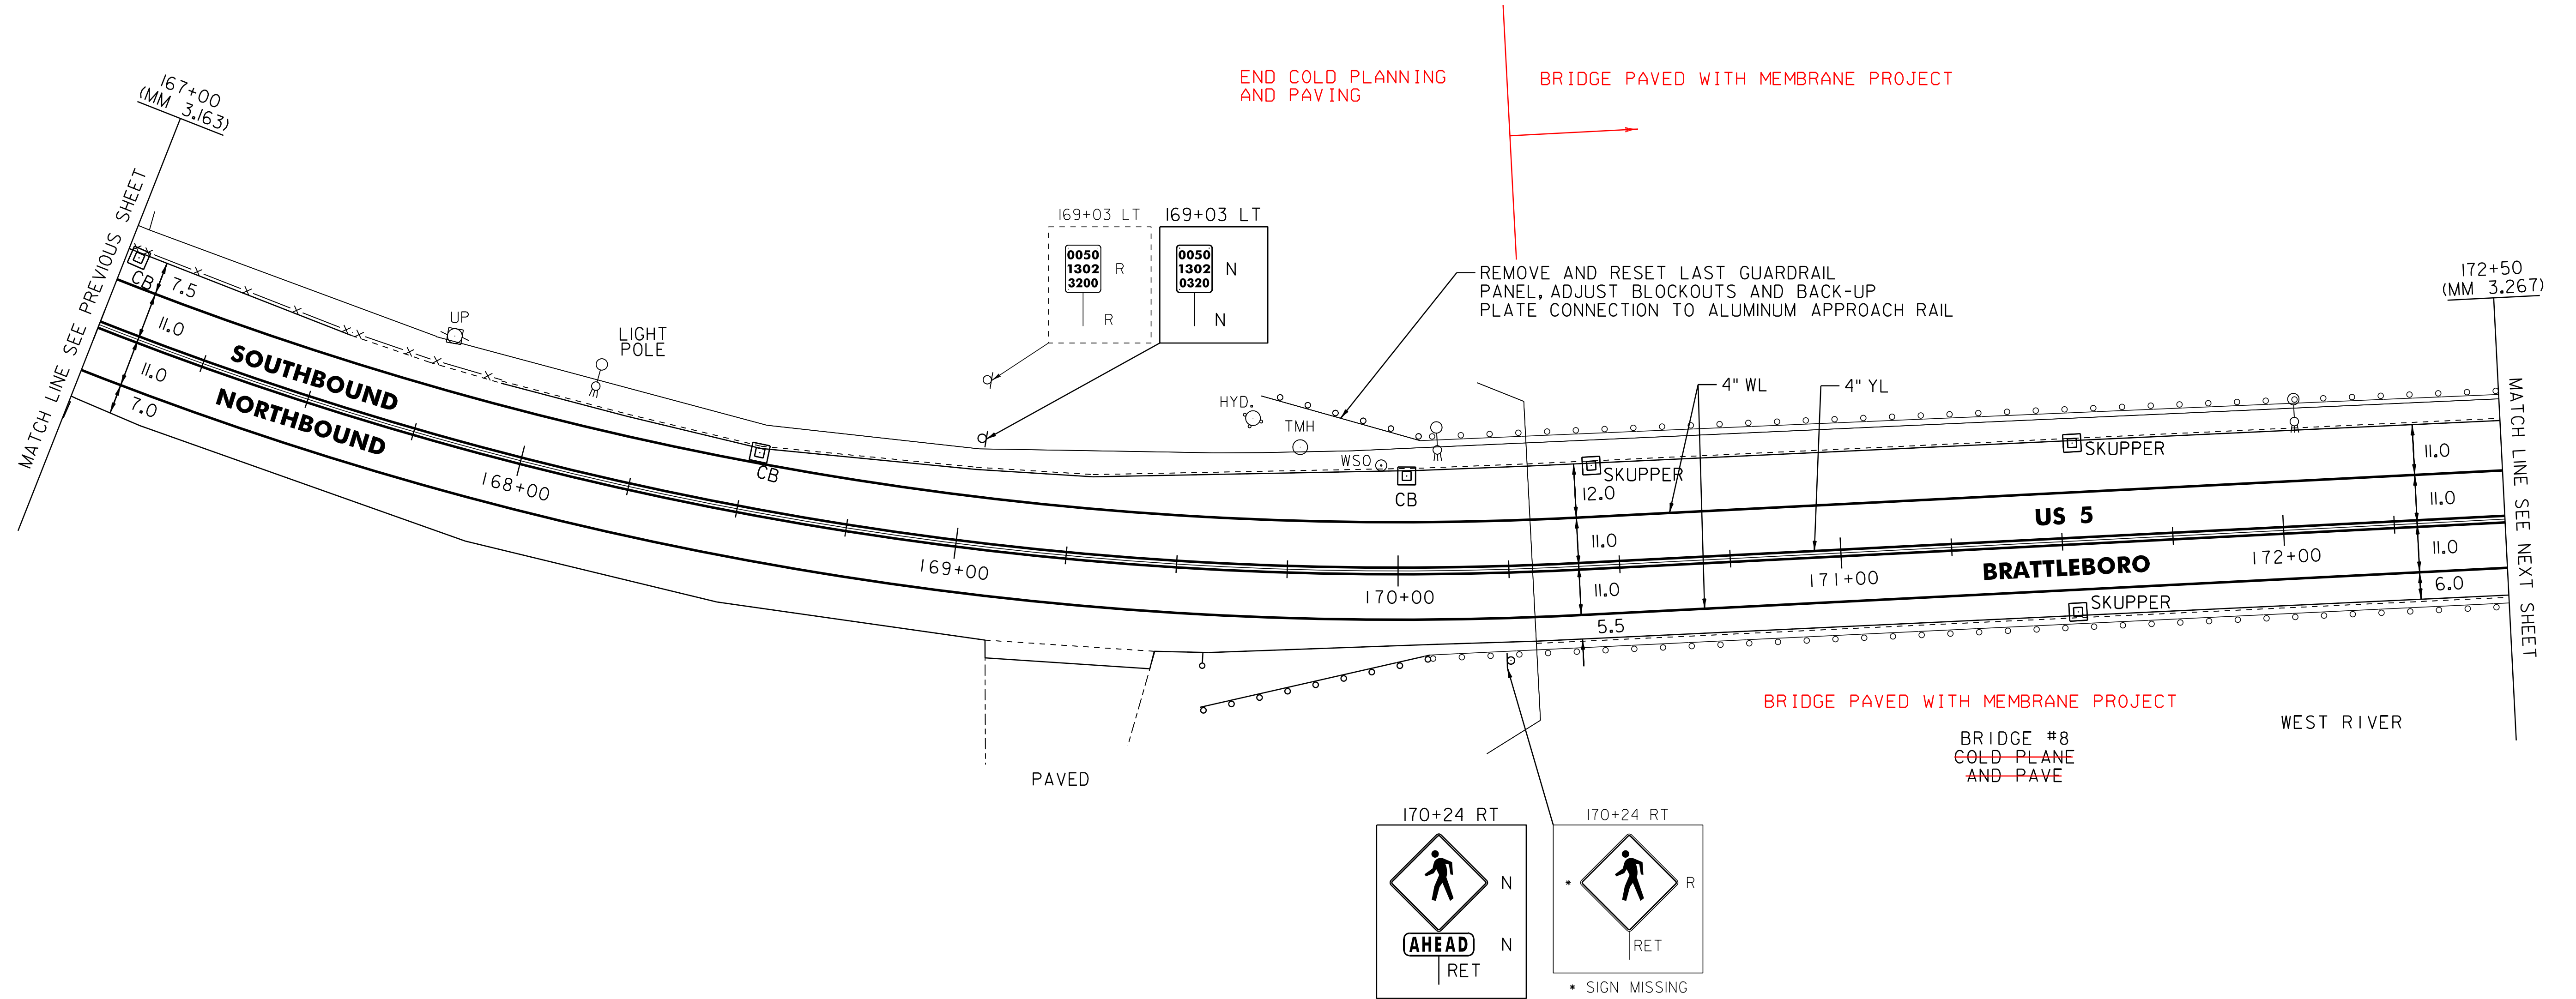

NOT TO SCALE

- LEGEND**
- R = REMOVE EXISTING
  - S = SALVAGE
  - R&S = REMOVE AND SALVAGE
  - N = NEW
  - RET = RETAIN
  - B-B = BACK TO BACK
  - - - = EXISTING GUARDRAIL
  - o — = PROPOSED GUARDRAIL
  - YL = YELLOW LINE
  - WL = WHITE LINE
  - o = DELINEATOR

**ROADWAY LAYOUT 3 US 5**

PROJECT NAME: BRATTLEBORO-PUTNEY	FILE NAME: /pave/01c032/pc032	PLOT DATE: 02-MAY-2012 17:2
PROJECT NUMBER: STP 2310(I)	PROJECT LEADER: PTS	DRAWN BY: WWG
	DESIGNED BY: NLL	CHECKED BY: NLL/PTS
	IPARM FILE NAME: 01C032.24	SHEET 24 OF 118