

TEMPORARY 4" WHITE LINE, PAINT
 DURABLE 6" WHITE LINE, THERMOPLASTIC POLYUREA
 172+50 TO 178+00 SOLID LT & RT

TEMPORARY 4" YELLOW LINE, PAINT
 DURABLE 6" YELLOW LINE, THERMOPLASTIC POLYUREA
 172+50 TO 178+00 SOLID LT & RT

RECESSED PORTLAND CEMENT CONCRETE
 SIDEWALK, 5 INCH
 174+85 TO 174+90 LT (LANDING)

RECESSED DETECTABLE WARNING
 SURFACE (DWS)
 174+90 LT

REHAB. DROP INLETS, CATCH BASINS,
 OR MANHOLES, CLASS I, II, OR III
 174+53 LT (CB)

REMOVING SIGNS
 AS SHOWN - 3


ADJUST ELEVATION
 OF VALVE BOX (NON PART.)
 (TO BE ADJUSTED BY OWNER)
 176+89 LT (BEYOND LIMITS)

REMOVAL AND DISPOSAL OF GUARDRAIL
 174+08 TO 174+58 LT
 174+08 TO 174+83 RT

STEEL BEAM GUARDRAIL, GALVANIZED
 174+08 TO 174+58 LT
 174+08 TO 174+83 RT

ANCHOR FOR STEEL BEAM RAIL
 174+58 LT
 174+83 RT

DELINEATOR WITH STEEL POST
 174+58 LT
 174+83 RT

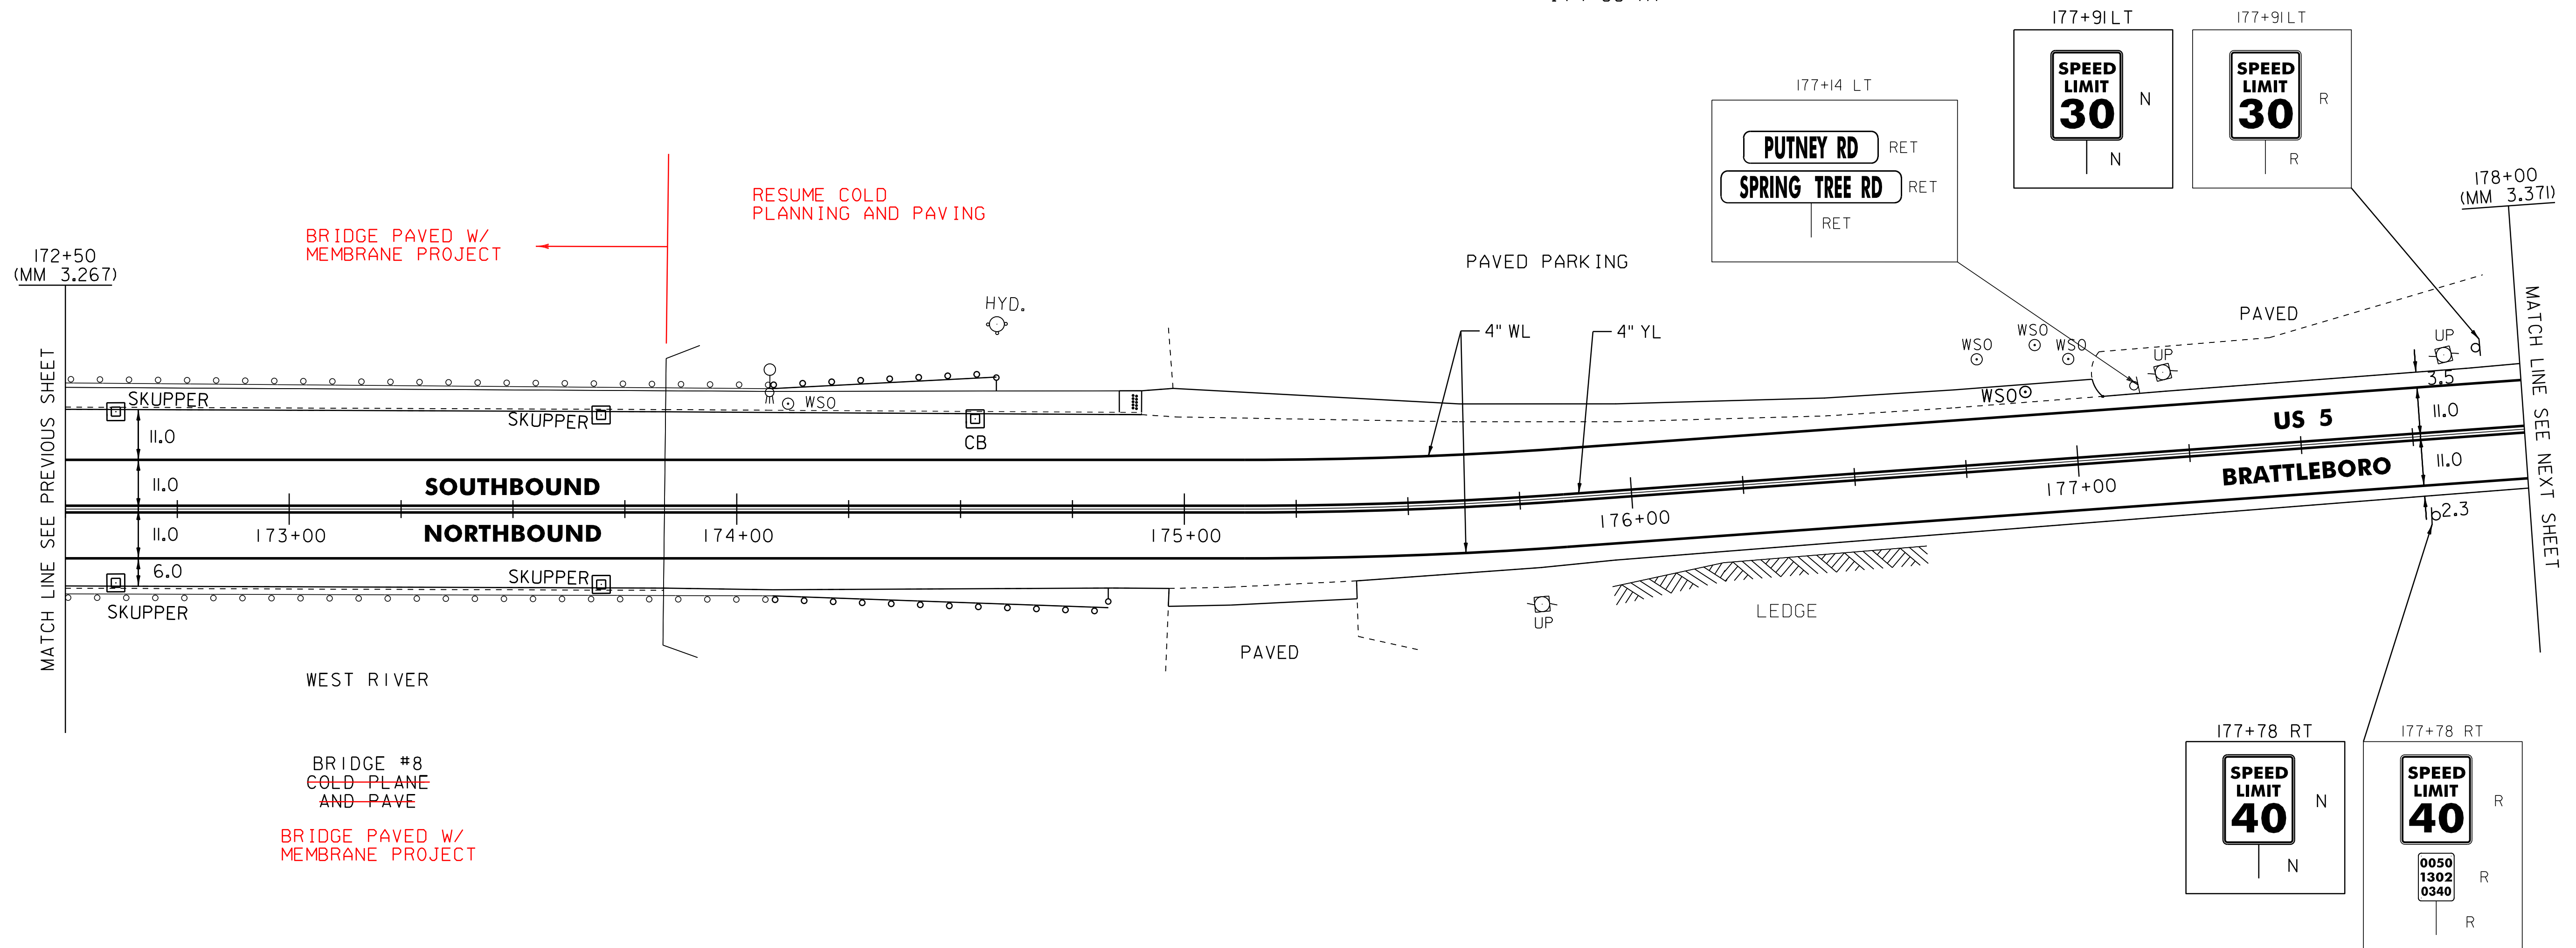

BRIDGE #8
 COLD PLANE
 AND PAVE
 BRIDGE PAVED W/
 MEMBRANE PROJECT

RESUME COLD
 PLANNING AND PAVING

BRIDGE PAVED W/
 MEMBRANE PROJECT

LEGEND

- R = REMOVE EXISTING
- S = SALVAGE
- R&S = REMOVE AND SALVAGE
- N = NEW
- RET = RETAIN
- B-B = BACK TO BACK
- = EXISTING GUARDRAIL
- = PROPOSED GUARDRAIL
- YL = YELLOW LINE
- WL = WHITE LINE
- ⊙ = DELINEATOR

ROADWAY LAYOUT 4 US 5

PROJECT NAME: BRATTLEBORO-PUTNEY	FILE NAME: /pave/01c032/pc032	PLOT DATE: 02-MAY-2012 17:2
PROJECT NUMBER: STP 2310(I)	PROJECT LEADER: PTS	DRAWN BY: WWG
	DESIGNED BY: NLL	CHECKED BY: NLL/PTS
	IPARM FILE NAME: 01C032.25	SHEET 25 OF 118

NOT TO SCALE