


TEMPORARY 4" WHITE LINE, PAINT  
 DURABLE 64" WHITE LINE, THERMOPLASTIC RECESSED POLYUREA  
 183+75 TO 189+00 SOLID LT & RT

TEMPORARY 4" YELLOW LINE, PAINT  
 DURABLE 64" YELLOW LINE, THERMOPLASTIC RECESSED POLYUREA  
 183+75 TO 189+00 SOLID LT & RT

STONE FILL, TYPE II  
 183+75 TO 185+83 RT

REMOVING SIGNS  
 AS SHOWN - 1

BITUMINOUS CONCRETE GUTTER  
 AND TRAFFIC ISLAND  
 183+75 TO 185+83 RT

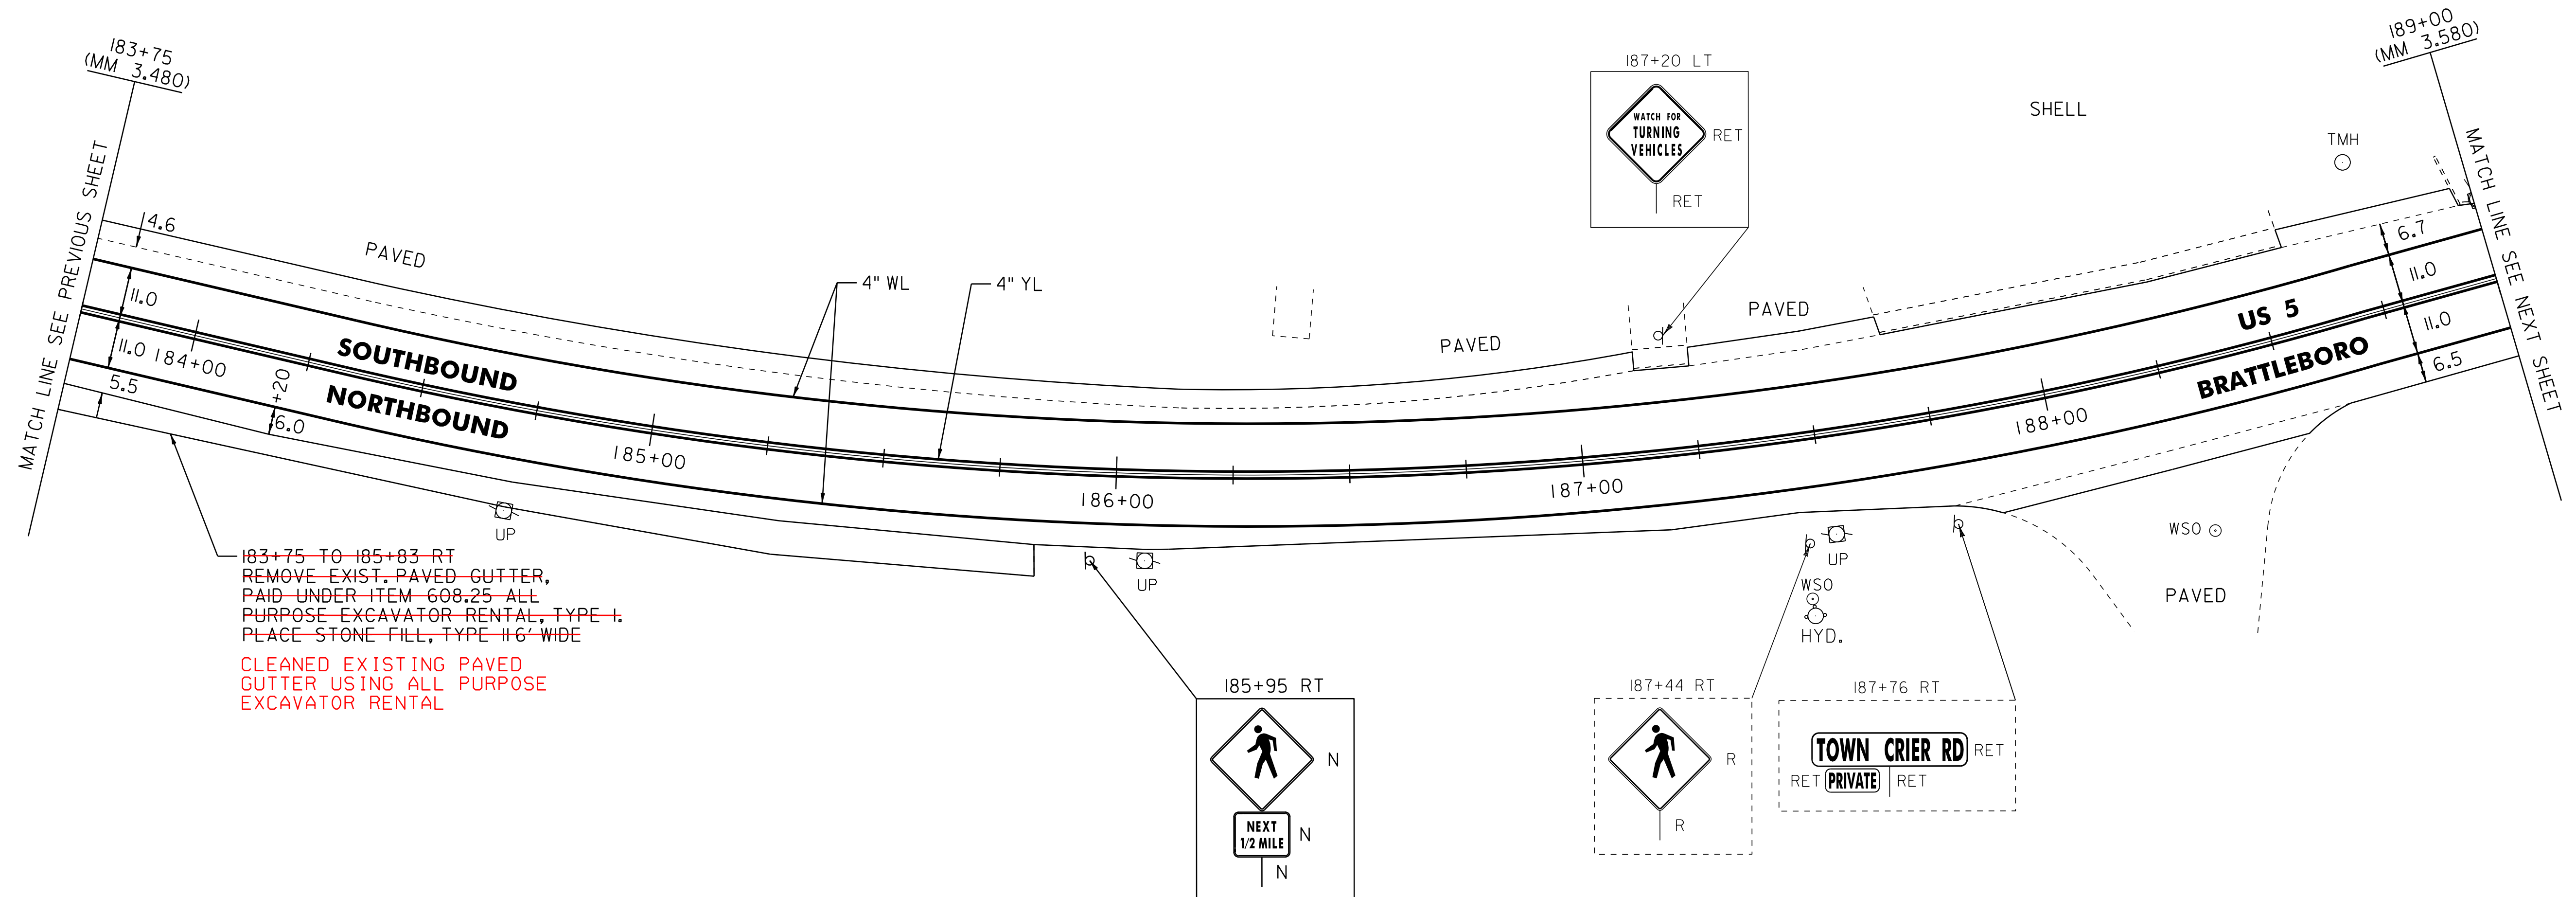

183+75 TO 185+83 RT  
 REMOVE EXIST. PAVED GUTTER,  
 PAID UNDER ITEM 608.25 ALL  
 PURPOSE EXCAVATOR RENTAL, TYPE I.  
 PLACE STONE FILL, TYPE II 6' WIDE  
 CLEANED EXISTING PAVED  
 GUTTER USING ALL PURPOSE  
 EXCAVATOR RENTAL

LEGEND

- R = REMOVE EXISTING
- S = SALVAGE
- R&S = REMOVE AND SALVAGE
- N = NEW
- RET = RETAIN
- B-B = BACK TO BACK
- = EXISTING GUARDRAIL
- = PROPOSED GUARDRAIL
- YL = YELLOW LINE
- WL = WHITE LINE
- = DELINEATOR

ROADWAY LAYOUT 6 US 5

PROJECT NAME: BRATTLEBORO-PUTNEY  
 PROJECT NUMBER: STP 2310(I)

FILE NAME: /pave/01c032/pc032  
 PROJECT LEADER: PTS  
 DESIGNED BY: NLL  
 IPARM FILE NAME: OIC032.27  
 PLOT DATE: 02-MAY-2012 17:2  
 DRAWN BY: WWG  
 CHECKED BY: NLL/PTS  
 SHEET 27 OF 118

NOT TO SCALE