

TEMPORARY 4" WHITE LINE, PAINT  
 DURABLE 6 INCH WHITE LINE, RECESSED POLYUREA  
 194+00 TO 199+50 SOLID LT & RT (BIKE LANE)  
 196+89 TO 199+50 SOLID LT  
 198+62 TO 199+50 SOLID RT

TEMPORARY 4" YELLOW LINE, PAINT  
 DURABLE 6 INCH YELLOW LINE, RECESSED POLYUREA  
 194+00 TO 199+50 SOLID LT & RT


DURABLE 8" WHITE LINE, THERMOPLASTIC  
 199+31 TO 199+50 SOLID RT (DIAGONALS)

TEMPORARY LETTER OR SYMBOL, PAINT  
 DURABLE LETTER OR SYMBOL, THERMOPLASTIC  
 197+42 RT - SIGNAL  
 197+82 RT - AHEAD

CHANGING ELEVATION  
 OF SEWER MANHOLES (NON PART.)  
 (TO BE ADJUSTED BY OWNER)  
 196+09 RT  
 198+57 RT  
 199+21 LT

REMOVING SIGNS  
 AS SHOWN - 5

~~STONE FILL, TYPE 1~~  
~~196+00 LT~~

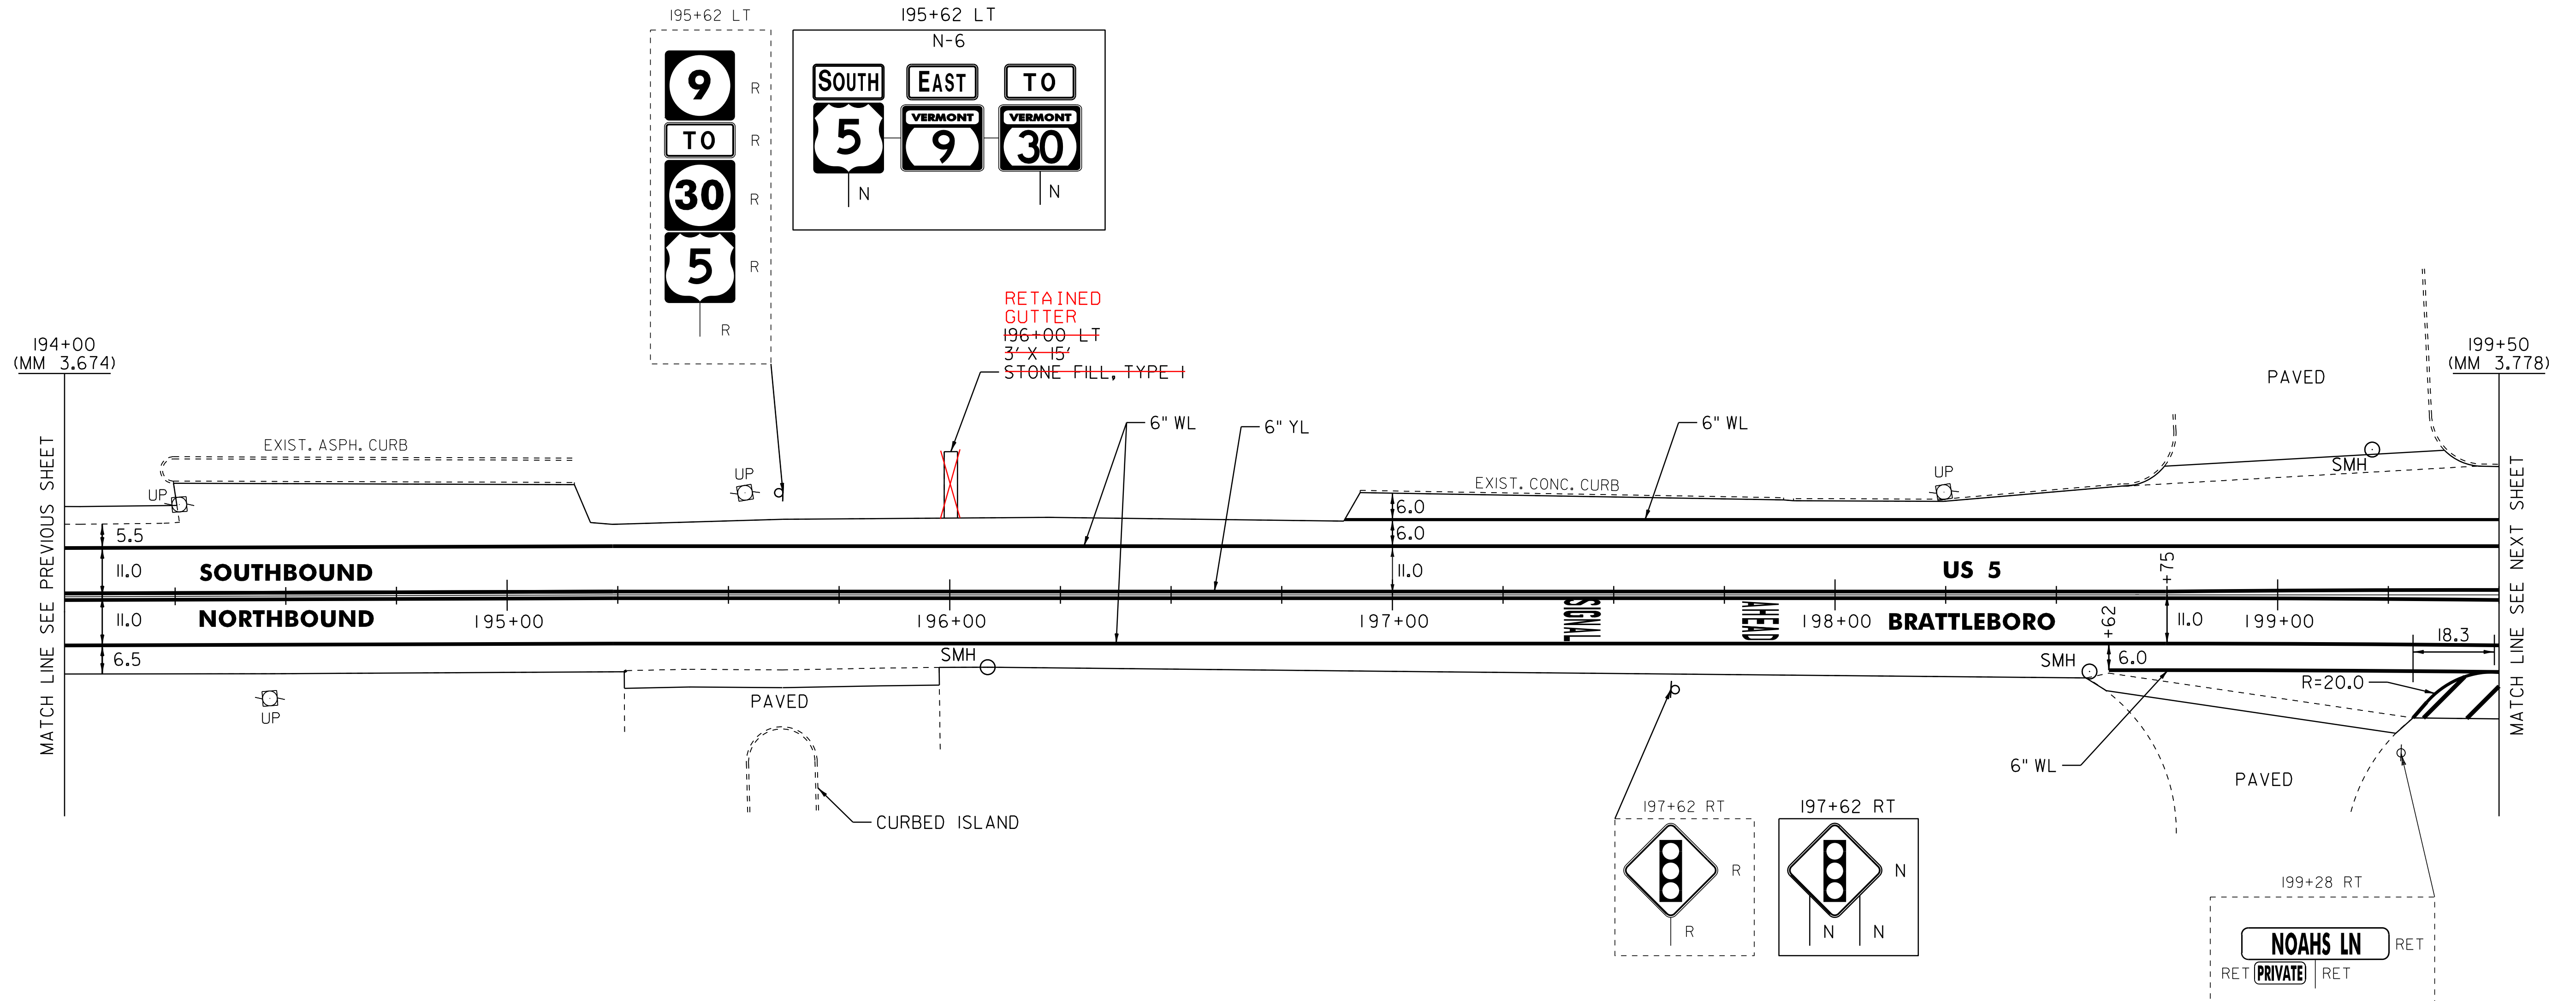

LEGEND

- R = REMOVE EXISTING
- S = SALVAGE
- R&S = REMOVE AND SALVAGE
- N = NEW
- RET = RETAIN
- B-B = BACK TO BACK
- = EXISTING GUARDRAIL
- = PROPOSED GUARDRAIL
- YL = YELLOW LINE
- WL = WHITE LINE
- ⊙ = DELINEATOR

ROADWAY LAYOUT 8 US 5

PROJECT NAME: BRATTLEBORO-PUTNEY	FILE NAME: /pave/01c032/pc032	PLOT DATE: 02-MAY-2012 17:2
PROJECT NUMBER: STP 2310(I)	PROJECT LEADER: PTS	DRAWN BY: WWG
	DESIGNED BY: NLL	CHECKED BY: NLL/PTS
	IPARM FILE NAME: 01C032.29	SHEET 29 OF 118

NOT TO SCALE