

TEMPORARY 4" WHITE LINE, PAINT
 DURABLE 4" WHITE LINE, THERMOPLASTIC
 205+18 TO 205+49 SOLID LT (STAPLES PLAZA)
 205+64 SOLID LT (STAPLES PLAZA) (LANE LINE)
 206+03 TO 206+13 SOLID LT (STAPLES PLAZA)
 208+21 TO 208+41 SOLID LT (TH 82)
 208+68 TO 209+22 SOLID RT
 208+83 TO 209+24 SOLID LT (TH 82)

TEMPORARY 4" YELLOW LINE, PAINT
 DURABLE 4" YELLOW LINE, THERMOPLASTIC
 205+77 DOUBLE SOLID LT (STAPLES PLAZA)
 208+57 TO 208+65 DOUBLE SOLID RT
 208+59 TO 208+60 DOUBLE SOLID LT (TH 82)

DURABLE 8" WHITE LINE, THERMOPLASTIC
 205+94 TO 207+39 SOLID RT (DIAGONALS)
 206+18 TO 208+21 SOLID LT (DIAGONALS)

DURABLE 8" YELLOW LINE, THERMOPLASTIC
 208+91 TO 210+00 SOLID RT (GORE)

TEMPORARY 21" WHITE LINE, PAINT
 DURABLE 6 INCH WHITE LINE, RECESSED POLYUREA
 204+50 TO 205+18 SOLID LT
 204+50 TO 205+25 SOLID LT (BIKE LANE)
 204+50 TO 205+25 SOLID RT (LANE LINE)
 204+50 TO 205+25 SOLID RT (BIKE LANE)
 204+50 TO 205+25 SOLID RT (BIKE LANE)
 204+50 TO 205+25 SOLID RT
 206+29 TO 207+49 SOLID LT (BIKE LANE)
 206+29 TO 207+49 SOLID LT (BIKE LANE)
 206+29 TO 207+49 SOLID LT (LANE LINE)
 206+29 TO 206+54 SOLID RT (BIKE LANE)
 206+54 TO 207+38 DOTTED RT (BIKE LANE)
 206+54 TO 207+38 DOTTED RT (BIKE LANE)
 207+38 TO 208+39 SOLID RT (BIKE LANE)
 207+38 TO 208+39 SOLID RT (BIKE LANE)
 207+49 TO 208+21 DOTTED LT (LANE LINE)
 207+49 TO 208+21 DOTTED LT (LANE LINE)
 207+49 TO 208+38 DOTTED LT (LANE LINE)
 209+21 TO 210+00 SOLID RT (BIKE LANE)
 209+24 TO 210+00 SOLID LT (BIKE LANE)
 209+52 TO 210+00 SOLID RT (BIKE LANE)
 209+85 TO 210+00 SOLID LT (BIKE LANE)

TEMPORARY 4" YELLOW LINE, PAINT
 DURABLE 6 INCH YELLOW LINE, RECESSED POLYUREA
 204+50 TO 205+25 DOUBLE SOLID LT
 205+94 TO 208+41 SOLID RT
 206+13 TO 208+21 SOLID LT
 206+29 TO 207+81 DOUBLE SOLID RT
 207+81 TO 208+38 DOUBLE SOLID RT
 207+81 TO 208+38 DOUBLE SOLID RT
 208+91 TO 210+00 DOUBLE SOLID CL
 208+91 TO 210+00 DOUBLE SOLID RT

TEMPORARY LETTER OR SYMBOL, PAINT
 204+57 LT - BIKE
 205+04 RT - BIKE
 205+15 RT - LEFT TURN ARROW
 205+15 RT - RIGHT TURN ARROW
 205+16 RT - BIKE ARROW
 205+57 LT - RIGHT TURN ARROW
 205+70 LT - LEFT TURN/THRU ARROW
 206+39 LT - RIGHT TURN ARROW
 206+39 RT - LEFT TURN ARROW
 206+86 LT - BIKE ARROW
 206+98 LT - BIKE
 207+44 LT - RIGHT TURN ARROW
 207+44 RT - LEFT TURN ARROW
 208+06 RT - RIGHT TURN ARROW
 208+50 LT - STOP (TECHNOLOGY DR)
 208+68 RT - STOP (ADVANCED AUTO PARTS)
 209+55 RT - BIKE
 209+67 RT - BIKE ARROW

REHAB. DROP INLETS, CATCH BASINS,
 OR MANHOLES, CLASS I, II, OR III

204+74 RT (CB)
 206+00 RT (CB)
 208+68 RT (CB)
 208+80 LT (CB) (TH 82)
 208+93 LT (CB)
 208+00 LT (CB)
 208+50 LT (CB)
 208+50 RT (CB)

CHANGING ELEVATION
 OF SEWER MANHOLES (NON PART.)
 (TO BE ADJUSTED BY OWNER)
 206+72 RT

DURABLE LETTER OR SYMBOL, THERMOPLASTIC
 204+57 LT - BIKE
 205+04 RT - BIKE
 205+15 RT - LEFT TURN ARROW
 205+15 RT - RIGHT TURN ARROW
 205+16 RT - BIKE ARROW
 205+57 LT - RIGHT TURN ARROW
 206+39 LT - RIGHT TURN ARROW
 206+39 RT - LEFT TURN ARROW
 205+70 LT - LEFT TURN/THRU ARROW
 206+86 LT - BIKE ARROW
 206+89 RT - ONLY
 206+91 LT - ONLY
 206+98 LT - BIKE
 207+44 LT - RIGHT TURN ARROW
 207+44 RT - LEFT TURN ARROW
 207+67 RT - ONLY
 208+06 RT - RIGHT TURN ARROW
 208+50 LT - STOP (TECHNOLOGY DR)
 208+68 RT - STOP (ADVANCED AUTO PARTS)
 209+55 RT - BIKE
 209+67 RT - BIKE ARROW

ADJUST ELEVATION
 OF VALVE BOX (NON PART.)
 (TO BE ADJUSTED BY OWNER)
 208+57 LT (TH 82)
 208+57 LT (TH 82)
 208+57 LT (TH 82)
 208+57 LT (TH 82)

TEMPORARY 24" STOP BAR, PAINT
 DURABLE 24" STOP BAR, THERMOPLASTIC
 205+23 RT
 205+47 TO 205+76 LT (STAPLES PLAZA)
 205+64 TO 205+93 RT (ADVANCED AUTO PARTS)
 206+29 LT & RT
 208+26 TO 208+58 LT (TECHNOLOGY DR)
 208+66 TO 208+78 RT (ADVANCED AUTO PARTS)


PORTLAND CEMENT CONCRETE
 SIDEWALK, 5 INCH
 208+20 TO 208+36 RT (RAMP TYPE 6)

REMOVING AND RESETTING CURB
 208+22 TO 208+27 RT
 208+33 TO 208+36 RT

DETECTABLE WARNING
 SURFACE (DWS)
 208+30 RT

REMOVING SIGNS
 AS SHOWN - 10

ERECTING SALVAGED SIGNS
 AS SHOWN - 2

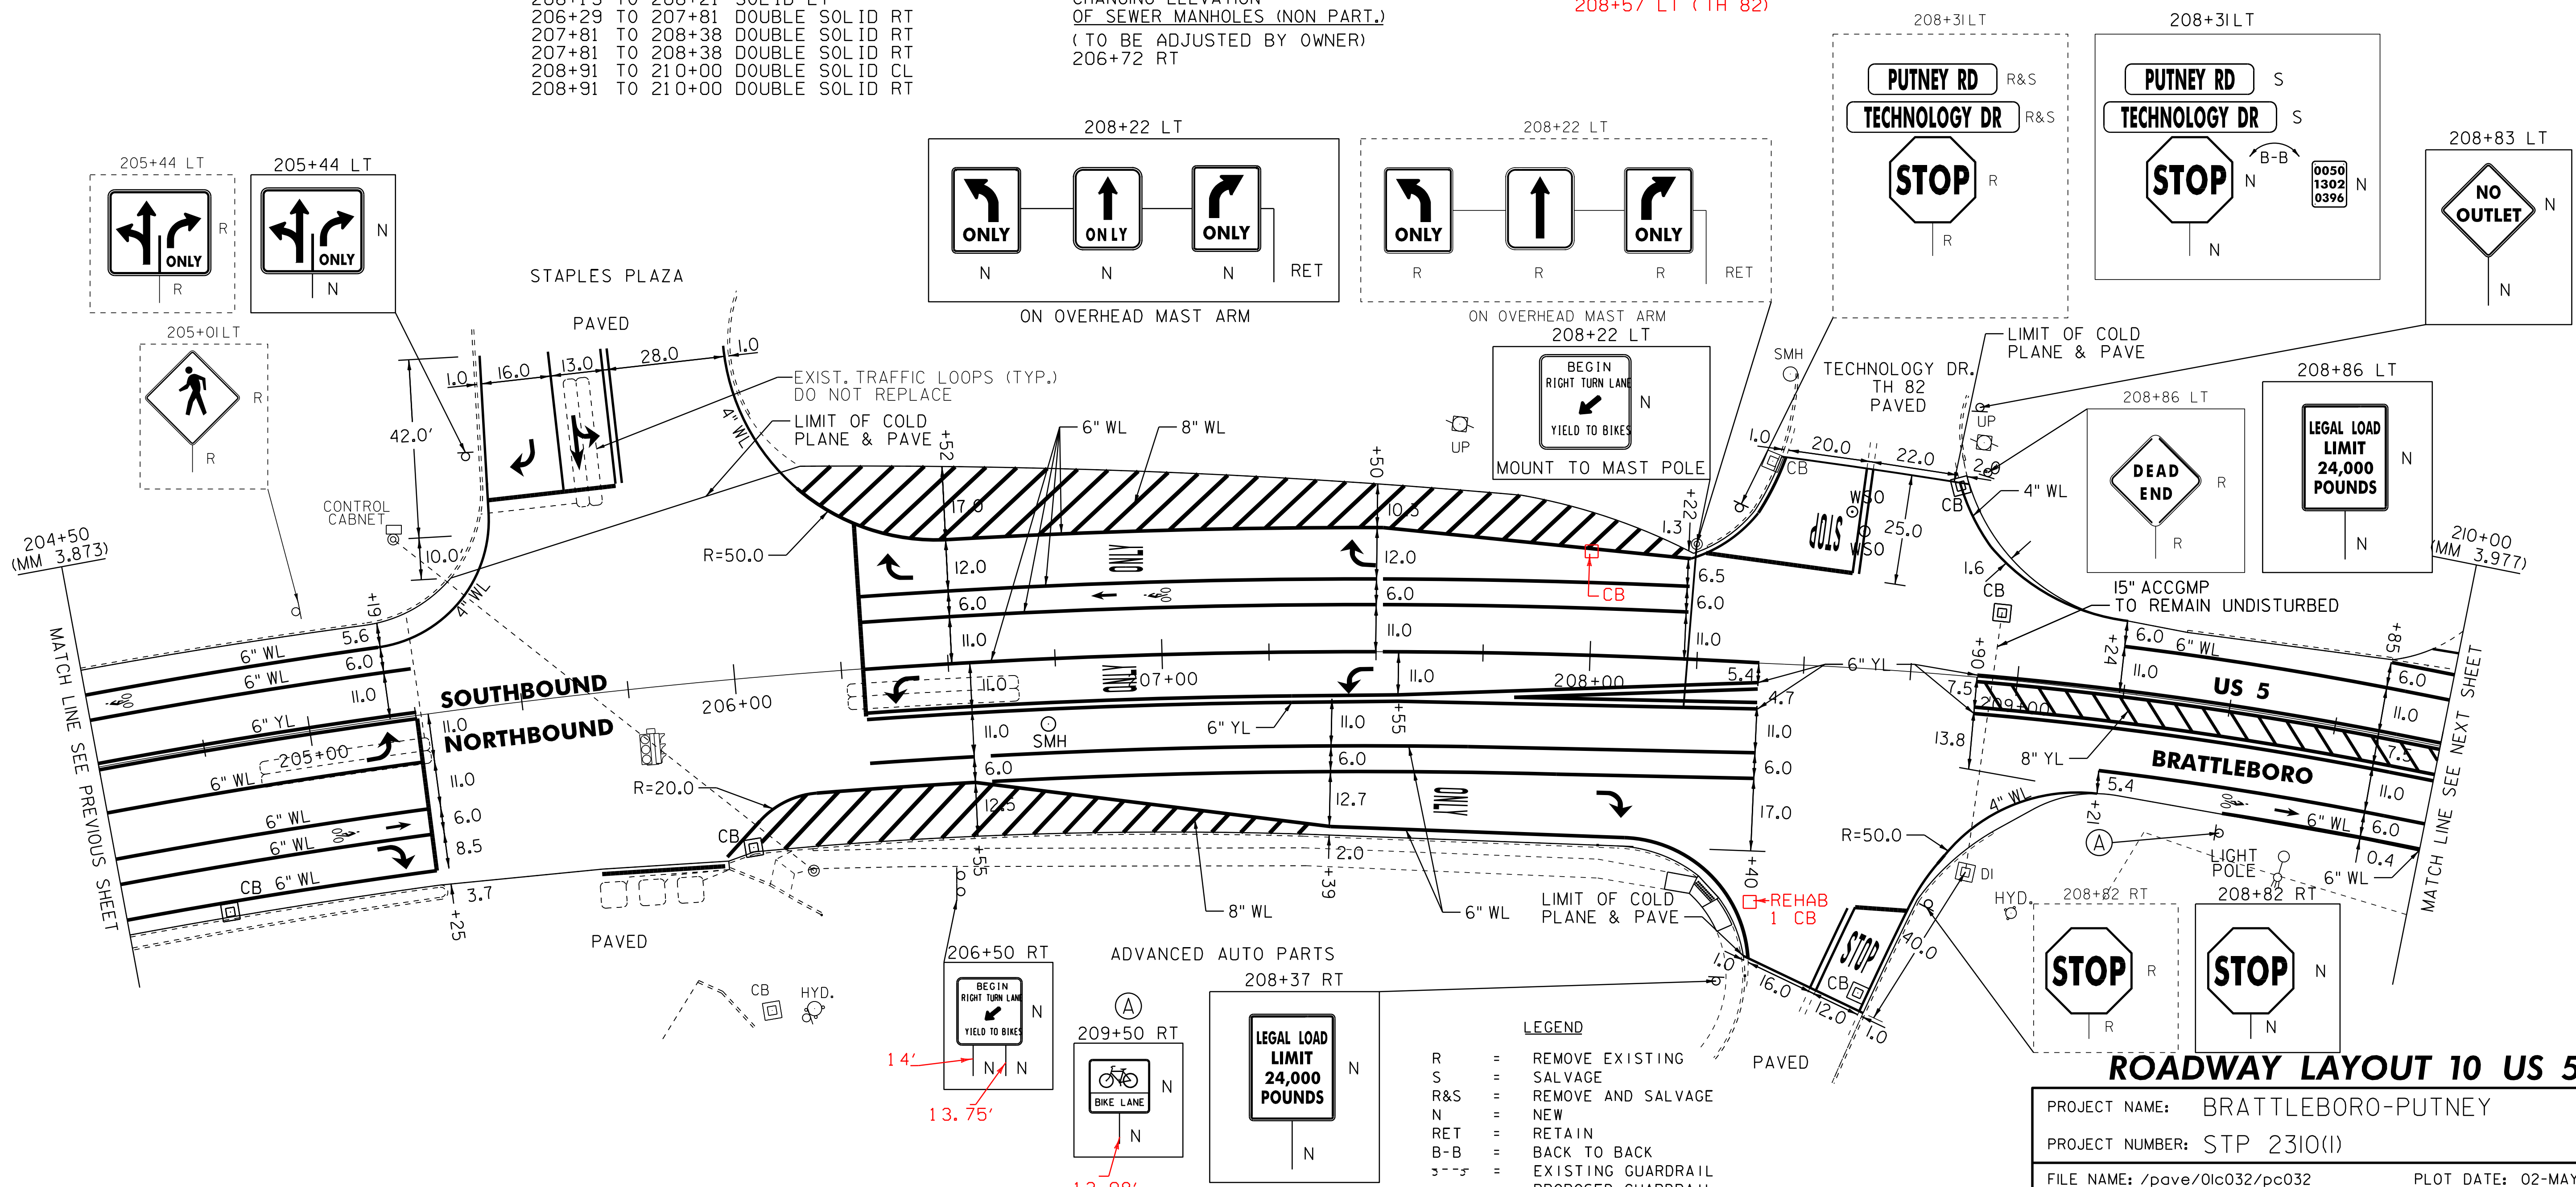

- LEGEND**
- R = REMOVE EXISTING
 - S = SALVAGE
 - R&S = REMOVE AND SALVAGE
 - N = NEW
 - RET = RETAIN
 - B-B = BACK TO BACK
 - = EXISTING GUARDRAIL
 - - - = PROPOSED GUARDRAIL
 - YL = YELLOW LINE
 - WL = WHITE LINE
 - = DELINEATOR

NOT TO SCALE

ROADWAY LAYOUT 10 US 5

PROJECT NAME: BRATTLEBORO-PUTNEY
 PROJECT NUMBER: STP 2310(I)

FILE NAME: /pave/01c032/pc032
 PROJECT LEADER: PTS
 DESIGNED BY: NLL
 IPARM FILE NAME: 01c032_31

PLOT DATE: 02-MAY-2012 17:2
 DRAWN BY: WWG
 CHECKED BY: NLL/PTS
 SHEET 31 OF 118