

TEMPORARY 4" WHITE LINE, PAINT
 DURABLE 6" INCH WHITE LINE, RECESSED POLYUREA
 215+50 TO 217+05 DOTTED LT (BIKE LANE)
 215+50 TO 217+05 DOTTED RT (BIKE LANE)
 215+50 TO 217+05 DOTTED RT (LANE LINE)
 215+50 TO 217+05 DOTTED RT (BIKE LANE)
 215+50 TO 217+05 DOTTED RT (BIKE LANE)
 215+50 TO 215+82 SOLID RT
 216+42 TO 219+05 SOLID LT
 217+02 TO 219+02 SOLID LT (BIKE LANE)
 217+04 TO 219+05 SOLID RT (LANE LINE)
 217+04 TO 219+05 SOLID RT (BIKE LANE)
 217+04 TO 219+05 SOLID RT (BIKE LANE)
 217+20 TO 219+05 SOLID RT
 219+98 TO 221+00 SOLID LT
 219+98 TO 221+00 SOLID LT (BIKE LANE)
 219+98 TO 221+00 SOLID LT (BIKE LANE)
 219+98 TO 221+00 SOLID LT (LANE LINE)
 219+98 TO 221+00 SOLID RT (BIKE LANE)
 219+98 TO 221+00 SOLID RT (BIKE LANE)


TEMPORARY 4" WHITE LINE, PAINT
 DURABLE 4" WHITE LINE, THERMOPLASTIC
 219+05 TO 219+31 SOLID LT
 219+42 SOLID LT (LANE LINE)
 219+75 TO 219+98 SOLID LT
 TEMPORARY 4" YELLOW LINE, PAINT
 DURABLE 4" YELLOW LINE, THERMOPLASTIC
 219+51 TO 219+53 SOLID LT (ISLAND)
 219+74 DOUBLE SOLID RT
 DURABLE 8" YELLOW LINE, THERMOPLASTIC
 215+50 TO 216+70 SOLID LT & RT (GORE)
 DURABLE 8" WHITE LINE, THERMOPLASTIC
 215+50 TO 215+79 SOLID RT (DIAGONALS)
 216+43 TO 219+05 SOLID LT (DIAGONALS)

TEMPORARY LETTER OR SYMBOL, PAINT
 217+49 LT - LEFT TURN ARROW
 217+49 RT - RIGHT TURN ARROW
 218+04 LT - BIKE ARROW
 218+16 LT - BIKE
 218+50 RT - BIKE
 218+62 RT - BIKE ARROW
 218+96 LT - LEFT TURN ARROW
 218+96 RT - RIGHT TURN ARROW
 219+38 LT - RIGHT TURN ARROW
 219+46 LT - LEFT TURN/THRU ARROW
 220+07 LT - RIGHT TURN ARROW
 220+07 LT - LEFT TURN ARROW
 220+39 LT - BIKE ARROW
 220+51 LT - BIKE

DURABLE LETTER OR SYMBOL, THERMOPLASTIC
 217+09 LT - ONLY
 217+09 RT - ONLY
 217+49 LT - LEFT TURN ARROW
 217+49 RT - RIGHT TURN ARROW
 218+04 LT - BIKE ARROW
 218+16 LT - BIKE
 218+50 RT - ONLY
 218+56 LT - ONLY
 218+62 RT - BIKE ARROW
 218+96 LT - LEFT TURN ARROW
 218+96 RT - RIGHT TURN ARROW
 219+38 LT - RIGHT TURN ARROW
 219+46 LT - LEFT TURN/THRU ARROW
 220+07 LT - RIGHT TURN ARROW
 220+07 LT - LEFT TURN ARROW
 220+39 LT - BIKE ARROW
 220+46 LT - ONLY
 220+46 LT - ONLY
 220+51 LT - BIKE

TEMPORARY 24" STOP BAR, PAINT
 DURABLE 24" STOP BAR, THERMOPLASTIC
 219+05 LT TO RT
 219+26 TO 219+48 LT
 219+75 TO 220+01 RT
 220+00 TO 220+01 LT
 REHAB. DROP INLETS, CATCH BASINS,
 OR MANHOLES, CLASS I, II, OR III
 216+25 RT (CB)
 216+80 LT (CB)
 219+01 RT (CB)
 220+01 RT (CB) (IN DRIVE)
 220+02 LT (CB)

TEMPORARY 4" YELLOW LINE, PAINT
 DURABLE 6" INCH YELLOW LINE, RECESSED POLYUREA
 215+50 TO 217+05 DOUBLE SOLID CL TO LT
 215+50 TO 217+05 DOUBLE SOLID RT TO LT
 217+05 TO 219+05 DOUBLE SOLID LT
 219+98 TO 221+00 DOUBLE SOLID RT

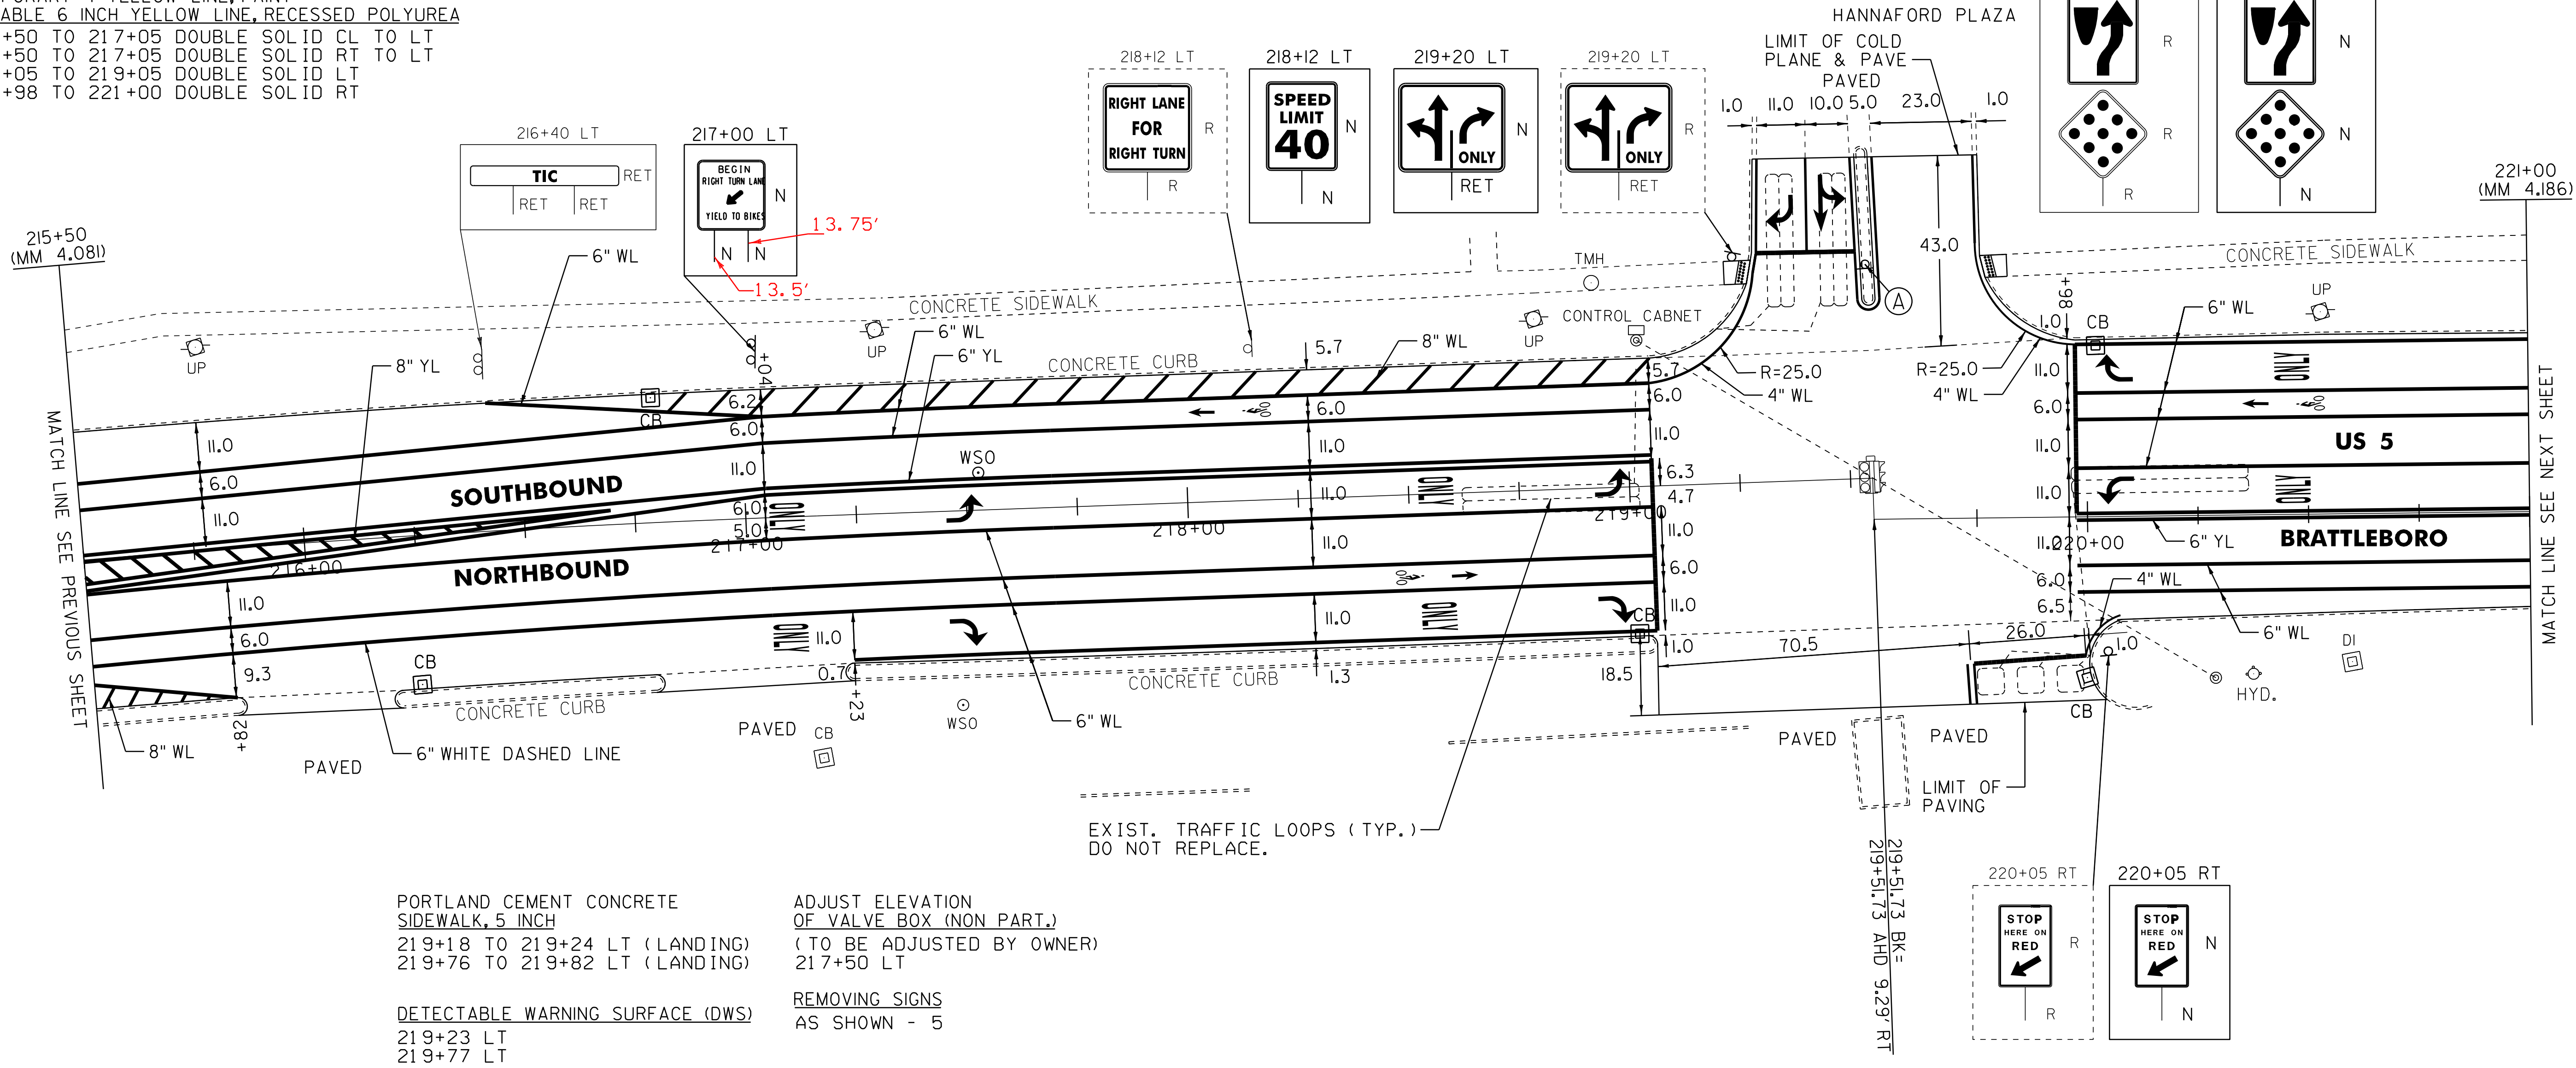

PORTLAND CEMENT CONCRETE
 SIDEWALK, 5 INCH
 219+18 TO 219+24 LT (LANDING)
 219+76 TO 219+82 LT (LANDING)

ADJUST ELEVATION
 OF VALVE BOX (NON PART.)
 (TO BE ADJUSTED BY OWNER)
 217+50 LT

DETECTABLE WARNING SURFACE (DWS)
 219+23 LT
 219+77 LT

REMOVING SIGNS
 AS SHOWN - 5

LEGEND

R = REMOVE EXISTING
 S = SALVAGE
 R&S = REMOVE AND SALVAGE
 N = NEW
 RET = RETAIN
 B-B = BACK TO BACK
 --- = EXISTING GUARDRAIL
 --- = PROPOSED GUARDRAIL
 YL = YELLOW LINE
 WL = WHITE LINE
 ∅ = DELINEATOR

ROADWAY LAYOUT 12 US 5

PROJECT NAME: BRATTLEBORO-PUTNEY
 PROJECT NUMBER: STP 2310(I)

FILE NAME: /pave/01c032/pc032
 PROJECT LEADER: PTS
 DESIGNED BY: NLL
 IPARM FILE NAME: OIC032.33

PLOT DATE: 02-MAY-2012 17:2
 DRAWN BY: WWG
 CHECKED BY: NLL/PTS
 SHEET 33 OF 118

NOT TO SCALE