

TEMPORARY 4" WHITE LINE, PAINT  
 DURABLE 6 INCH WHITE LINE, RECESSED POLYUREA  
 221+00 TO 222+04 SOLID LT (LANE LINE)  
 221+00 TO 226+00 SOLID RT (BIKE LANE)  
 221+00 TO 226+00 SOLID RT (BIKE LANE)  
 221+00 TO 226+00 SOLID LT  
 221+00 TO 222+04 SOLID LT (BIKE LANE)  
 221+00 TO 222+04 SOLID LT (BIKE LANE)  
 222+04 TO 223+26 DOTTED LT (BIKE LANE)  
 222+04 TO 223+26 DOTTED LT (BIKE LANE)  
 222+04 TO 224+39 DOTTED LT (LANE LINE)  
 223+26 TO 226+00 SOLID LT (BIKE LANE)

TEMPORARY 4" YELLOW LINE, PAINT  
 DURABLE 6 INCH YELLOW LINE, RECESSED POLYUREA  
 221+00 TO 226+00 DOUBLE SOLID RT TO LT

DURABLE 8" WHITE LINE, THERMOPLASTIC  
 222+75 TO 223+76 SOLID LT (DIAGONALS)


TEMPORARY LETTER OR SYMBOL, PAINT  
 221+48 RT - BIKE  
 221+60 RT - BIKE ARROW  
 221+61 LT - RIGHT TURN ARROW  
 221+61 LT - LEFT TURN ARROW

DURABLE LETTER OR SYMBOL, THERMOPLASTIC  
 221+48 RT - BIKE  
 221+60 RT - BIKE ARROW  
 221+61 LT - RIGHT TURN ARROW  
 221+61 LT - LEFT TURN ARROW  
 222+01 LT - ONLY  
 222+01 LT - ONLY

CHANGING ELEVATION OF DROP INLETS, CATCH BASINS, OR MANHOLES, CLASS I, II, OR III  
 222+79 RT (CB)

REHAB. DROP INLETS, CATCH BASINS, OR MANHOLES, CLASS I, II, OR III  
 221+88 RT (CB)  
 223+90 RT (CB)  
 225+70 RT (CB)  
 222+79 RT (CB)  
 CHANGING ELEVATION OF SEWER MANHOLES (NON PART.)  
 (TO BE ADJUSTED BY OWNER)  
 222+05 RT

ADJUST ELEVATION OF VALVE BOX (NON PART.)  
 (TO BE ADJUSTED BY OWNER)  
 222+62 RT

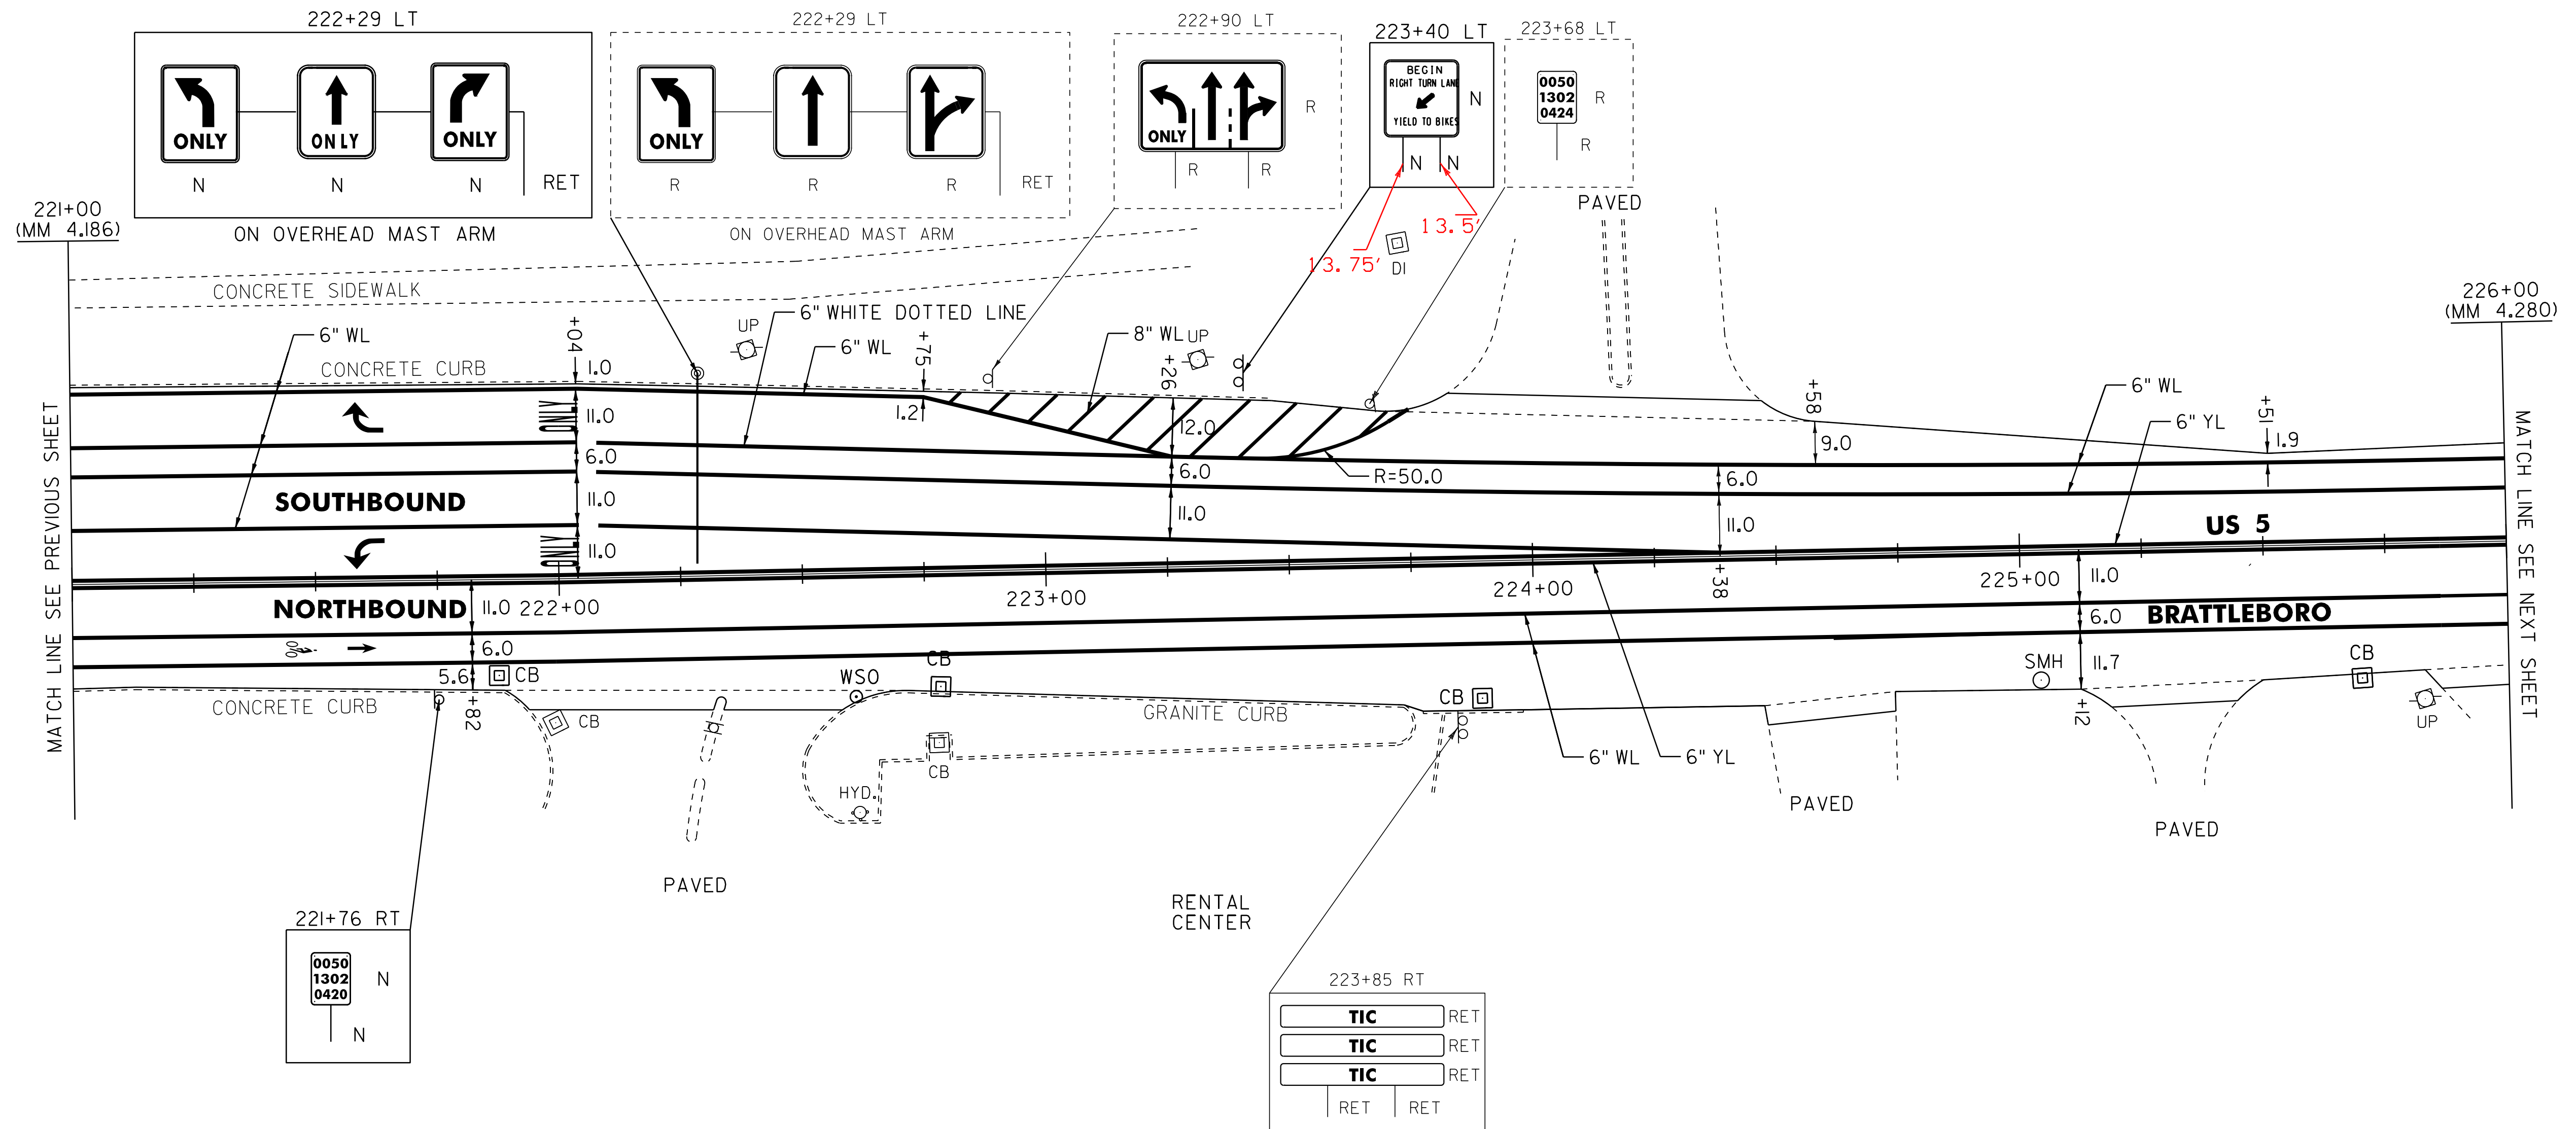

NOT TO SCALE

- LEGEND**
- R = REMOVE EXISTING
  - S = SALVAGE
  - R&S = REMOVE AND SALVAGE
  - N = NEW
  - RET = RETAIN
  - B-B = BACK TO BACK
  - - - = EXISTING GUARDRAIL
  - — — = PROPOSED GUARDRAIL
  - YL = YELLOW LINE
  - WL = WHITE LINE
  - = DELINEATOR

**ROADWAY LAYOUT 13 US 5**

PROJECT NAME: BRATTLEBORO-PUTNEY  
 PROJECT NUMBER: STP 2310(I)

FILE NAME: /pave/01c032/pc032  
 PROJECT LEADER: PTS  
 DESIGNED BY: NLL  
 IPARM FILE NAME: 01C032.34

PLOT DATE: 02-MAY-2012 17:2  
 DRAWN BY: WWG  
 CHECKED BY: NLL/PTS  
 SHEET 34 OF 118