

TEMPORARY 4" WHITE LINE, PAINT
 DURABLE 6 INCH WHITE LINE, RECESSED POLYUREA
 226+00 TO 228+98 SOLID LT (BIKE LANE)
 226+00 TO 228+93 SOLID LT (BIKE LANE)
 226+00 TO 231+00 SOLID RT (BIKE LANE)
 226+00 TO 231+00 SOLID RT (BIKE LANE)
 229+68 TO 231+00 SOLID LT (BIKE LANE)
 229+73 TO 231+00 SOLID LT (BIKE LANE)

TEMPORARY 4" YELLOW LINE, PAINT
 DURABLE 6 INCH YELLOW LINE, RECESSED POLYUREA
 226+00 TO 228+93 DOUBLE SOLID LT
 229+73 TO 231+00 DOUBLE SOLID LT

TEMPORARY 4" WHITE LINE, PAINT
 DURABLE 4" WHITE LINE, THERMOPLASTIC
 228+98 TO 229+18 SOLID LT
 229+46 TO 229+68 SOLID LT

TEMPORARY 4" YELLOW LINE, PAINT
 DURABLE 4" YELLOW LINE, THERMOPLASTIC
 229+33 DOUBLE SOLID LT

TEMPORARY LETTER OR SYMBOL, PAINT
 DURABLE LETTER OR SYMBOL, THERMOPLASTIC
 228+08 LT - BIKE ARROW
 228+20 LT - BIKE
 230+45 RT - BIKE
 230+57 RT - BIKE ARROW

TEMPORARY 24" STOP BAR, PAINT
 DURABLE 24" STOP BAR, THERMOPLASTIC
 228+93 RT
 228+97 TO 229+24 RT
 229+15 TO 229+32 LT (TH 36)
 229+73 LT

BITUMINOUS GUTTER &
 TRAFFIC ISLAND
 229+35 TO 231+00 RT

REHAB. DROP INLETS, CATCH BASINS,
 OR MANHOLES, CLASS I, II, OR III
 228+26 RT (CB)
 229+94 RT (CB)
 230+62 RT (CB)


ADJUST ELEVATION
 OF VALVE BOX (NON PART.)
 (TO BE ADJUSTED BY OWNER)
 229+11 LT
 229+20 LT
 229+23 LT (TH 36)
 229+24 LT (DRIVE)
 229+25 RT (DRIVE)
 229+30 RT
 230+44 RT

CHANGING ELEVATION
 OF SEWER MANHOLES (NON PART.)
 (TO BE ADJUSTED BY OWNER)
 229+38 LT
 229+39 RT

REMOVING SIGNS
 AS SHOWN - 5

ERECTING SALVAGED SIGNS
 AS SHOWN - 2

BEYOND JOB LIMIT

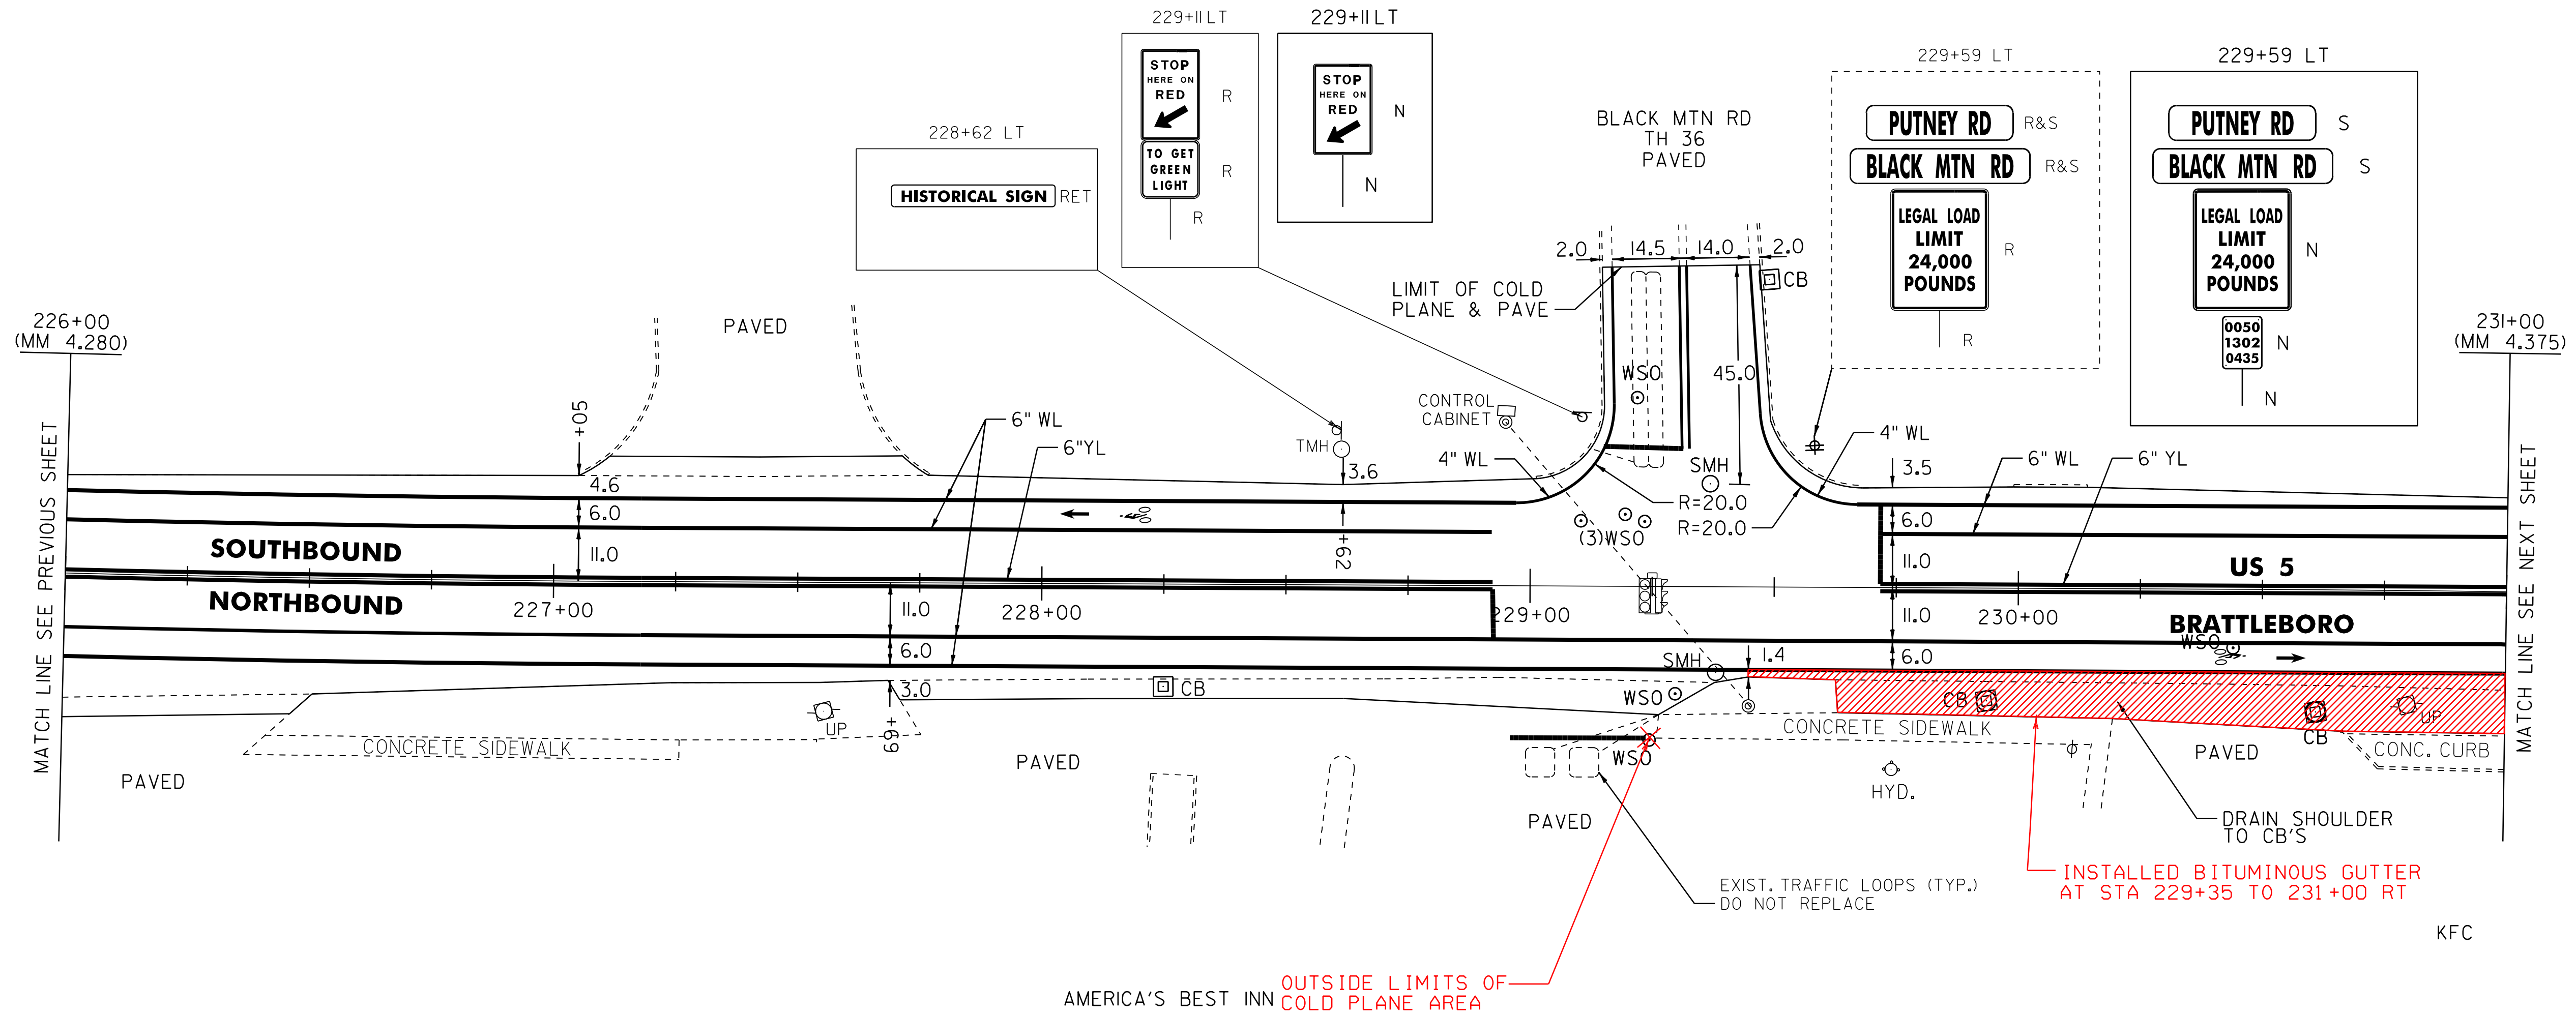

LEGEND

- R = REMOVE EXISTING
- S = SALVAGE
- R&S = REMOVE AND SALVAGE
- N = NEW
- RET = RETAIN
- B-B = BACK TO BACK
- = EXISTING GUARDRAIL
- = PROPOSED GUARDRAIL
- YL = YELLOW LINE
- WL = WHITE LINE
- o = DELINEATOR

ROADWAY LAYOUT 14 US 5

PROJECT NAME: BRATTLEBORO-PUTNEY	FILE NAME: /pave/01c032/pc032	PLOT DATE: 02-MAY-2012 17:2
PROJECT NUMBER: STP 2310(I)	PROJECT LEADER: PTS	DRAWN BY: WWG
	DESIGNED BY: NLL	CHECKED BY: NLL/PTS
	IPARM FILE NAME: 01C032.35	SHEET 35 OF 118

NOT TO SCALE