

TEMPORARY 4" WHITE LINE, PAINT
 DURABLE 6 INCH WHITE LINE, RECESSED POLYUREA
 231+00 TO 236+00 SOLID LT (BIKE LANE)
 231+00 TO 236+00 SOLID LT (BIKE LANE)
 231+00 TO 236+00 SOLID RT (BIKE LANE)
 231+00 TO 236+00 SOLID RT (BIKE LANE)

TEMPORARY 4" YELLOW LINE, PAINT
 DURABLE 6 INCH YELLOW LINE, RECESSED POLYUREA
 231+00 TO 231+28 DOUBLE SOLID LT
 231+28 TO 233+25 DOUBLE SOLID LT
 231+28 TO 233+25 DOUBLE SOLID RT
 233+25 TO 236+00 SOLID/DASHED LT
 233+25 TO 236+00 DASHED/SOLID RT

DURABLE 8" YELLOW LINE, THERMOPLASTIC
 231+28 TO 233+13 SOLID LT & RT (GORE)

TEMPORARY LETTER OR SYMBOL, PAINT
 DURABLE LETTER OR SYMBOL, THERMOPLASTIC
 233+67 RT - LEFT TURN ARROW
 233+87 LT - LEFT TURN ARROW
 234+82 RT - YIELD
 234+94 LT - BIKE ARROW
 235+06 LT - BIKE
 235+22 RT - AHEAD
 235+74 LT - LEFT TURN ARROW
 235+93 LT - LEFT TURN ARROW


REHAB. DROP INLETS, CATCH BASINS,
 OR MANHOLES, CLASS I, II, OR III

232+24 RT (CB)
 235+18 (CB)
 235+33 RT (CB) (DRIVE)

CHANGING ELEVATION
 OF SEWER MANHOLES (NON PART.)
 (TO BE ADJUSTED BY OWNER)
 233+33 RT

REMOVING SIGNS
 AS SHOWN - 9

BITUMINOUS CONCRETE GUTTERS
 & TRAFFIC ISLANDS
 231+00 TO 232+70 RT
 234+15 TO 235+35 RT

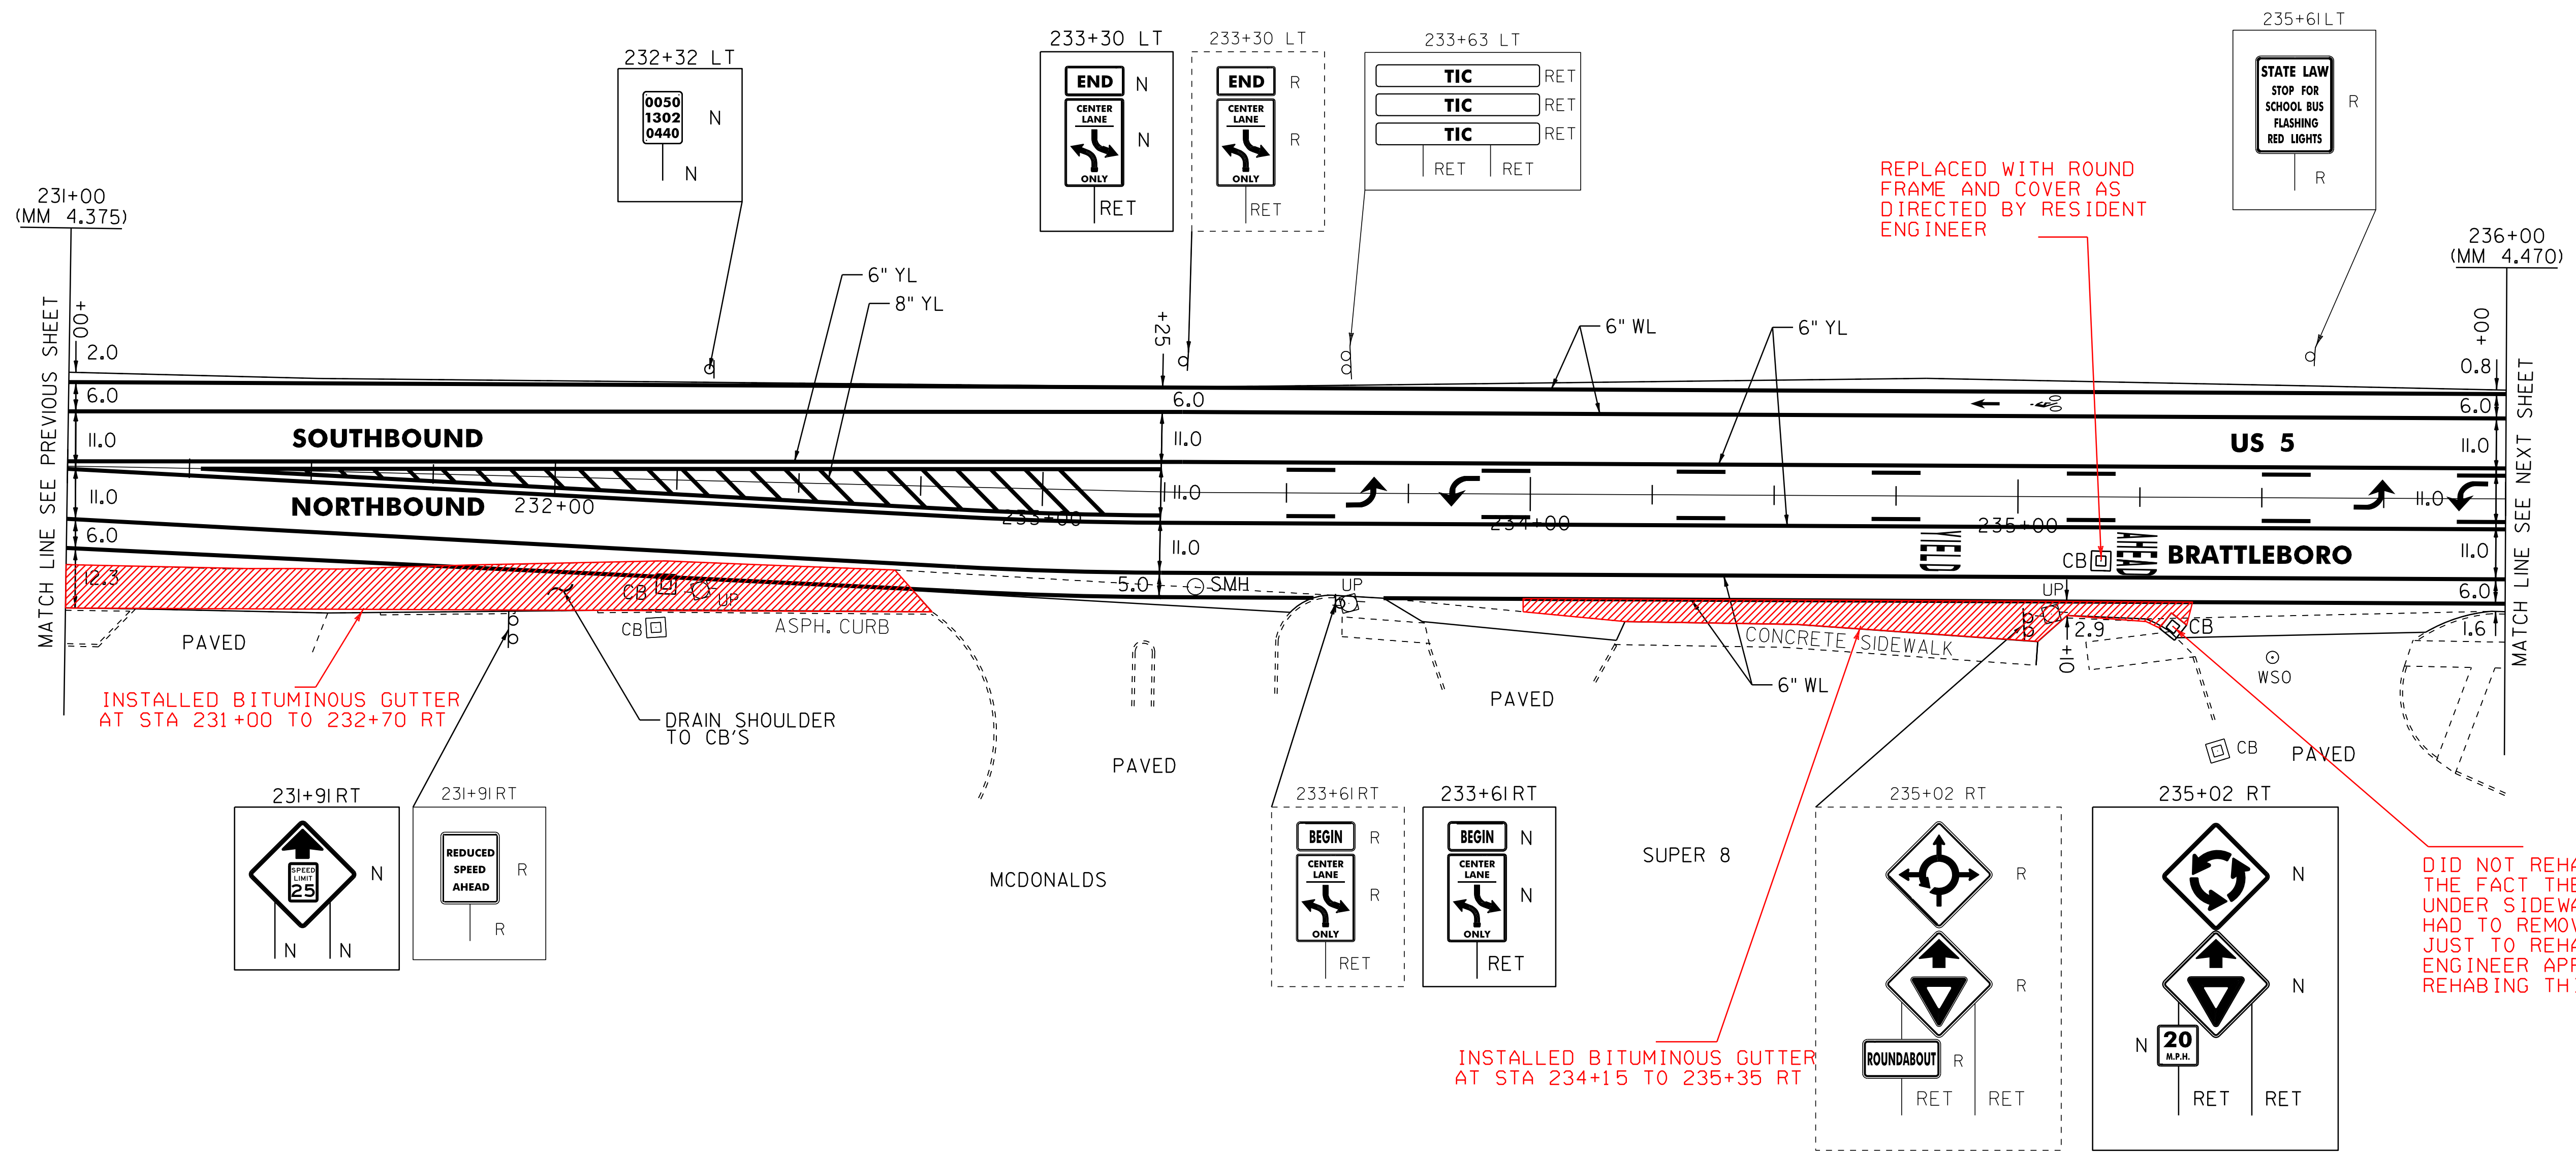

LEGEND

- R = REMOVE EXISTING
- S = SALVAGE
- R&S = REMOVE AND SALVAGE
- N = NEW
- RET = RETAIN
- B-B = BACK TO BACK
- = EXISTING GUARDRAIL
- - - = PROPOSED GUARDRAIL
- YL = YELLOW LINE
- WL = WHITE LINE
- ⊙ = DELINEATOR

ROADWAY LAYOUT 15 US 5

PROJECT NAME:	BRATTLEBORO-PUTNEY	FILE NAME:	/pave/01c032/pc032	PLOT DATE:	02-MAY-2012 17:2
PROJECT NUMBER:	STP 2310(I)	PROJECT LEADER:	PTS	DRAWN BY:	WWG
		DESIGNED BY:	NLL	CHECKED BY:	NLL/PTS
		IPARM FILE NAME:	OIC032.36	SHEET	36 OF 118

NOT TO SCALE