

TEMPORARY 4" WHITE LINE, PAINT
 DURABLE 6 INCH WHITE LINE, RECESSED POLYUREA
 236+00 TO 241+00 SOLID LT & RT
 240+55 TO 241+00 DASHED RT

TEMPORARY 4" YELLOW LINE, PAINT
 DURABLE 6 INCH YELLOW LINE, RECESSED POLYUREA
 236+00 TO 240+44 SOLID/DASHED LT
 236+00 TO 240+44 DASHED/SOLID RT
 240+44 TO 240+94 DOUBLE SOLID LT
 240+44 TO 241+00 DOUBLE SOLID RT
 240+94 TO 241+00 SOLID LT


DURABLE 8" YELLOW LINE, THERMOPLASTIC
 240+45 TO 240+93 SOLID LT TO RT (GORE)

TEMPORARY LETTER OR SYMBOL, PAINT
 DURABLE LETTER OR SYMBOL, THERMOPLASTIC
 237+81 LT - LEFT TURN ARROW
 238+00 LT - LEFT TURN ARROW
 239+88 LT - LEFT TURN TURN ARROW
 240+08 LT - LEFT TURN ARROW

REHAB. DROP INLETS, CATCH BASINS,
 OR MANHOLES, CLASS I, II, OR III
 236+54 RT (CB)
 237+90 RT (CB)
 239+01 RT (CB)
 239+77 RT (CB)

REMOVING SIGNS
 AS SHOWN - 22

CHANGING ELEVATION
 OF SEWER MANHOLES (NON PART.)
 (TO BE ADJUSTED BY OWNER)
 240+67 LT (DRIVE)

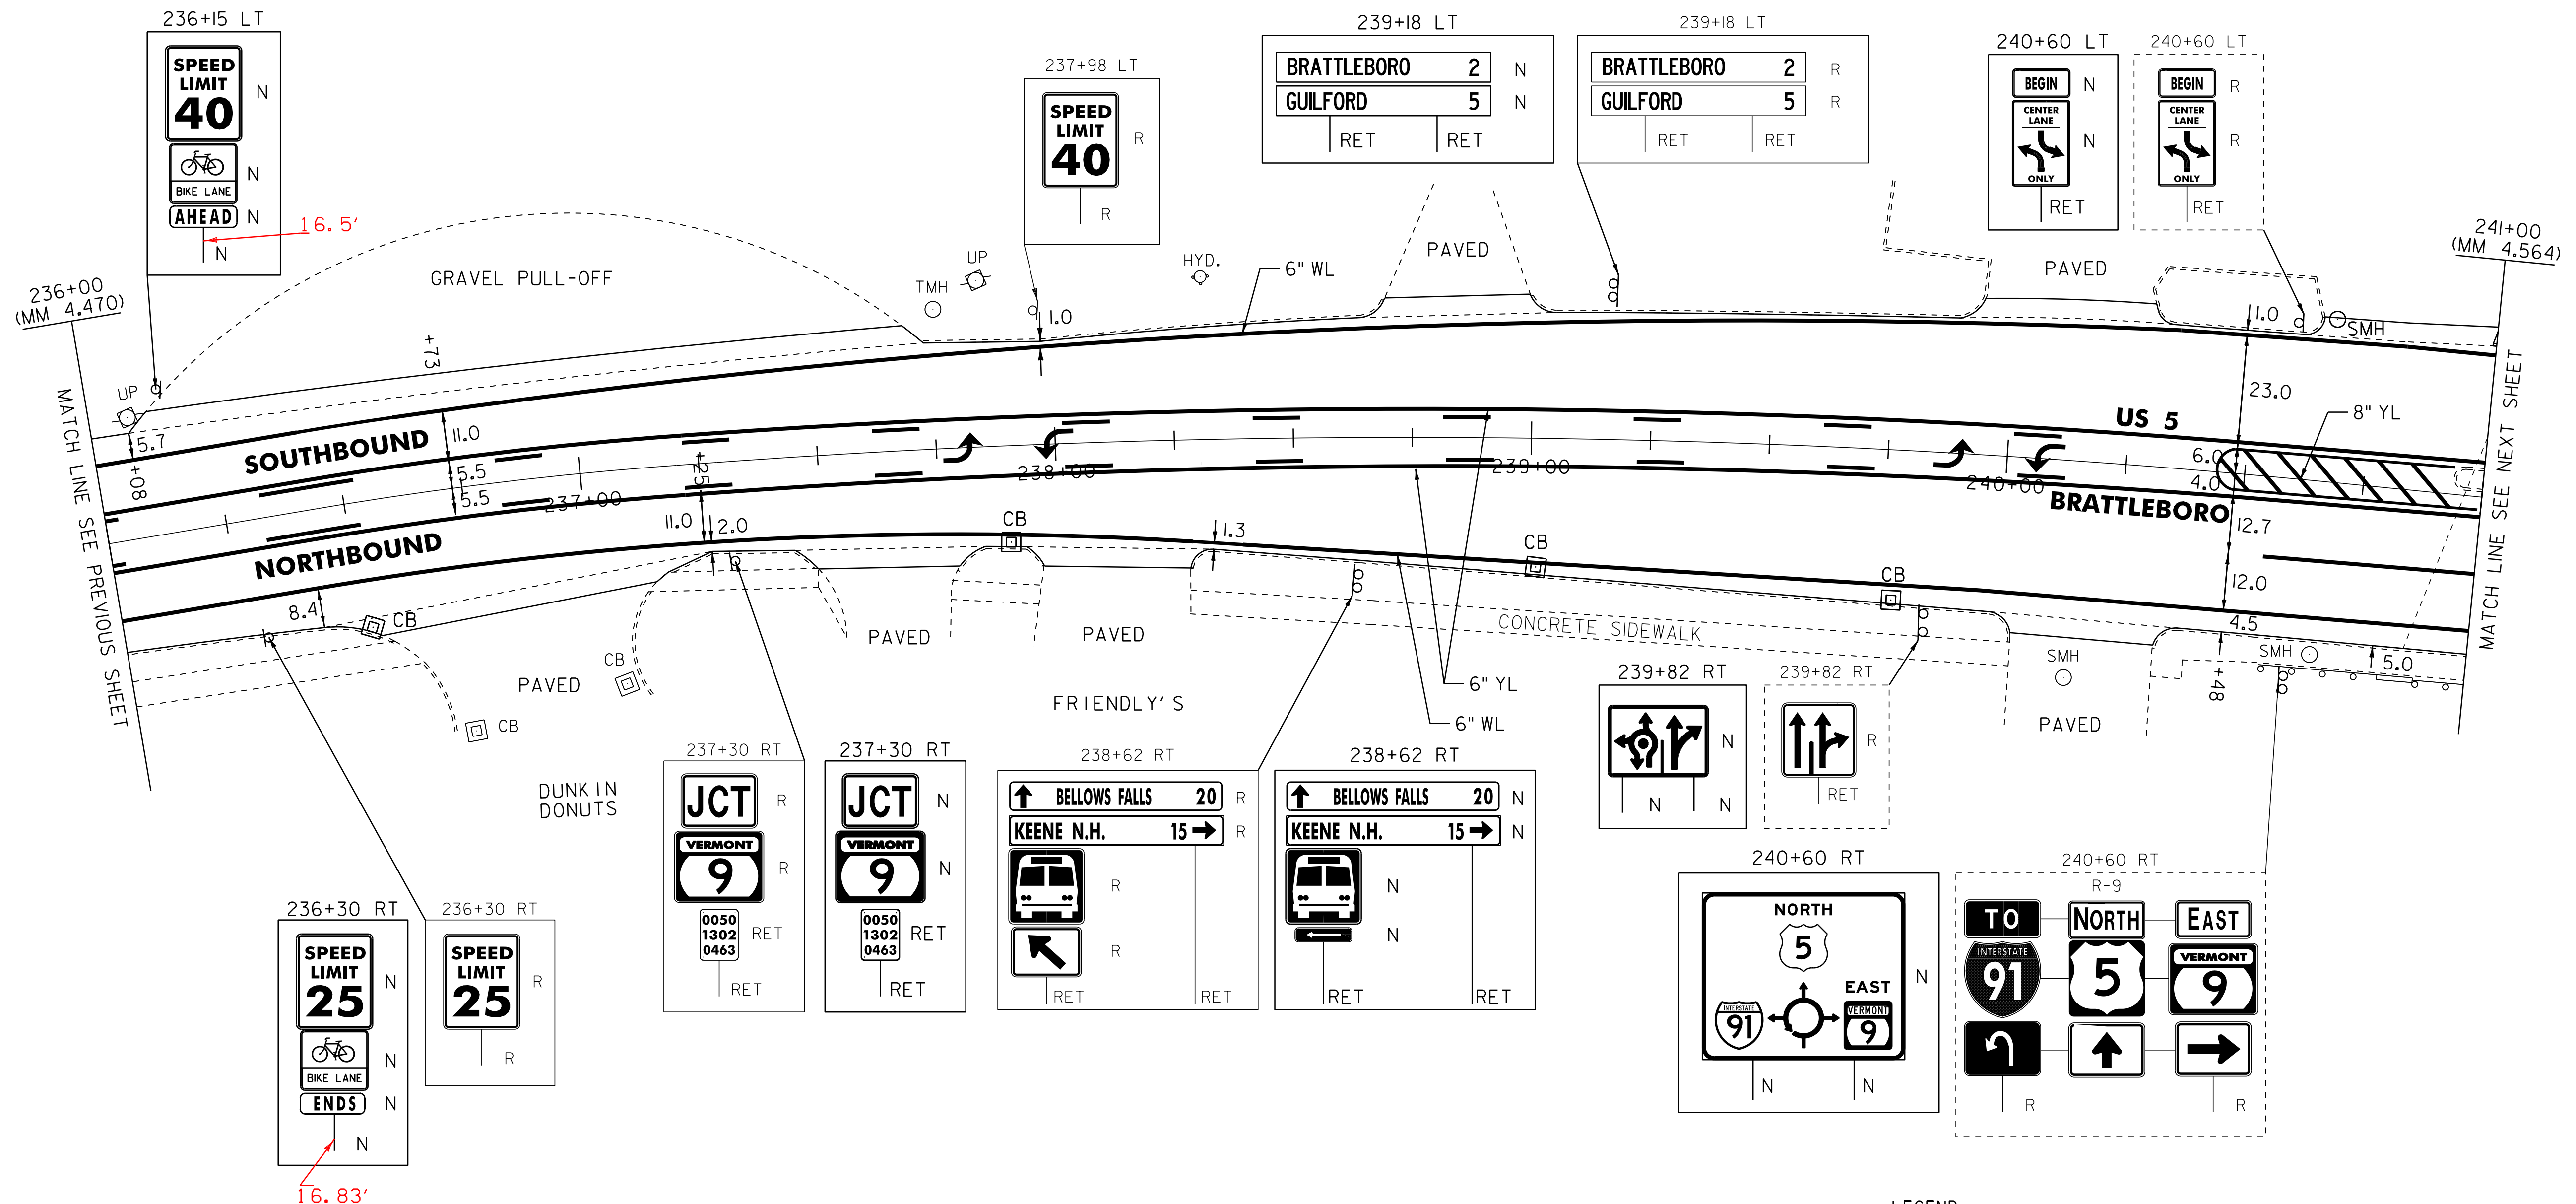

- LEGEND**
- R = REMOVE EXISTING
 - S = SALVAGE
 - R&S = REMOVE AND SALVAGE
 - N = NEW
 - RET = RETAIN
 - B-B = BACK TO BACK
 - = EXISTING GUARDRAIL
 - - - = PROPOSED GUARDRAIL
 - YL = YELLOW LINE
 - WL = WHITE LINE
 - = DELINEATOR

ROADWAY LAYOUT 16 US 5

PROJECT NAME: BRATTLEBORO-PUTNEY	FILE NAME: /pave/01c032/pc032	PLOT DATE: 02-MAY-2012 17:22
PROJECT NUMBER: STP 2310(I)	PROJECT LEADER: PTS	DRAWN BY: WWG
	DESIGNED BY: NLL	CHECKED BY: NLL/PTS
	IPARM FILE NAME: 01C032_37	SHEET 37 OF 118

NOT TO SCALE