


TEMPORARY 4" WHITE LINE, PAINT  
 DURABLE 64" WHITE LINE, THERMOPLASTIC  
 B 0+47 TO B 2+25 SOLID LT & RT  
 B 0+47 TO B 2+25 DASHED LT & RT

TEMPORARY 4" YELLOW LINE, PAINT  
 DURABLE 64" YELLOW LINE, THERMOPLASTIC  
 B 0+47 TO B 2+25 SOLID LT & RT

REMOVING SIGNS  
 AS SHOWN - 24

ERECTING SALVAGED SIGNS  
 AS SHOWN - 6

RECESSED POLYUREA

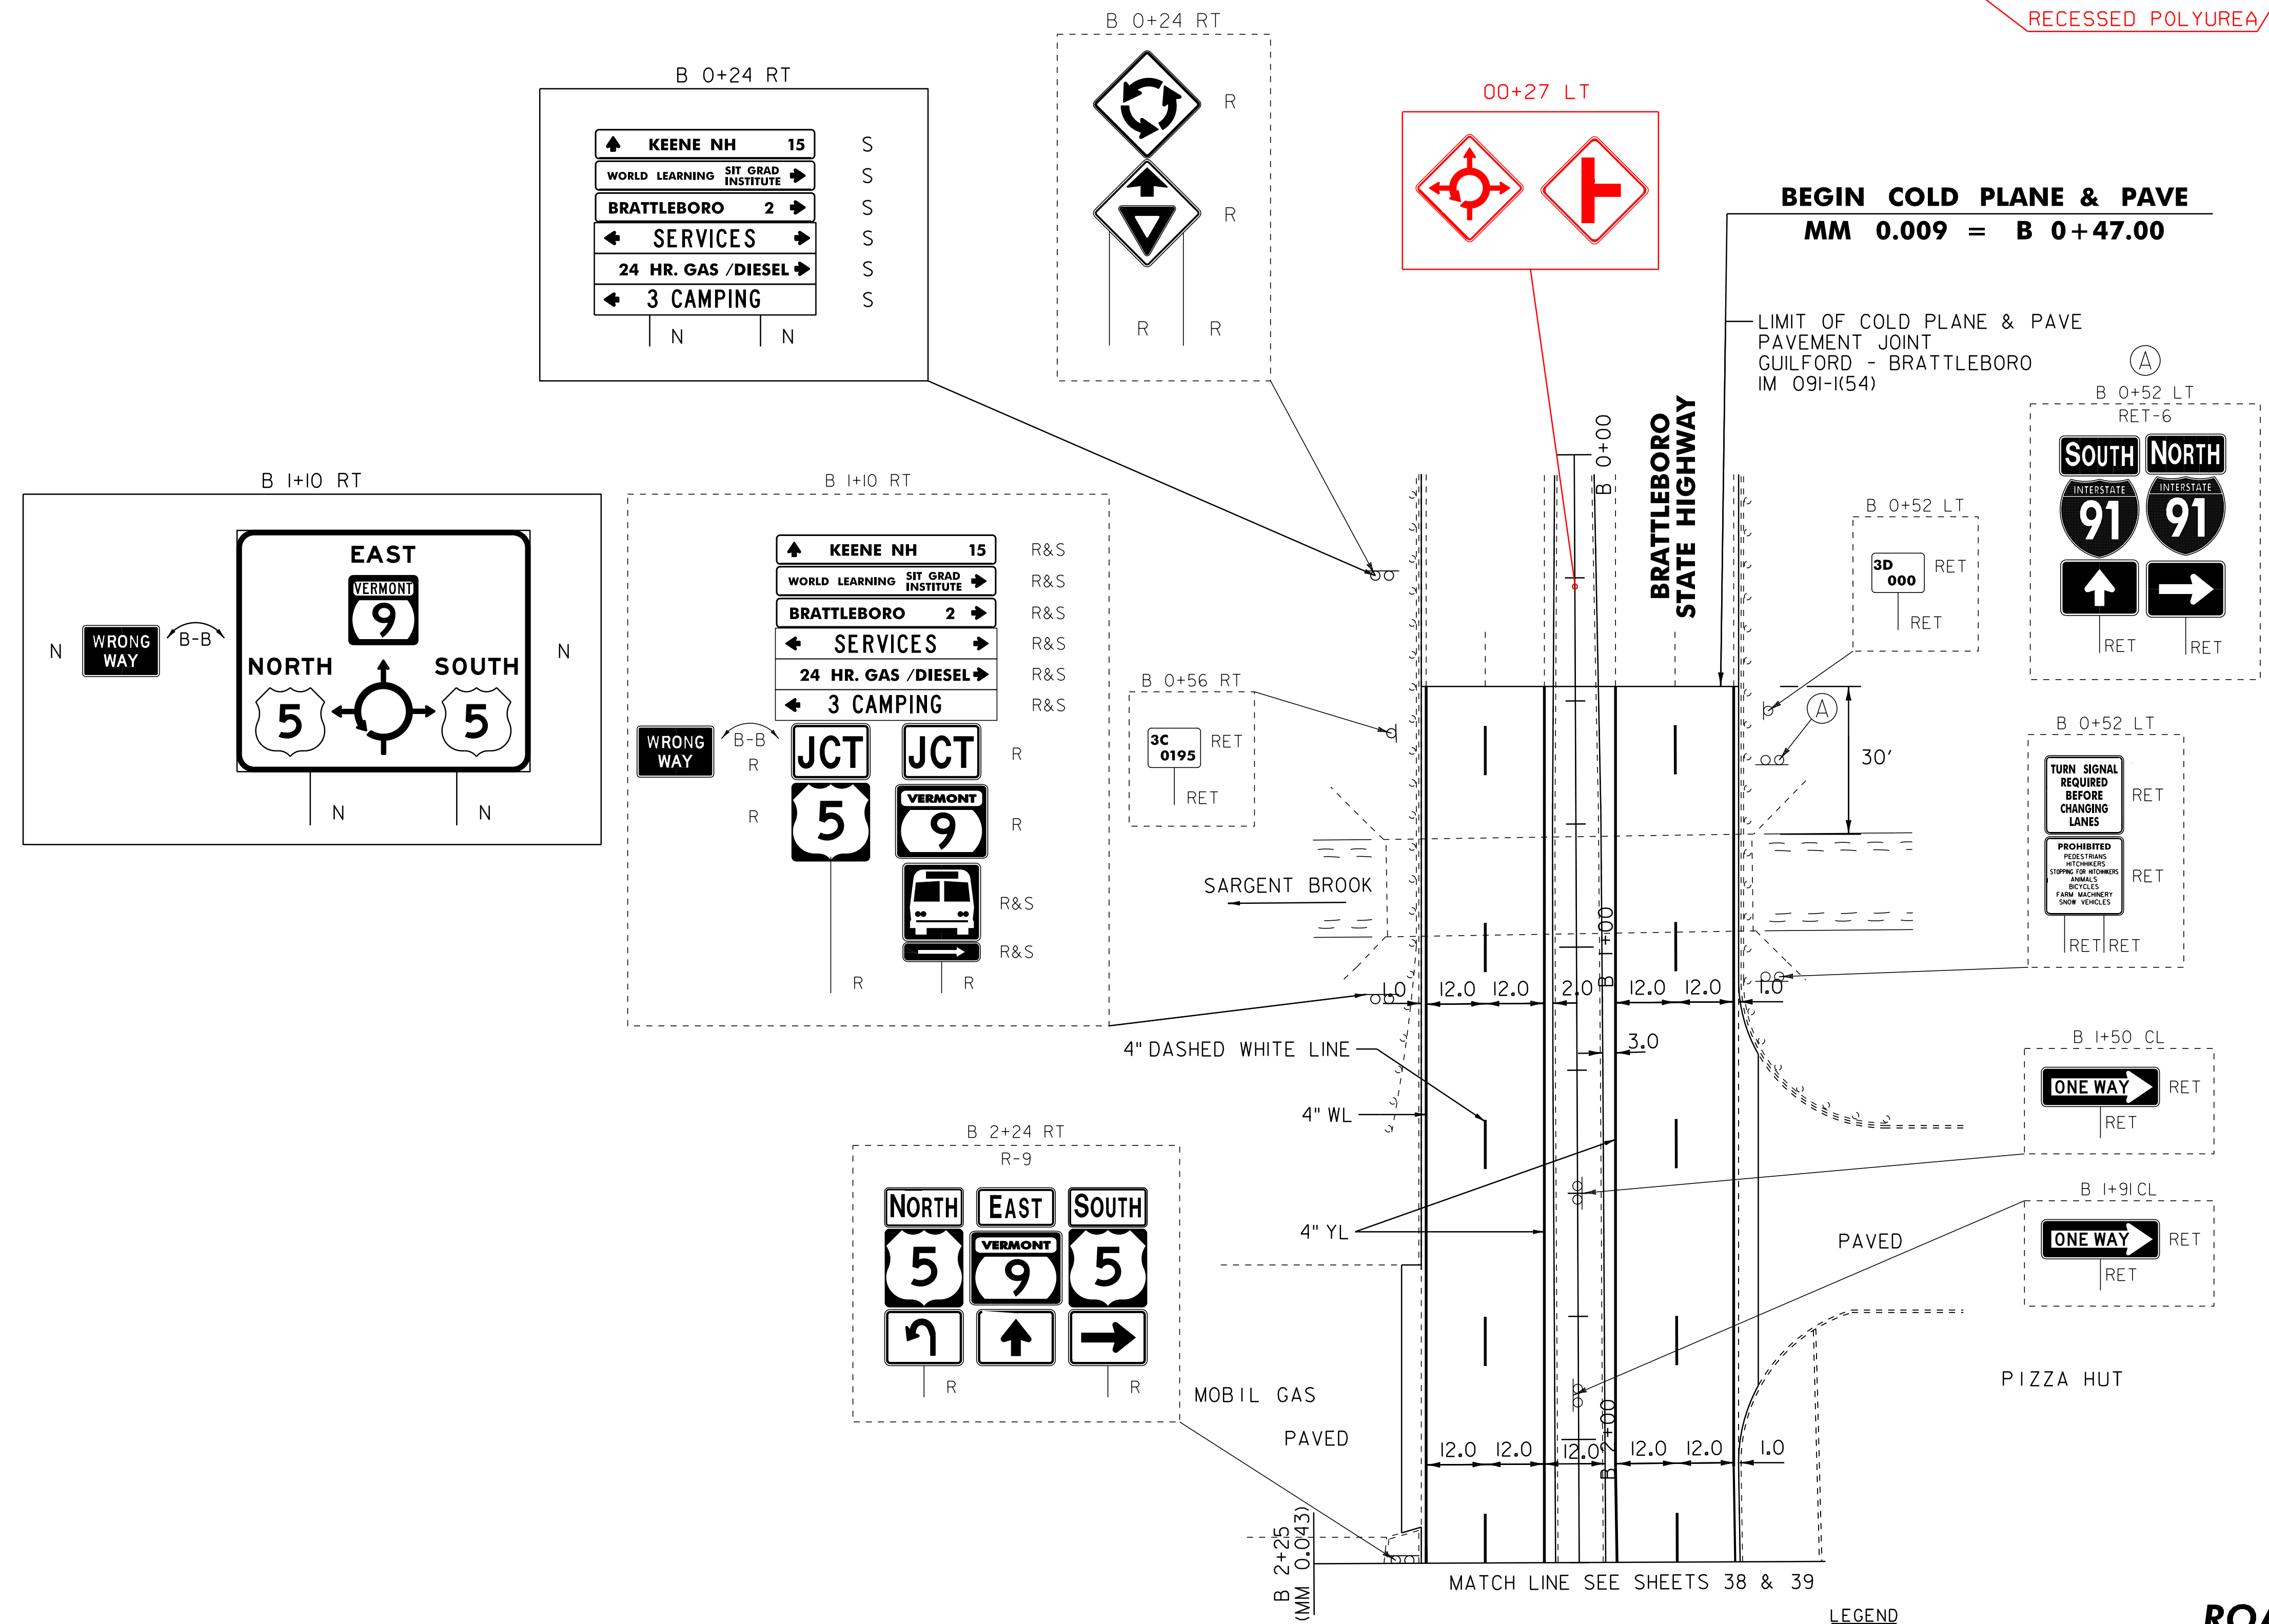

**BEGIN COLD PLANE & PAVE**  
**MM 0.009 = B 0+47.00**

LIMIT OF COLD PLANE & PAVE  
 PAVEMENT JOINT  
 GUILFORD - BRATTLEBORO  
 IM 091-(54)

BRATTLEBORO  
 STATE HIGHWAY

SARGENT BROOK

PIZZA HUT

MATCH LINE SEE SHEETS 38 & 39

NOT TO SCALE

LEGEND

- R = REMOVE EXISTING
- S = SALVAGE
- R&S = REMOVE AND SALVAGE
- N = NEW
- RET = RETAIN
- B-B = BACK TO BACK
- = EXISTING GUARDRAIL
- = PROPOSED GUARDRAIL
- YL = YELLOW LINE
- WL = WHITE LINE
- o = DELINEATOR

**ROADWAY LAYOUT 17B**  
**BRATTLEBORO STATE HIGHWAY**

|                                  |                               |                             |
|----------------------------------|-------------------------------|-----------------------------|
| PROJECT NAME: BRATTLEBORO-PUTNEY | FILE NAME: /pave/01c032/pc032 | PLOT DATE: 02-MAY-2012 17:2 |
| PROJECT NUMBER: STP 2310(I)      | PROJECT LEADER: PTS           | DRAWN BY: WWG               |
|                                  | DESIGNED BY: NLL              | CHECKED BY: NLL/PTS         |
|                                  | IPARM FILE NAME: 01C032.40    | SHEET 40 OF 118             |