

TEMPORARY 4" WHITE LINE, PAINT
 DURABLE 4" WHITE LINE, THERMOPLASTIC
 251+50 TO 255+49 SOLID RT
 251+50 TO 257+00 SOLID LT
 255+49 TO 255+79 SOLID RT (TH 46)
 256+01 TO 256+31 SOLID RT (TH 46)
 256+31 TO 257+00 SOLID RT

TEMPORARY 4" YELLOW LINE, PAINT
 DURABLE 4" YELLOW LINE, THERMOPLASTIC
 251+50 TO 255+71 SOLID LT & RT
 255+89 DOUBLE SOLID RT (TH 46)
 256+11 TO 257+00 SOLID LT & RT

TEMPORARY 24" STOP BAR, PAINT
 DURABLE 24" STOP BAR, THERMOPLASTIC
 255+90 TO 256+07 RT - STOP (TH 46)

TEMPORARY LETTER OR SYMBOL, PAINT
 DURABLE LETTER OR SYMBOL, THERMOPLASTIC
 251+82 LT - AHEAD
 252+22 LT - YIELD
 255+96 RT - STOP (TH 46)


CHANGING ELEVATION
 OF SEWER MANHOLES (NON PART.)
 (TO BE ADJUSTED BY OWNER)
 256+07 RT

ADJUST ELEVATION
 OF VALVE BOX (NON PART.)
 (TO BE ADJUSTED BY OWNER)
 255+19 LT (DRIVE)
 255+73 RT
 255+71 RT

REMOVAL OF EXISTING DELINEATOR
 253+90 RT (2 SIGN POSTS)

REMOVING SIGNS
 AS SHOWN - 8

ERECTING SALVAGED SIGNS
 AS SHOWN - 2

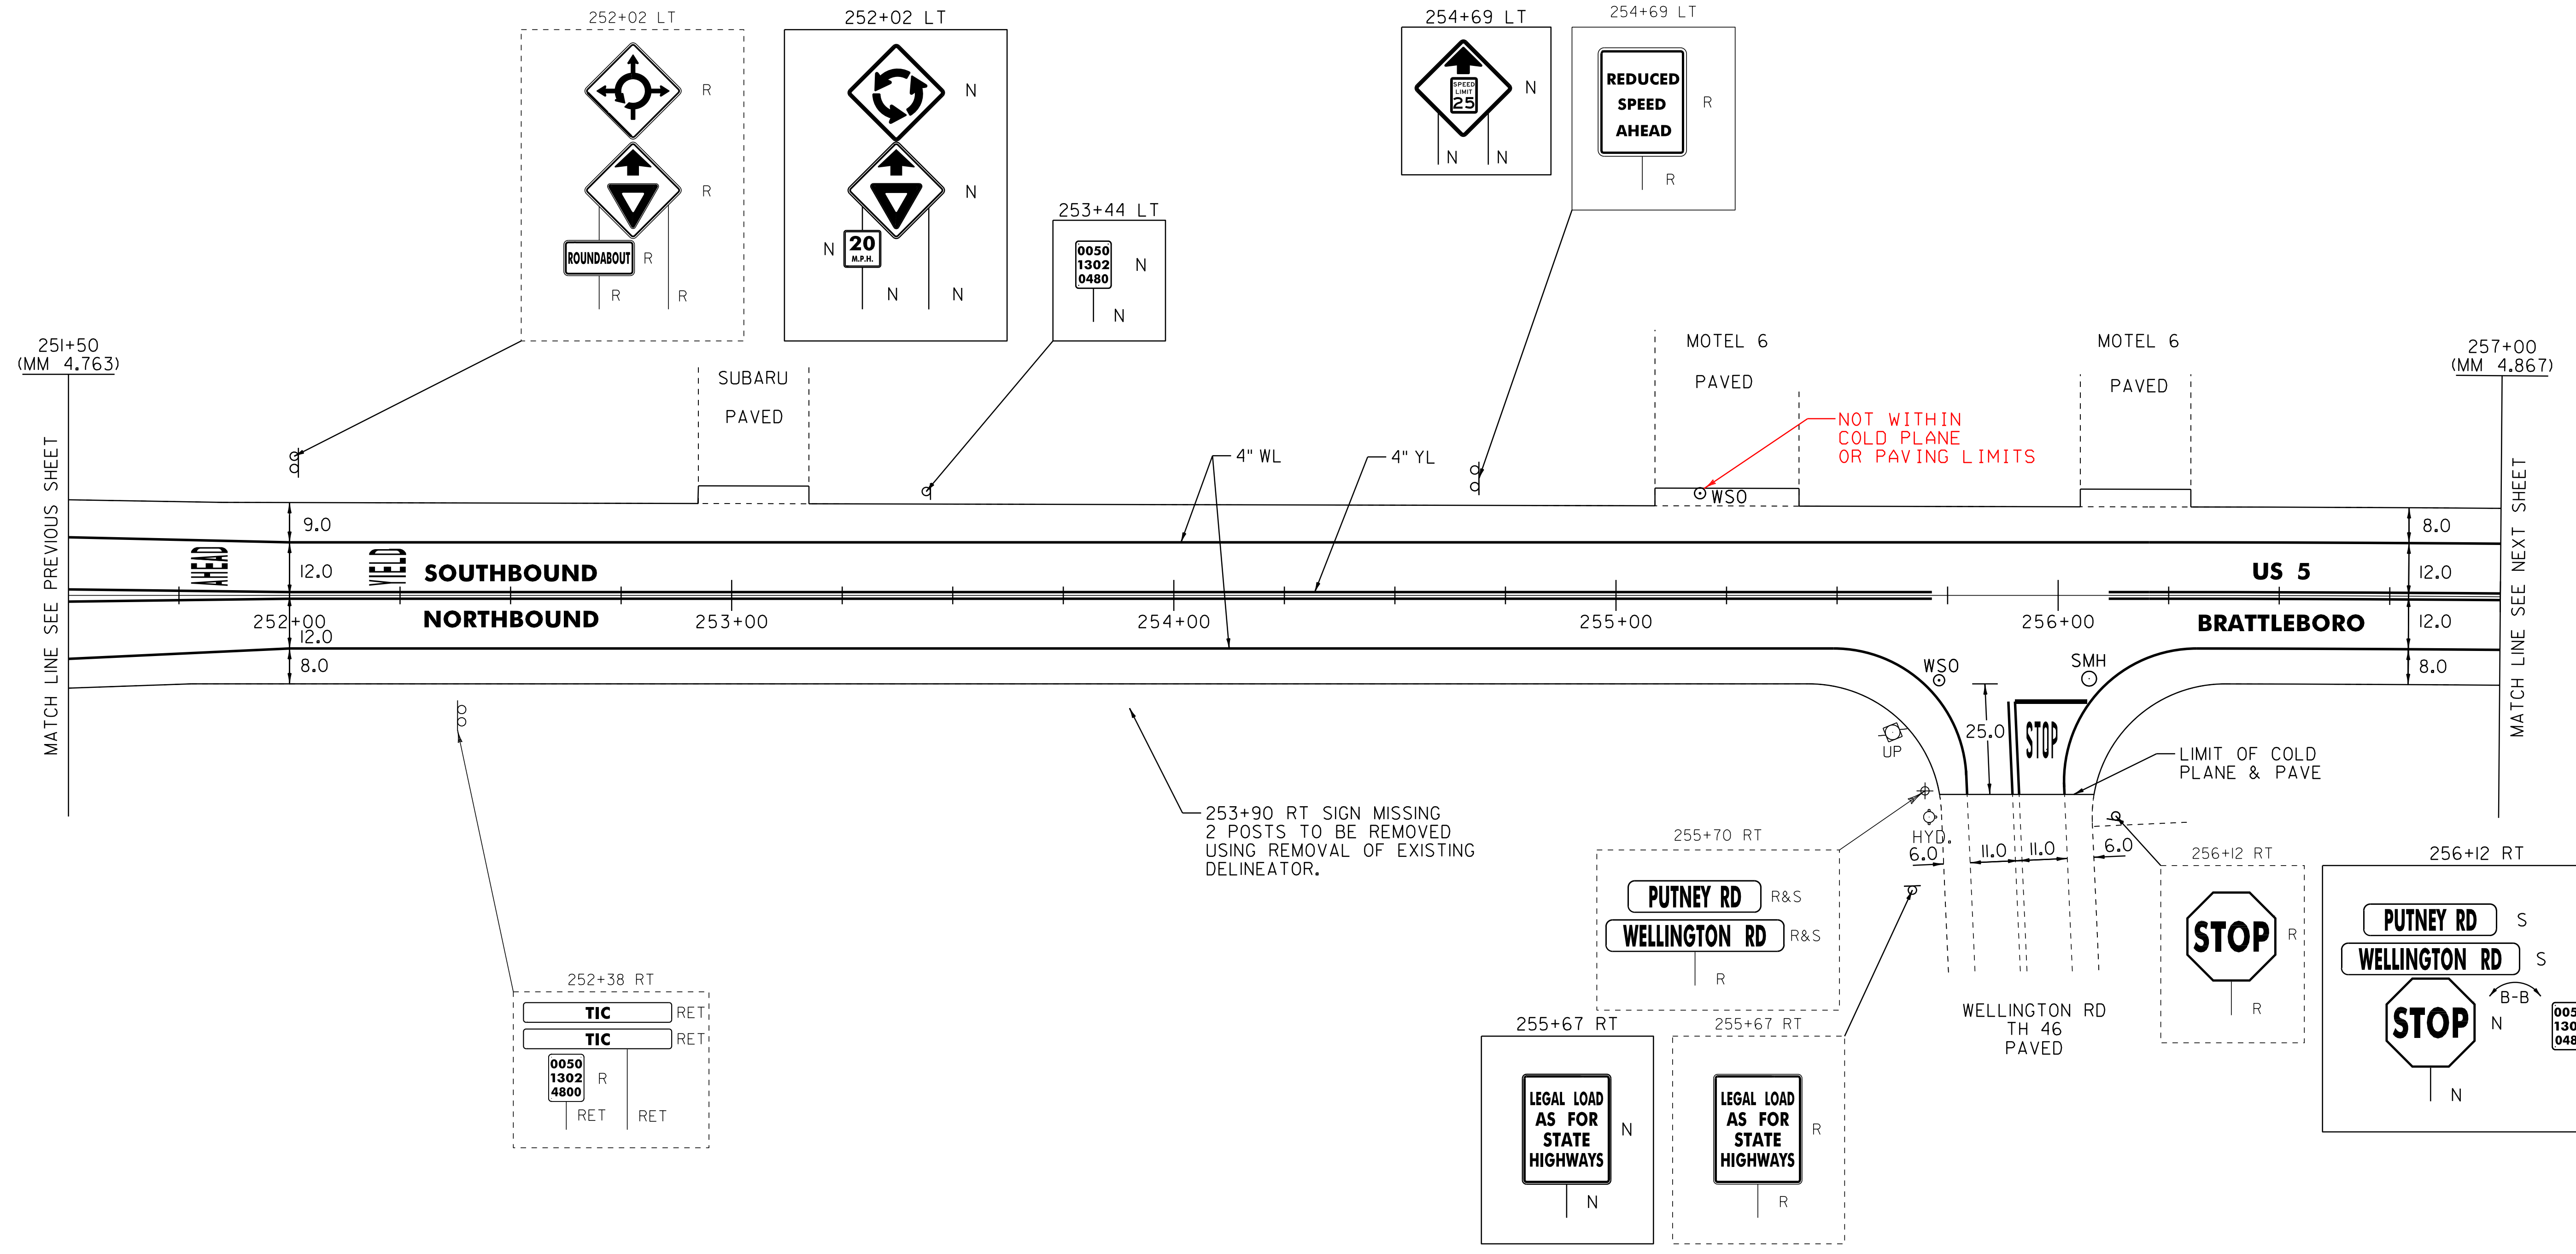

NOT TO SCALE

- LEGEND**
- R = REMOVE EXISTING
 - S = SALVAGE
 - R&S = REMOVE AND SALVAGE
 - N = NEW
 - RET = RETAIN
 - B-B = BACK TO BACK
 - = EXISTING GUARDRAIL
 - - - = PROPOSED GUARDRAIL
 - YL = YELLOW LINE
 - WL = WHITE LINE
 - = DELINEATOR

ROADWAY LAYOUT 19 US 5

PROJECT NAME: BRATTLEBORO-PUTNEY
 PROJECT NUMBER: STP 2310(I)

FILE NAME: /pave/01c032/pc032
 PROJECT LEADER: PTS
 DESIGNED BY: NLL
 IPARM FILE NAME: 01C032.43

PLOT DATE: 02-MAY-2012 17:2
 DRAWN BY: WWG
 CHECKED BY: NLL/PTS
 SHEET 43 OF 118