
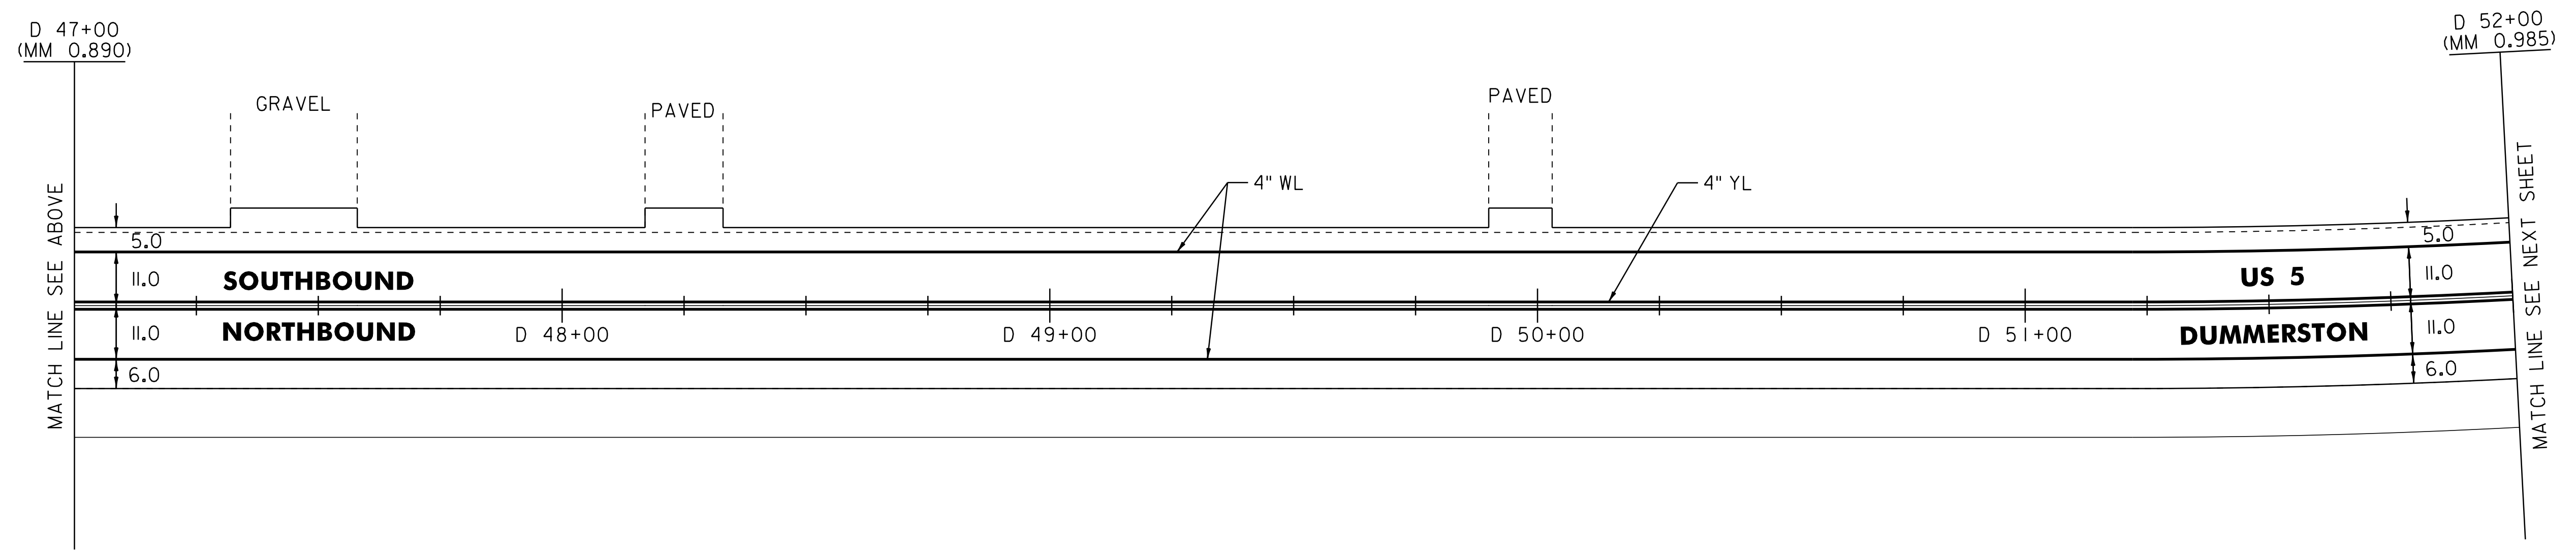


TEMPORARY 4" WHITE LINE, PAINT
 PAINTED DURABLE 4" WHITE LINE, THERMOPLASTIC
 D 42+00 TO D 52+00 SOLID LT & RT

TEMPORARY 4" YELLOW LINE, PAINT
 PAINTED DURABLE 4" YELLOW LINE, THERMOPLASTIC
 D 42+00 TO D 52+00 SOLID LT & RT

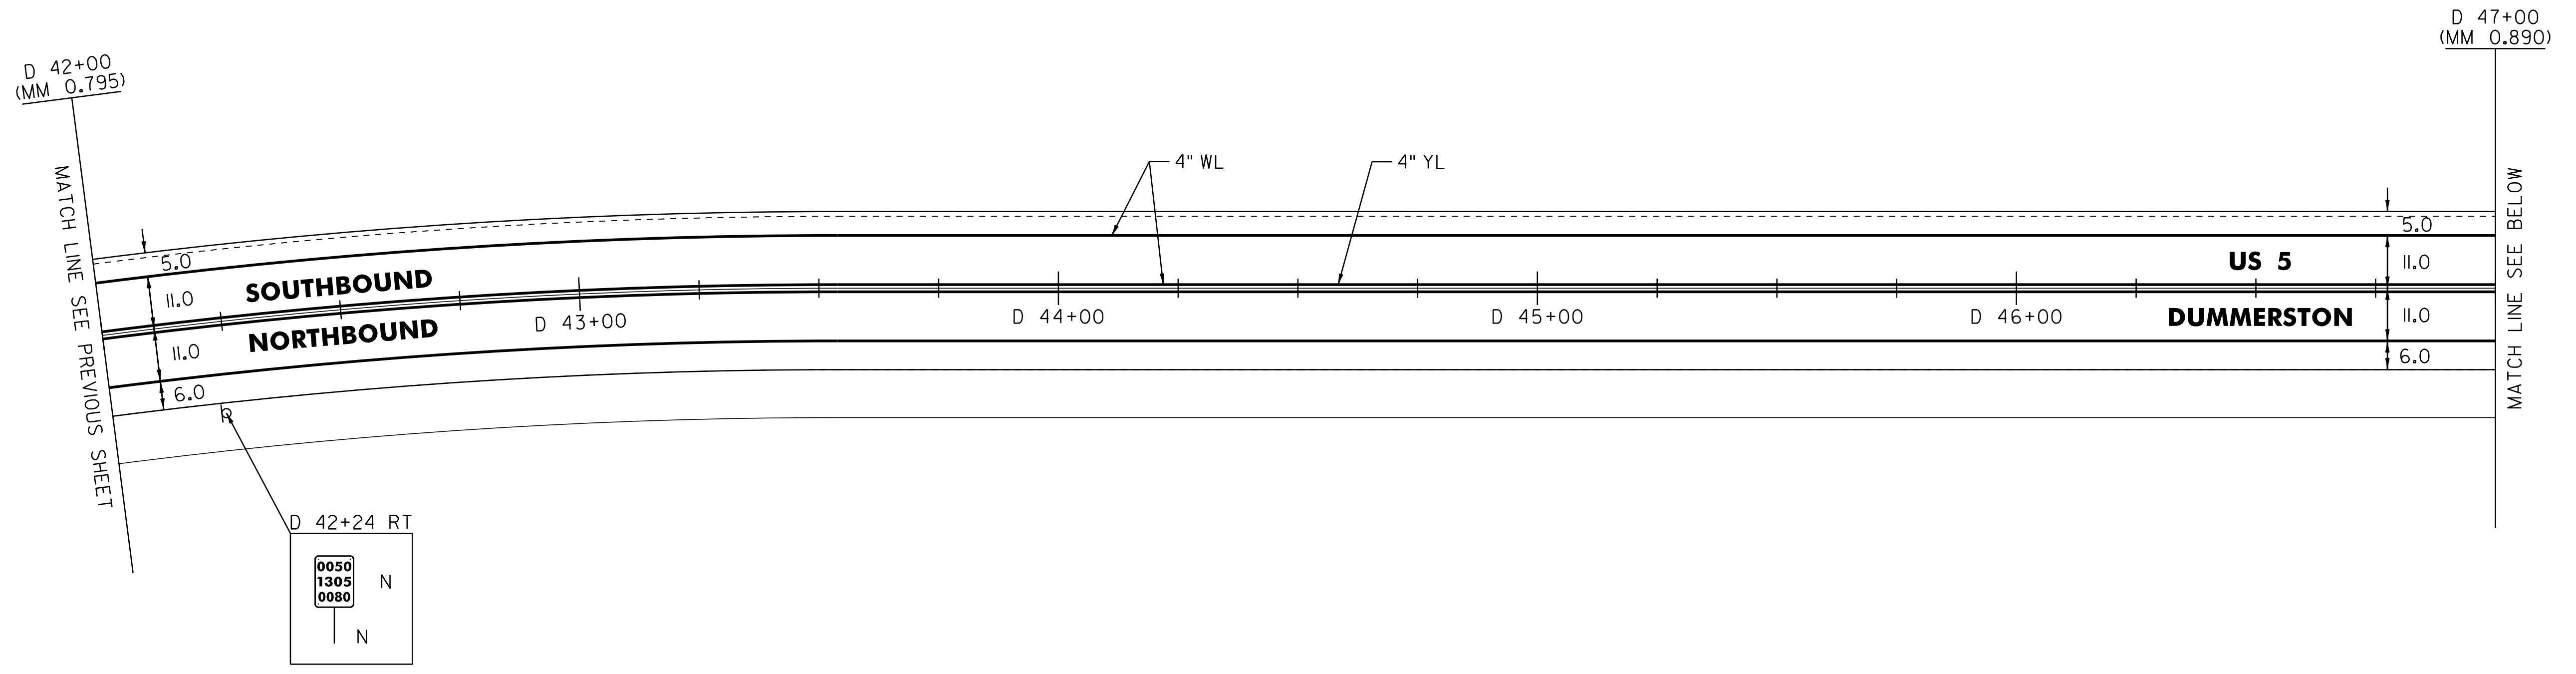

- LEGEND**
- R = REMOVE EXISTING
 - S = SALVAGE
 - R&S = REMOVE AND SALVAGE
 - N = NEW
 - RET = RETAIN
 - B-B = BACK TO BACK
 - = EXISTING GUARDRAIL
 - = PROPOSED GUARDRAIL
 - YL = YELLOW LINE
 - WL = WHITE LINE
 - ⊙ = DELINEATOR

ROADWAY LAYOUT 28 US 5	
PROJECT NAME: BRATTLEBORO-PUTNEY	PROJECT NUMBER: STP 2310(I)
FILE NAME: /pave/01c032/pc032	PLOT DATE: 02-MAY-2012 17:2
PROJECT LEADER: PTS	DRAWN BY: WWG
DESIGNED BY: NLL	CHECKED BY: NLL/PTS
IPARM FILE NAME: 01C032.52	SHEET 52 OF 118

NOT TO SCALE