

TEMPORARY 4" WHITE LINE, PAINT
~~PAINTED DURABLE 4" WHITE LINE, THERMOPLASTIC~~
 D 78+00 TO D 79+25 SOLID RT
 D 78+00 TO D 83+00 SOLID LT
 D 80+03 TO D 83+00 SOLID RT

TEMPORARY 4" YELLOW LINE, PAINT
~~PAINTED DURABLE 4" YELLOW LINE, THERMOPLASTIC~~
 D 78+00 TO D 79+32 SOLID LT & RT
 D 79+72 TO D 83+00 SOLID LT & RT

REMOVAL AND DISPOSAL OF GUARDRAIL
 D 80+35 TO D 82+60 RT

ANCHORS FOR STEEL BEAM GUARDRAIL
 STEEL BEAM GUARDRAIL, GALVANIZED
 D 80+72.5 TO D 82+22.5 RT
 35 60

~~MANUFACTURED TERMINAL SECTION, FLARED~~
 D 80+35.0 TO D 80+72.5 RT
 D 82+22.5 TO D 82+60.0 RT


DELINEATOR WITH STEEL POST
 D 80+35 RT
 D 82+60 RT

STONE FILL, TYPE I
~~D 80+28 LT~~
 D 79+26 RT

REMOVING SIGNS
 AS SHOWN - 10

ERECTING SALVAGED SIGNS
 AS SHOWN - 4

BITUMINOUS GUTTERS
 AND TRAFFIC ISLANDS
 D 78+00 TO 80+28 LT

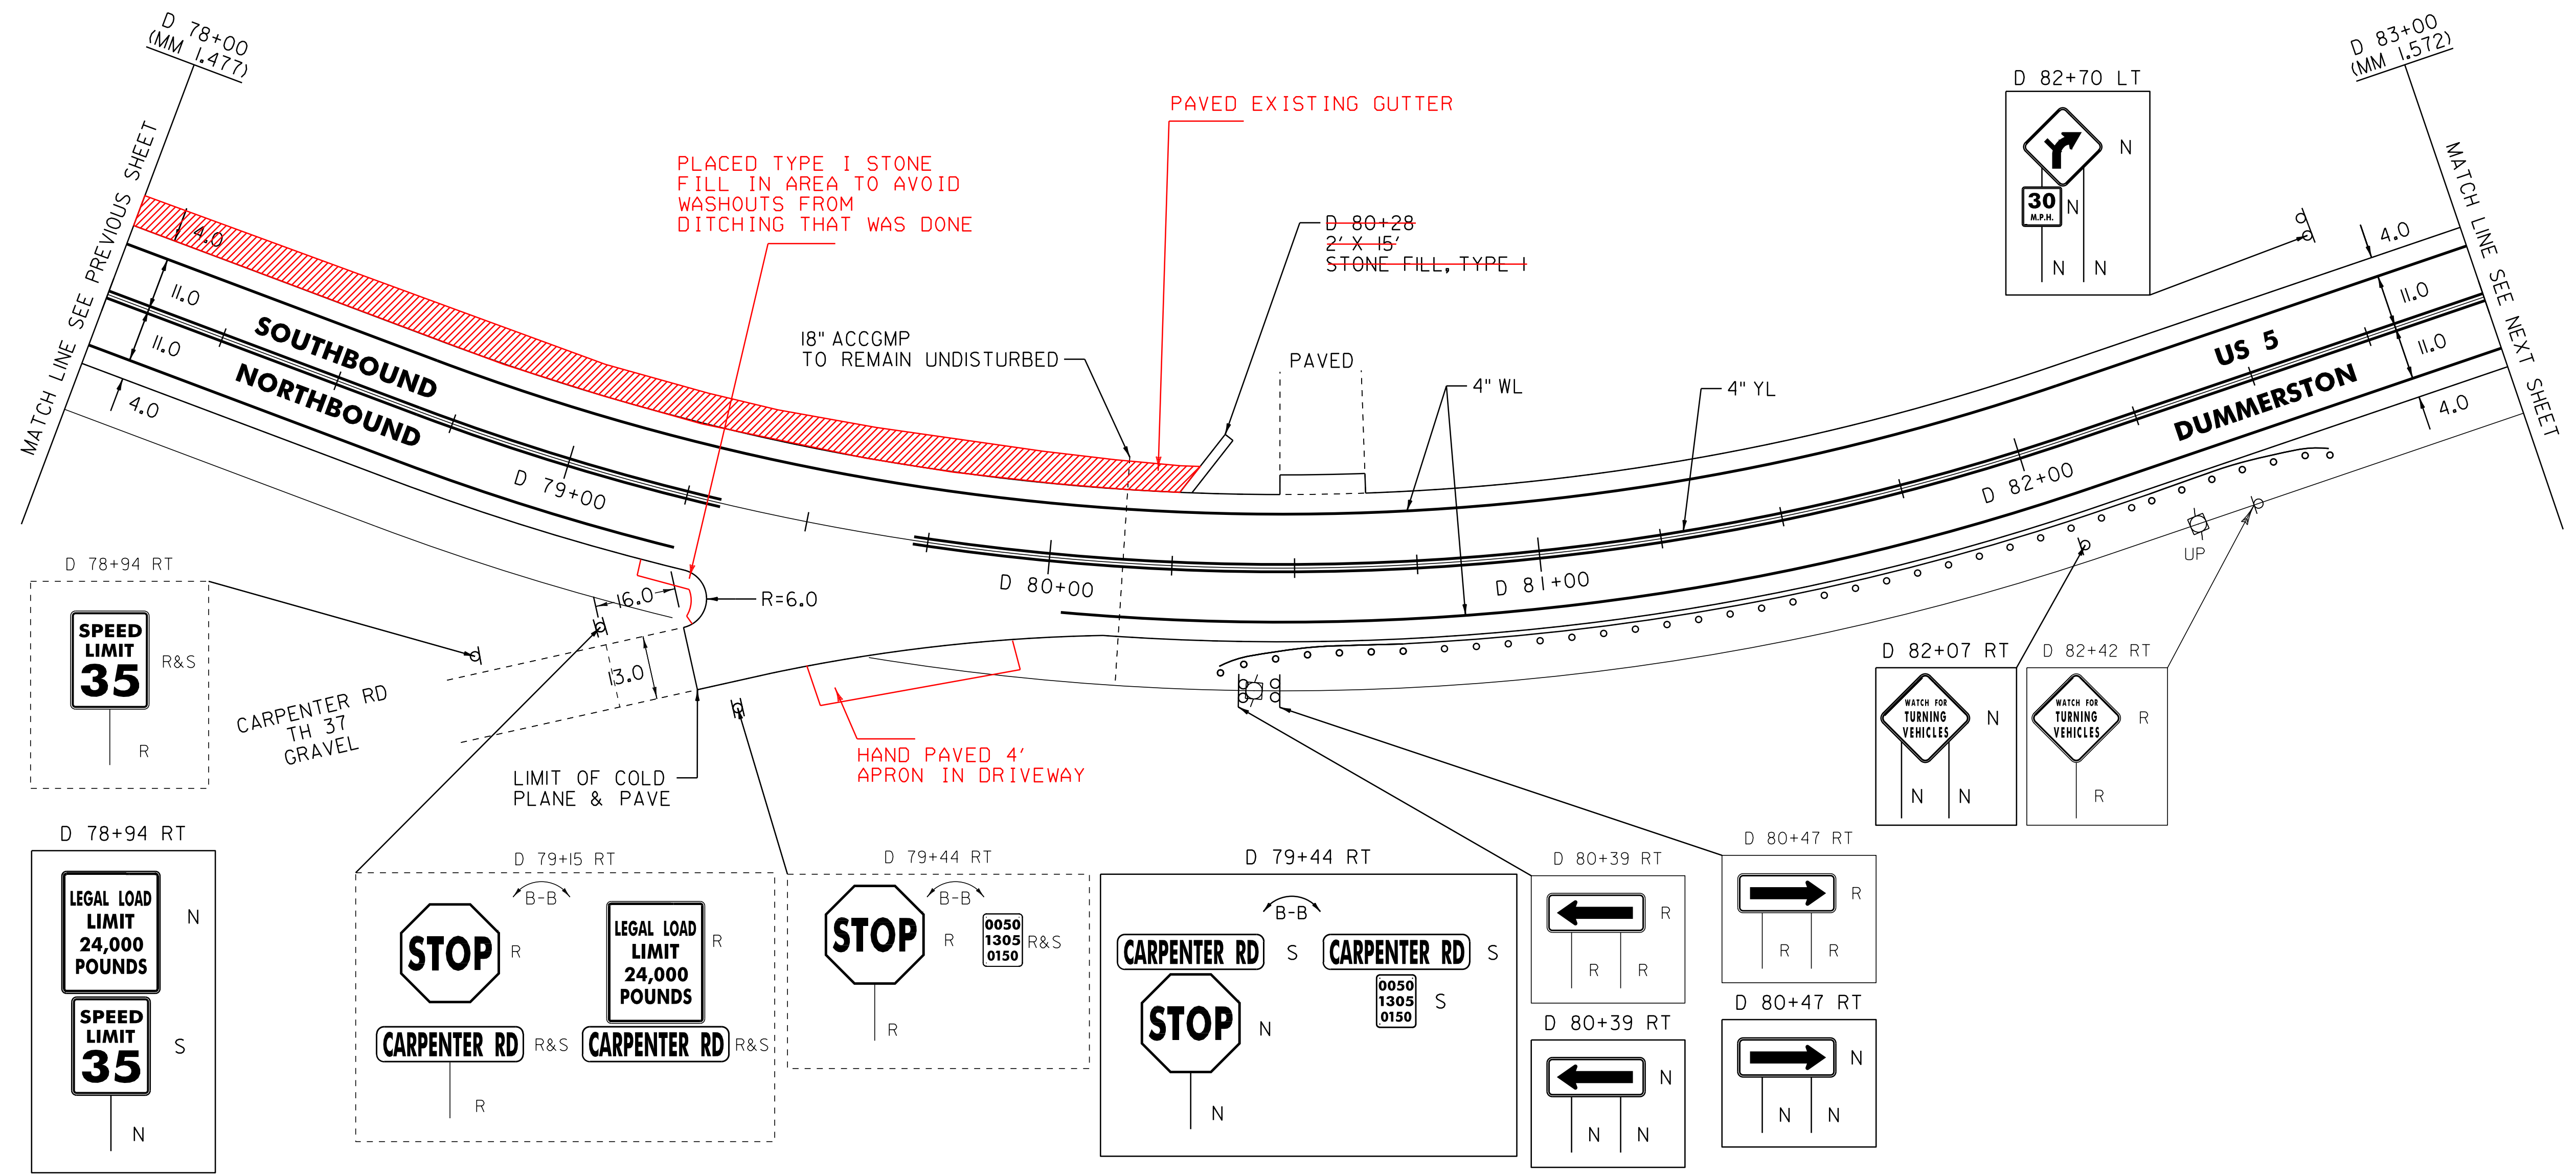

LEGEND

- R = REMOVE EXISTING
- S = SALVAGE
- R&S = REMOVE AND SALVAGE
- N = NEW
- RET = RETAIN
- B-B = BACK TO BACK
- = EXISTING GUARDRAIL
- = PROPOSED GUARDRAIL
- YL = YELLOW LINE
- WL = WHITE LINE
- ⊙ = DELINEATOR

ROADWAY LAYOUT 32 US 5

PROJECT NAME: BRATTLEBORO-PUTNEY	PLOT DATE: 02-MAY-2012 17:2
PROJECT NUMBER: STP 2310(I)	DRAWN BY: WWG
FILE NAME: /pave/01c032/pc032	CHECKED BY: NLL/PTS
DESIGNED BY: NLL	SHEET 56 OF 118
IPARM FILE NAME: 01C032.56	

NOT TO SCALE