

PAINTED DURABLE 4" WHITE LINE, PAINT
 D 124+50 TO D 129+93 SOLID LT
 D 124+50 TO D 134+50 SOLID RT
 D 129+93 TO D 130+25 SOLID LT (TH 1)
 D 130+56 TO D 130+78 SOLID LT (TH 1)
 D 130+78 TO D 134+50 SOLID LT

PAINTED DURABLE 24" STOP BAR, PAINT
 D 130+13 TO 130+30 LT (TH 1)

TEMPORARY LETTER OR SYMBOL, PAINT
 DURABLE LETTER OR SYMBOL, THERMOPLASTIC
 D 130+26 LT - STOP (TH 1)


REHAB. DROP INLETS, CATCH BASINS,
 OR MANHOLES, CLASS I, II, OR III
 D 127+35 LT (OTDI)

BITUMINOUS CONCRETE GUTTERS
 AND TRAFFIC ISLANDS
 D 131+25 TO 134+50 LT
 D 131+50 TO 134+50 RT

PAINTED DURABLE 4" YELLOW LINE, THERMOPLASTIC
 D 124+50 TO D 130+10 SOLID LT & RT
 D 130+31 DOUBLE SOLID LT (TH 1)
 D 130+50 TO D 132+85 SOLID LT & RT
 D 132+85 TO D 134+50 SOLID LT, DASHED RT

THINNING AND TRIMMING FOR SIGNS
 (-SEE DETAIL ON SHEET 6)
 D 127+99 RT

REMOVING SIGNS
 AS SHOWN - 5

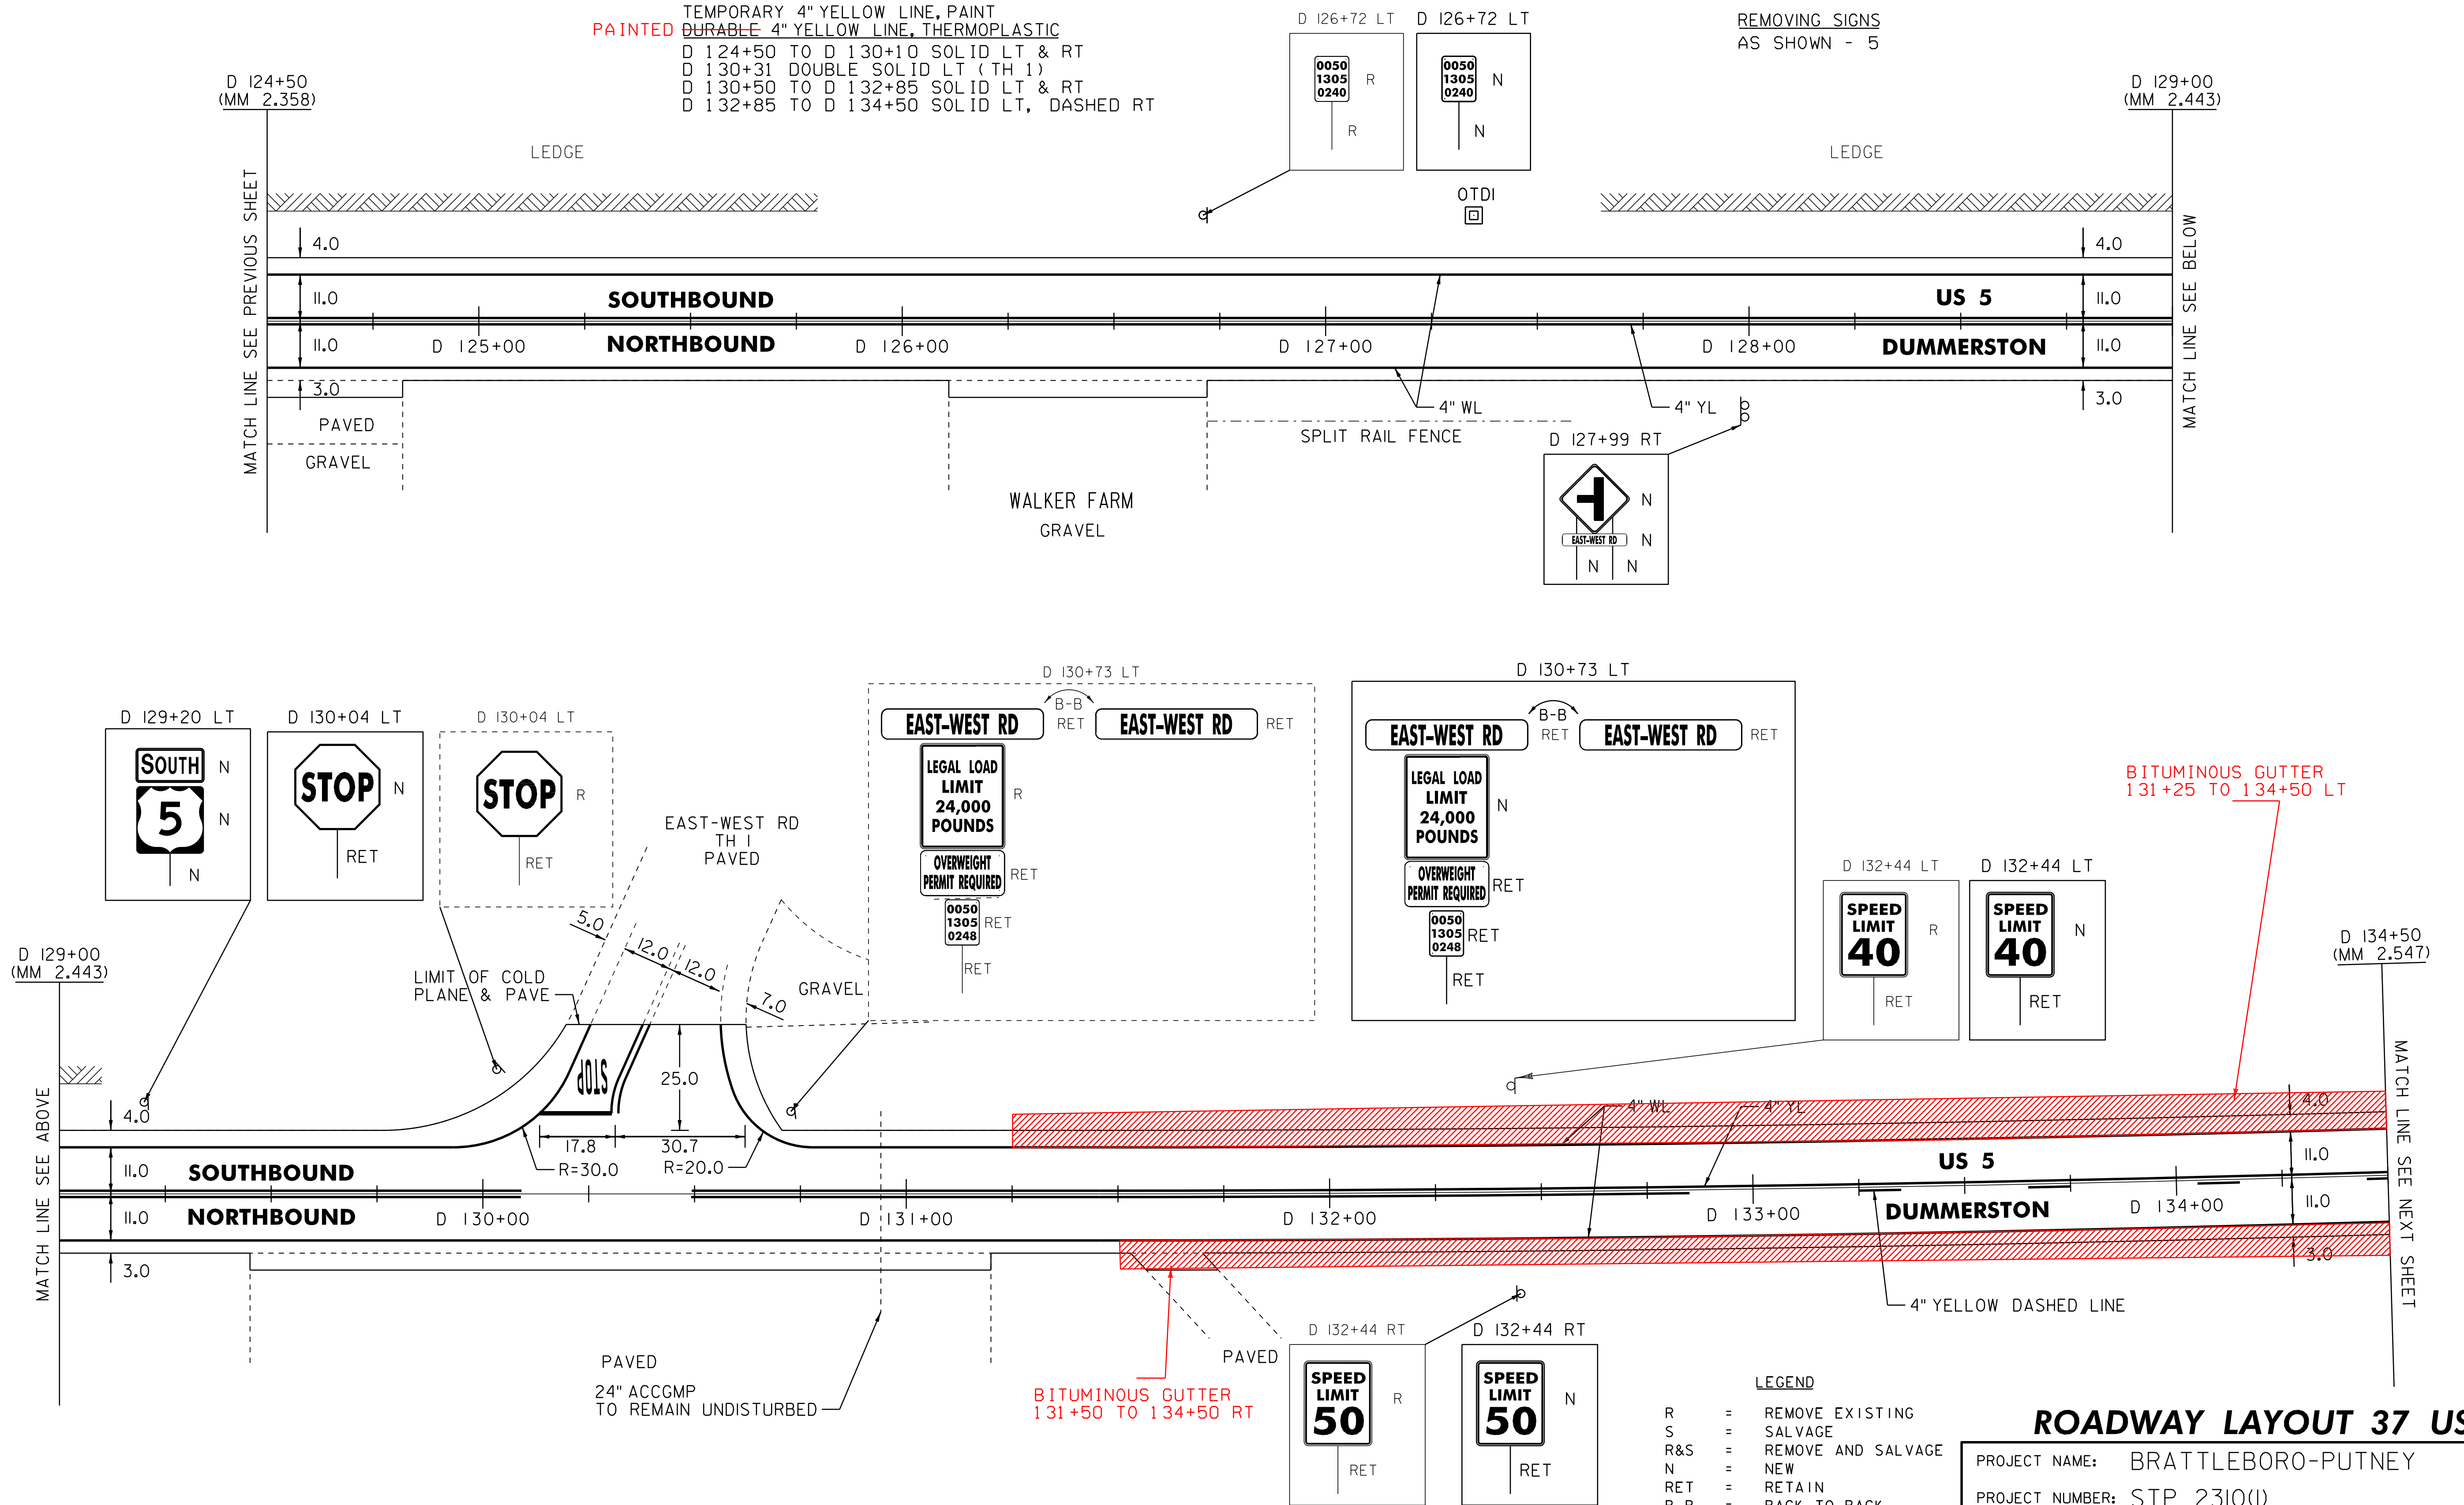

NOT TO SCALE

- LEGEND
- R = REMOVE EXISTING
 - S = SALVAGE
 - R&S = REMOVE AND SALVAGE
 - N = NEW
 - RET = RETAIN
 - B-B = BACK TO BACK
 - - - = EXISTING GUARDRAIL
 - ⊕ = PROPOSED GUARDRAIL
 - YL = YELLOW LINE
 - WL = WHITE LINE
 - ⊙ = DELINEATOR

ROADWAY LAYOUT 37 US 5

PROJECT NAME: BRATTLEBORO-PUTNEY
 PROJECT NUMBER: STP 2310(I)

FILE NAME: /pave/01c032/pc032
 PROJECT LEADER: PTS
 DESIGNED BY: NLL
 IPARM FILE NAME: 01C032.61

PLOT DATE: 02-MAY-2012 17:2
 DRAWN BY: WWG
 CHECKED BY: NLL/PTS
 SHEET 61 OF 118