

TEMPORARY 4" WHITE LINE, PAINT  
**PAINTED DURABLE 4" WHITE LINE, THERMOPLASTIC**  
 D 134+50 TO 145+50 SOLID LT & RT

TEMPORARY 4" YELLOW LINE, PAINT  
**PAINTED DURABLE 4" YELLOW LINE, THERMOPLASTIC**  
 D 134+50 TO D 140+15 SOLID LT, DASHED RT  
 D 140+15 TO D 143+30 DASHED RT  
 D 143+30 TO D 145+50 DASHED LT, SOLID RT

REMOVAL AND DISPOSAL OF GUARDRAIL  
 D 139+04 TO D 145+50 LT  
 D 140+54 TO D 145+50 RT

STEEL BEAM GUARDRAIL, GALVANIZED  
 D 139+42.0 TO D 145+50 LT  
 D 140+54.0 TO D 145+50 RT

MANUFACTURED TERMINAL SECTION, FLARED  
 D 139+04.5 TO D 139+42.0 LT


DELINEATOR WITH STEEL POST  
 D 139+04.5 LT

ANCHOR FOR STEEL BEAM RAIL  
 D 140+54 RT

BITUMINOUS CONCRETE CURB, TYPE A  
 D 139+85 TO D 141+90 LT  
 D 141+10 TO D 145+50 RT  
 D 141+94 TO D 145+50 LT


REHAB. DROP INLETS, CATCH BASINS,  
 OR MANHOLES, CLASS I, II, OR III  
 D 141+92 LT (CB)  
 D 141+92 RT (CB)  
 D 145+10 RT (DI)

REMOVING SIGNS  
 AS SHOWN - 4

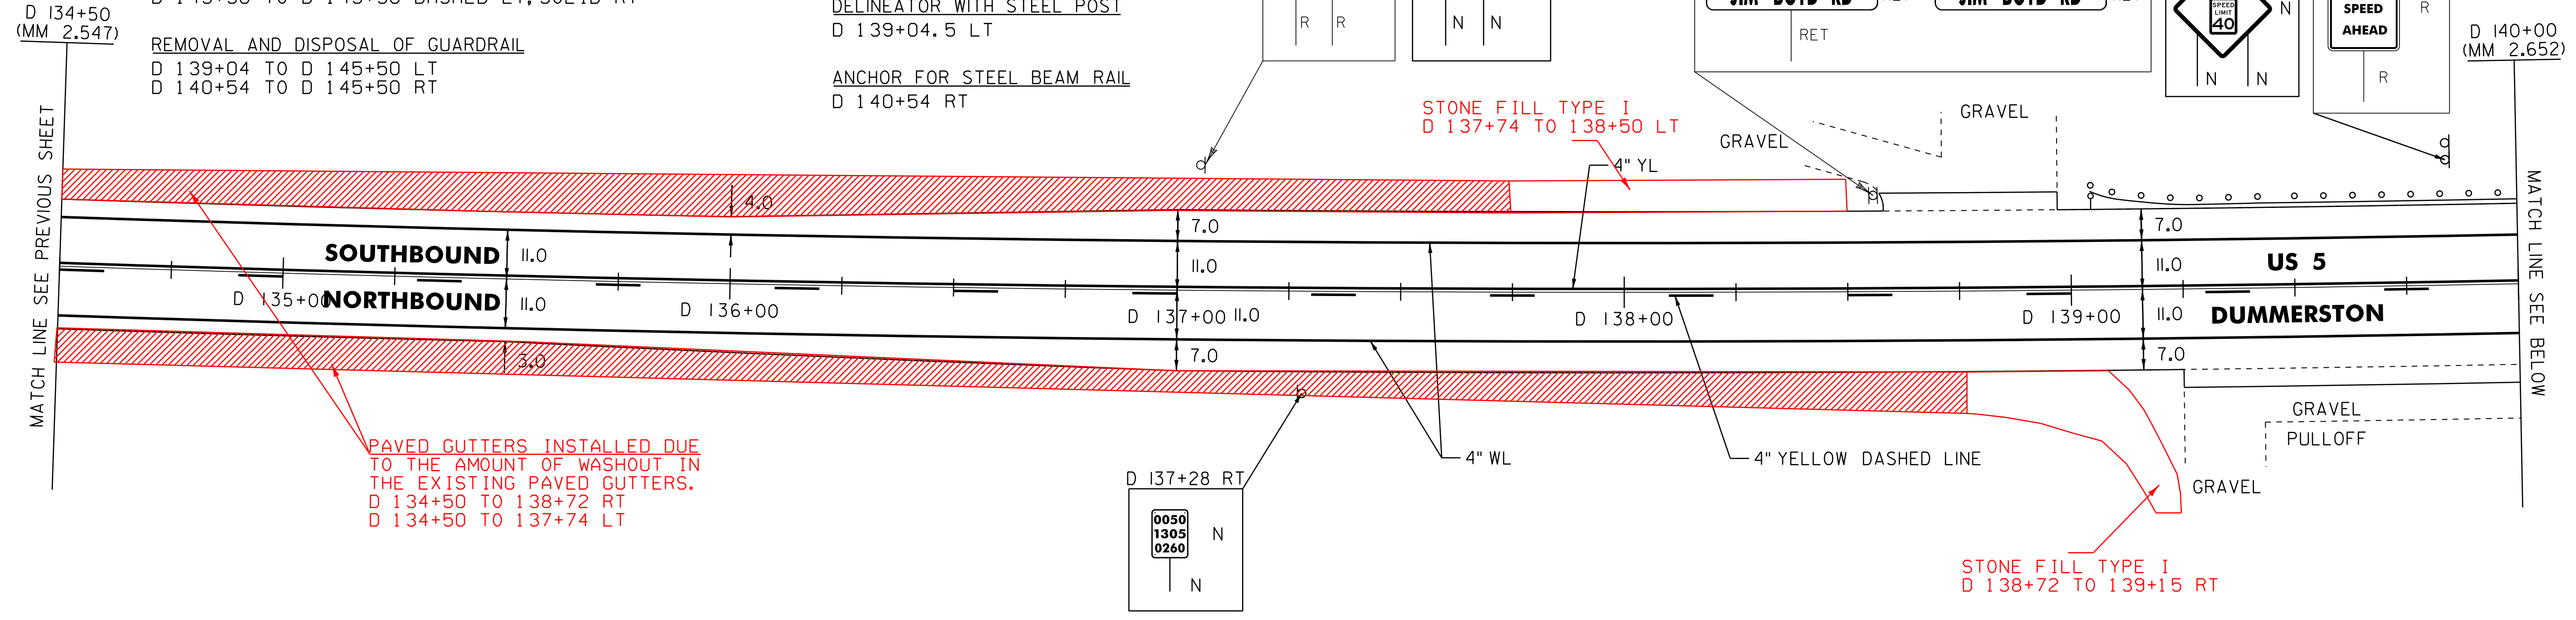

STONE FILL, TYPE I  
 D 137+74 TO 138+50 LT  
 D 138+72 TO 139+15 RT

BITUMINOUS GUTTERS  
 AND TRAFFIC ISLANDS  
 D 134+50 TO 137+74 LT  
 D 134+50 TO 138+72 RT

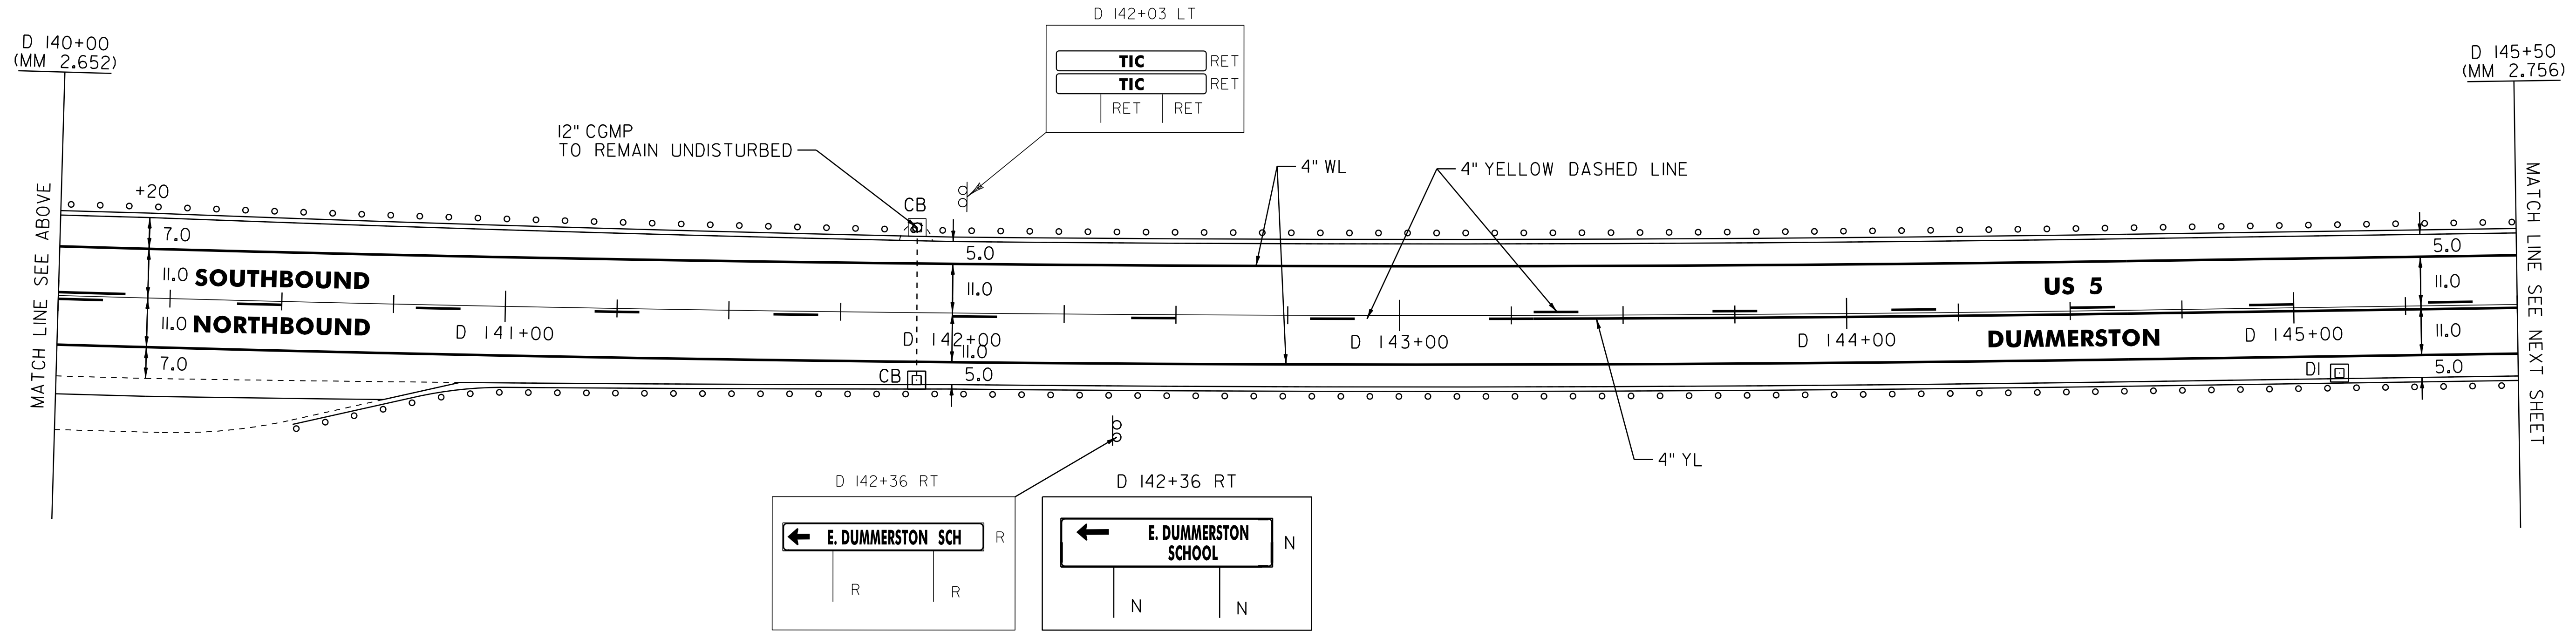

- LEGEND**
- R = REMOVE EXISTING
  - S = SALVAGE
  - R&S = REMOVE AND SALVAGE
  - N = NEW
  - RET = RETAIN
  - B-B = BACK TO BACK
  - = EXISTING GUARDRAIL
  - = PROPOSED GUARDRAIL
  - YL = YELLOW LINE
  - WL = WHITE LINE
  - o = DELINEATOR

**ROADWAY LAYOUT 38 US 5**

PROJECT NAME: BRATTLEBORO-PUTNEY  
 PROJECT NUMBER: STP 2310(I)

FILE NAME: /pave/01c032/pc032  
 PROJECT LEADER: PTS  
 DESIGNED BY: NLL  
 IPARM FILE NAME: OIC032.62  
 PLOT DATE: 02-MAY-2012 17:2  
 DRAWN BY: WWG  
 CHECKED BY: NLL/PTS  
 SHEET 62 OF 118

NOT TO SCALE