

604.412, 604.415, 604.418 REHAB, DROP
INLETS, CATCH BASINS, OR MANHOLES, CLASS I,
CLASS II OR CLASS III
STA. 36+55 RT "TYPE D GRATE"


Curve # 8
Delta= 40°11'29.45"
D= 11°27'32.96"
T= 182.93'
L=350.74'
R= 500.00'
BANKING 0.078 FT/FT
170' RUNOFF (40 MPH)
SEE SUPERELEVATION SHEET 1
FOR BANKING DETAIL

621.80 REMOVAL AND DISPOSAL OF GUARDRAIL
STA. 31+75.00 - STA. 32+07.50 LT
STA. 33+60.00 - STA. 36+60.00 LT
621.20 STEEL BEAM GUARDRAIL, GALVANIZED
STA. 31+75.00 - STA. 32+07.50 LT

676.10 DELINEATOR WITH STEEL POST
STA. 32+07.50 LT STA. 37+35.00 LT
STA. 33+60.00 LT

621.205 STEEL BEAM GUARDRAIL, GALVANIZED W/8 FEET POSTS
STA. 33+60.00 - STA. ~~37+35.00~~ LT
~~36+60.00~~

621.60 ANCHOR FOR STEEL BEAM RAIL
STA. 31+95.00 LT STA. ~~37+22.50~~ LT
STA. 33+60.00 LT ~~36+48.00~~

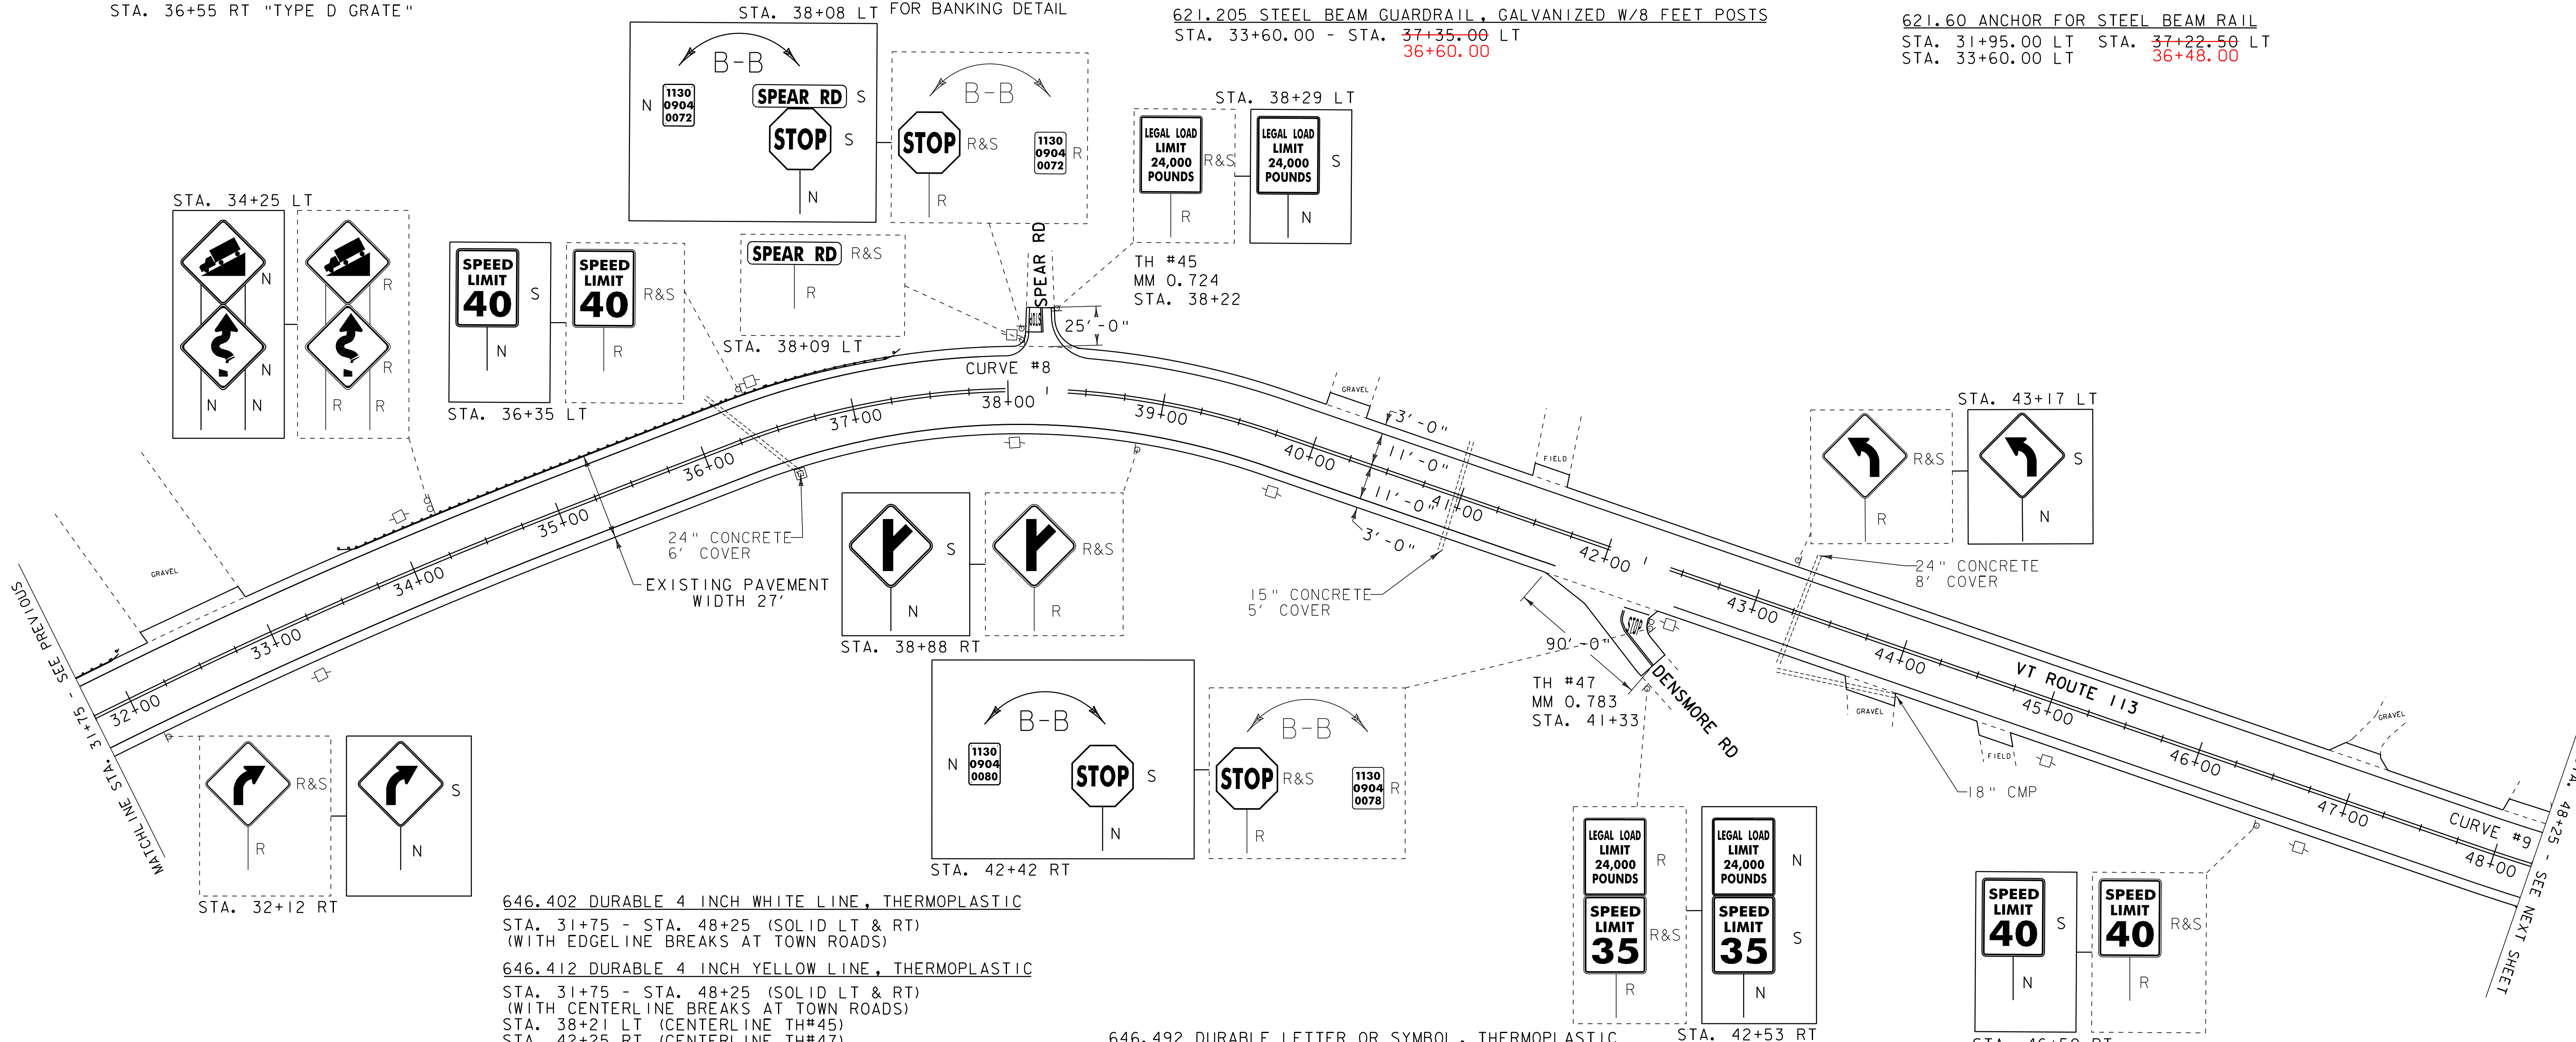

646.402 DURABLE 4 INCH WHITE LINE, THERMOPLASTIC
STA. 31+75 - STA. 48+25 (SOLID LT & RT)
(WITH EDGELINE BREAKS AT TOWN ROADS)

646.412 DURABLE 4 INCH YELLOW LINE, THERMOPLASTIC
STA. 31+75 - STA. 48+25 (SOLID LT & RT)
(WITH CENTERLINE BREAKS AT TOWN ROADS)
STA. 38+21 LT (CENTERLINE TH#45)
STA. 42+25 RT (CENTERLINE TH#47)

646.602 TEMPORARY 4 INCH WHITE LINE, PAINT
STA. 31+75 - STA. 48+25 (SOLID LT & RT)
(WITH EDGELINE BREAKS AT TOWN ROADS)

646.612 TEMPORARY 4 INCH YELLOW LINE, PAINT
STA. 31+75 - STA. 48+25 (SOLID LT & RT)
(WITH CENTERLINE BREAKS AT TOWN ROADS)
STA. 38+21 LT (CENTERLINE TH#45)
STA. 42+25 RT (CENTERLINE TH#47)

646.482 DURABLE 24 INCH STOPBAR, THERMOPLASTIC
STA. 38+11 - STA. 38+21 LT
STA. 42+25 - STA. 42+39 RT

646.682 TEMPORARY 24 INCH STOPBAR, PAINT
STA. 38+11 - STA. 38+21 LT
STA. 42+25 - STA. 42+39 RT

646.492 DURABLE LETTER OR SYMBOL, THERMOPLASTIC
STA. 38+15 LT "STOP"
STA. 42+40 RT "STOP"

646.692 TEMPORARY LETTER OR SYMBOL, PAINT
STA. 38+15 LT "STOP"
STA. 42+40 RT "STOP"

675.50 REMOVING SIGNS
AS SHOWN - 15

675.60 ERECTING SALVAGED SIGNS
AS SHOWN - 10

SIGN LEGEND
R = REMOVE
R&S = REMOVE AND SALVAGE
S = SALVAGE
RET = RETAIN
N = NEW
B-B = BACK TO BACK

LEGEND
□ = UTILITY POLE
○ = HYDRANT
⊗ = CATCH BASIN / DROP INLET

NOT TO SCALE

PROJECT LAYOUT SHEET 3	PROJECT NAME: CHelsea-VERSHIRE	PLOT DATE: 28-OCT-2011 13:36
	PROJECT NUMBER: STP 2331(1)S	DRAWN BY: BMB
	FILE NAME: 01c040.dgn	DESIGNED BY: BMB
	PROJECT LEADER: CDL	CHECKED BY: EPD
	PLOT FILE: 01c040_18.1	SHEET 18 OF 55