


646.402 DURABLE 4 INCH WHITE LINE, THERMOPLASTIC
 STA. 145+25 - STA. 161+25 (SOLID LT & RT)
 646.412 DURABLE 4 INCH YELLOW LINE, THERMOPLASTIC
 STA. 145+25 - STA. 161+25 (SOLID LT & RT)
 646.602 TEMPORARY 4 INCH WHITE LINE, PAINT
 STA. 145+25 - STA. 161+25 (SOLID LT & RT)
 646.612 TEMPORARY 4 INCH YELLOW LINE, PAINT
 STA. 145+25 - STA. 161+25 (SOLID LT & RT)

675.50 REMOVING SIGNS
 AS SHOWN - 2

604.412, 604.415, 604.418 REHAB, DROP
 INLETS, CATCH BASINS, OR MANHOLES, CLASS I,
 CLASS II OR CLASS III
 STA. 151+42 LT "TYPE D GRATE"


621.20 STEEL BEAM GUARDRAIL, GALVANIZED
 STA. 145+25.00 - STA. 153+37.50 RT
 STA. 158+62.50 - STA. 160.62.50 RT
 621.50 MANUFACTURED TERMINAL SECTION, FLARED
 STA. 153+37.50 - STA. 153+75.00 RT
 STA. 158+25.00 - STA. 158+62.50 RT
 STA. 160+62.50 - STA. 161+00.00 RT

676.10 DELINEATOR WITH STEEL POST
 STA. 153+75.00 RT
 STA. 158+25.00 RT
 STA. 161+00.00 RT

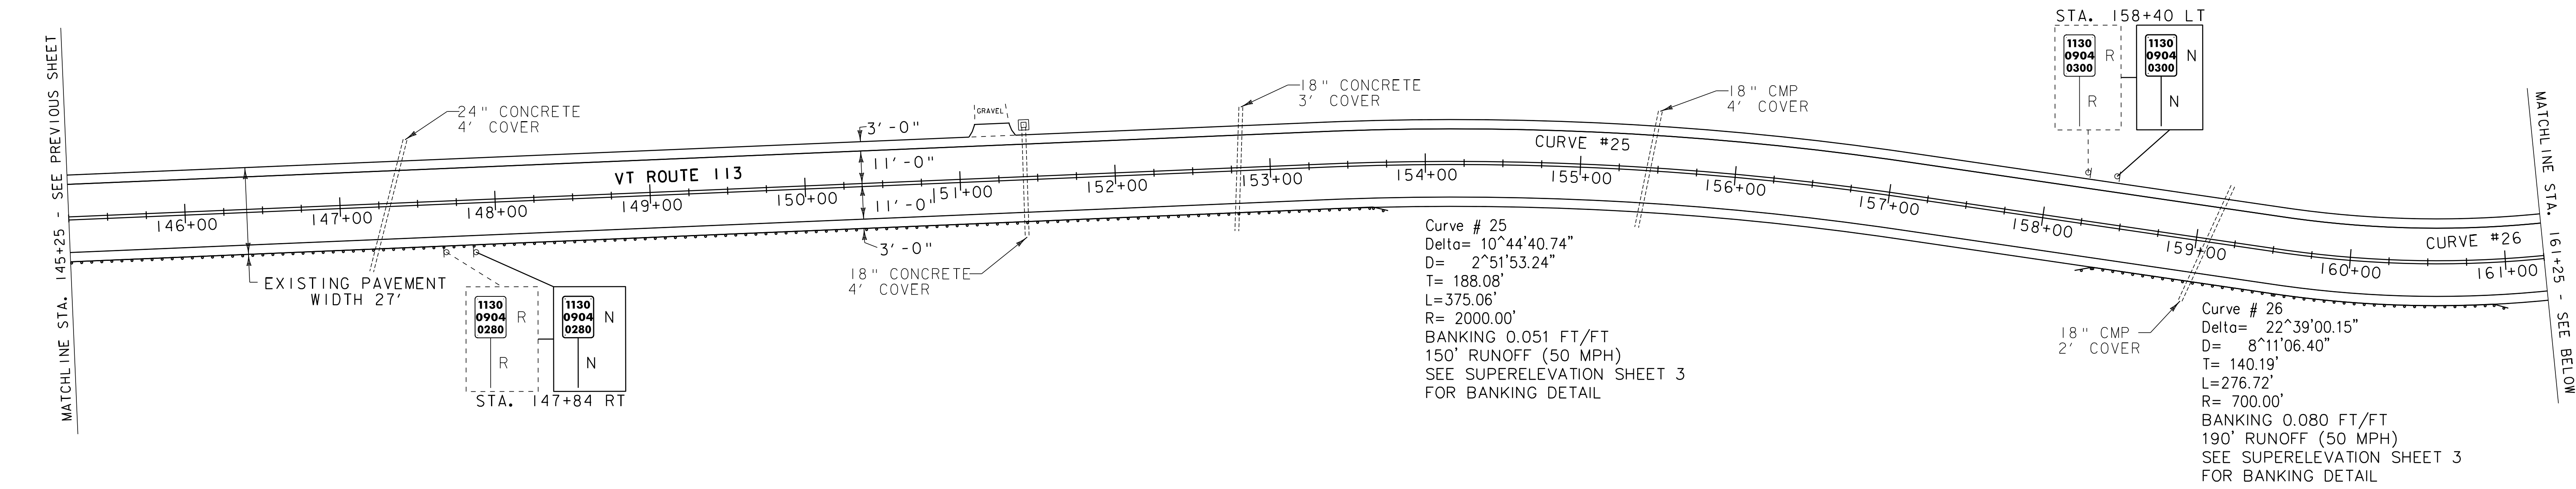

646.402 DURABLE 4 INCH WHITE LINE, THERMOPLASTIC
 STA. 161+25 - STA. 177+25 (SOLID LT & RT)
 646.412 DURABLE 4 INCH YELLOW LINE, THERMOPLASTIC
 STA. 161+25 - STA. 177+25 (SOLID LT & RT)
 646.602 TEMPORARY 4 INCH WHITE LINE, PAINT
 STA. 161+25 - STA. 177+25 (SOLID LT & RT)
 646.612 TEMPORARY 4 INCH YELLOW LINE, PAINT
 STA. 161+25 - STA. 177+25 (SOLID LT & RT)

675.50 REMOVING SIGNS
 AS SHOWN - 3

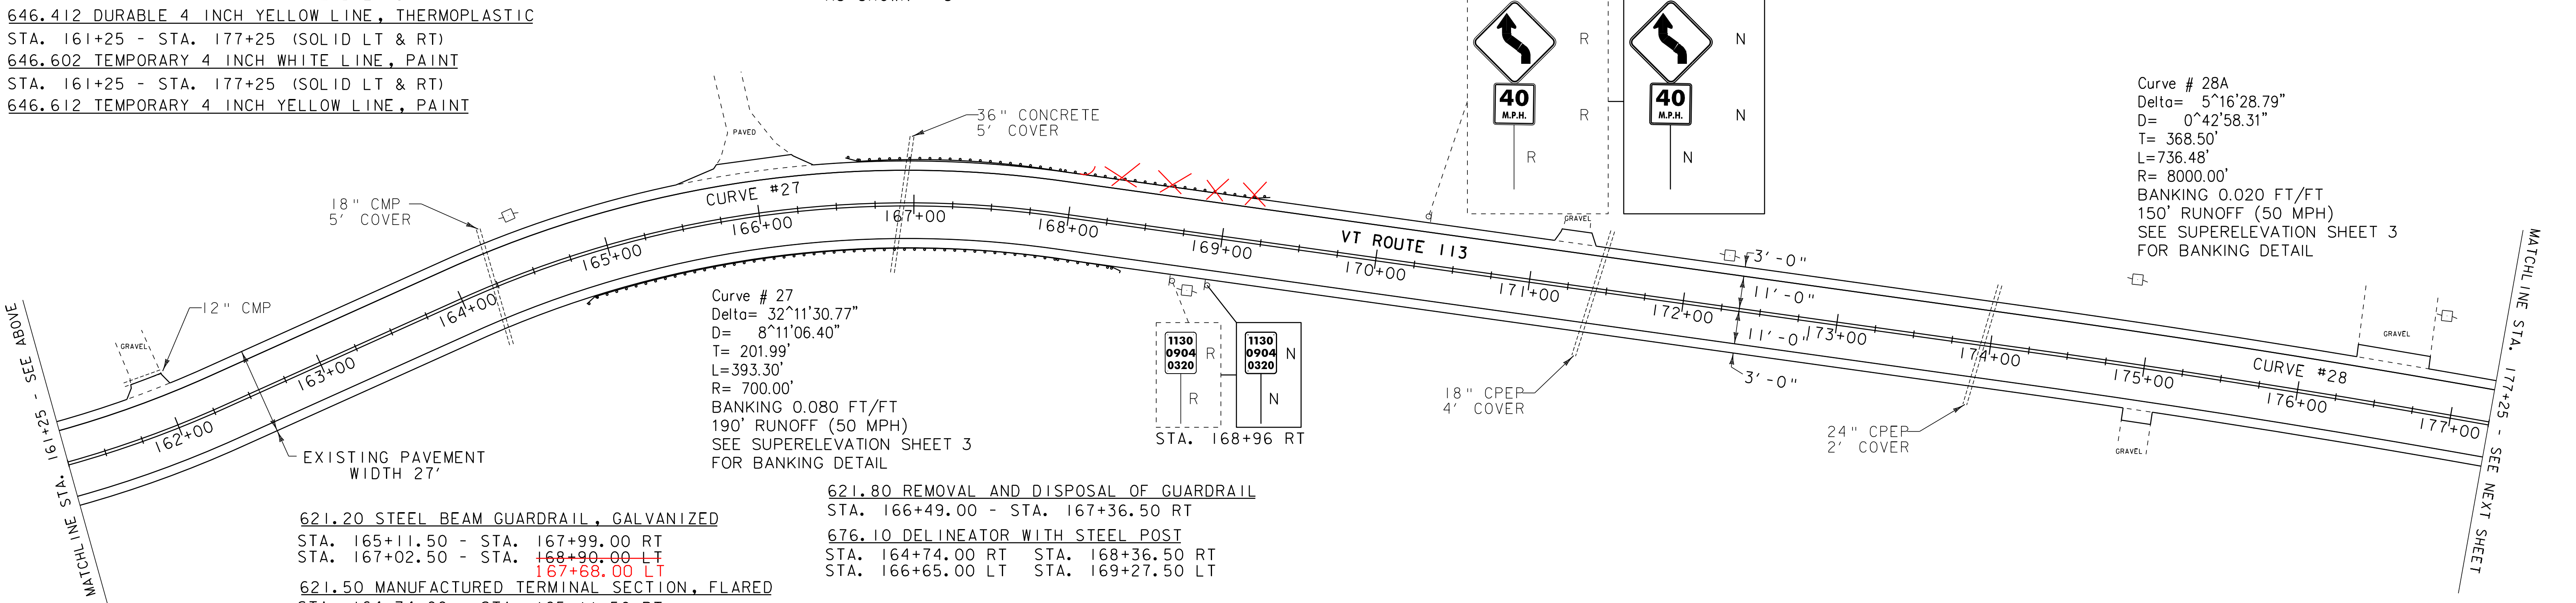

621.20 STEEL BEAM GUARDRAIL, GALVANIZED

STA. 165+11.50 - STA. 167+99.00 RT
 STA. 167+02.50 - STA. 168+90.00 LT
 STA. 167+68.00 LT

621.50 MANUFACTURED TERMINAL SECTION, FLARED

STA. 164+74.00 - STA. 165+11.50 RT
 STA. 166+65.00 - STA. 167+02.50 LT
 STA. 167+99.00 - STA. 168+36.50 RT
 STA. 168+90.00 - STA. 169+27.50 LT
 STA. 167+68.00 - STA. 168+05.50 LT

621.80 REMOVAL AND DISPOSAL OF GUARDRAIL

STA. 166+49.00 - STA. 167+36.50 RT

676.10 DELINEATOR WITH STEEL POST

STA. 164+74.00 RT STA. 168+36.50 RT
 STA. 166+65.00 LT STA. 169+27.50 LT

SIGN LEGEND
 R = REMOVE
 R&S = REMOVE AND SALVAGE
 S = SALVAGE
 RET = RETAIN
 N = NEW
 B-B = BACK TO BACK

LEGEND
 □ = UTILITY POLE
 ⊙ = HYDRANT
 ⊠ = CATCH BASIN / DROP INLET

NOT TO SCALE

PROJECT LAYOUT SHEET 7

PROJECT NAME: CHLSEA-VERSHIRE	PLOT DATE: 28-OCT-2011 13:36
PROJECT NUMBER: STP 2331(1)S	DRAWN BY: BMB
FILE NAME: 01c040.dgn	CHECKED BY: EPD
PROJECT LEADER: CDL	SHEET 22 OF 55
DESIGNED BY: BMB	
PLOT FILE: 01c040_22.i	