



646.402 DURABLE 4 INCH WHITE LINE, THERMOPLASTIC  
 STA. 43+50 - STA. 59+25 (SOLID LT & RT)  
 646.412 DURABLE 4 INCH YELLOW LINE, THERMOPLASTIC  
 STA. 43+50 - STA. 59+25 (SOLID LT & RT)  
 646.602 TEMPORARY 4 INCH WHITE LINE, PAINT  
 STA. 43+50 - STA. 59+25 (SOLID LT & RT)  
 646.612 TEMPORARY 4 INCH YELLOW LINE, PAINT  
 STA. 43+50 - STA. 59+25 (SOLID LT & RT)

675.50 REMOVING SIGNS  
 AS SHOWN - 7  
 675.60 ERECTING SALVAGED SIGNS  
 AS SHOWN - 7

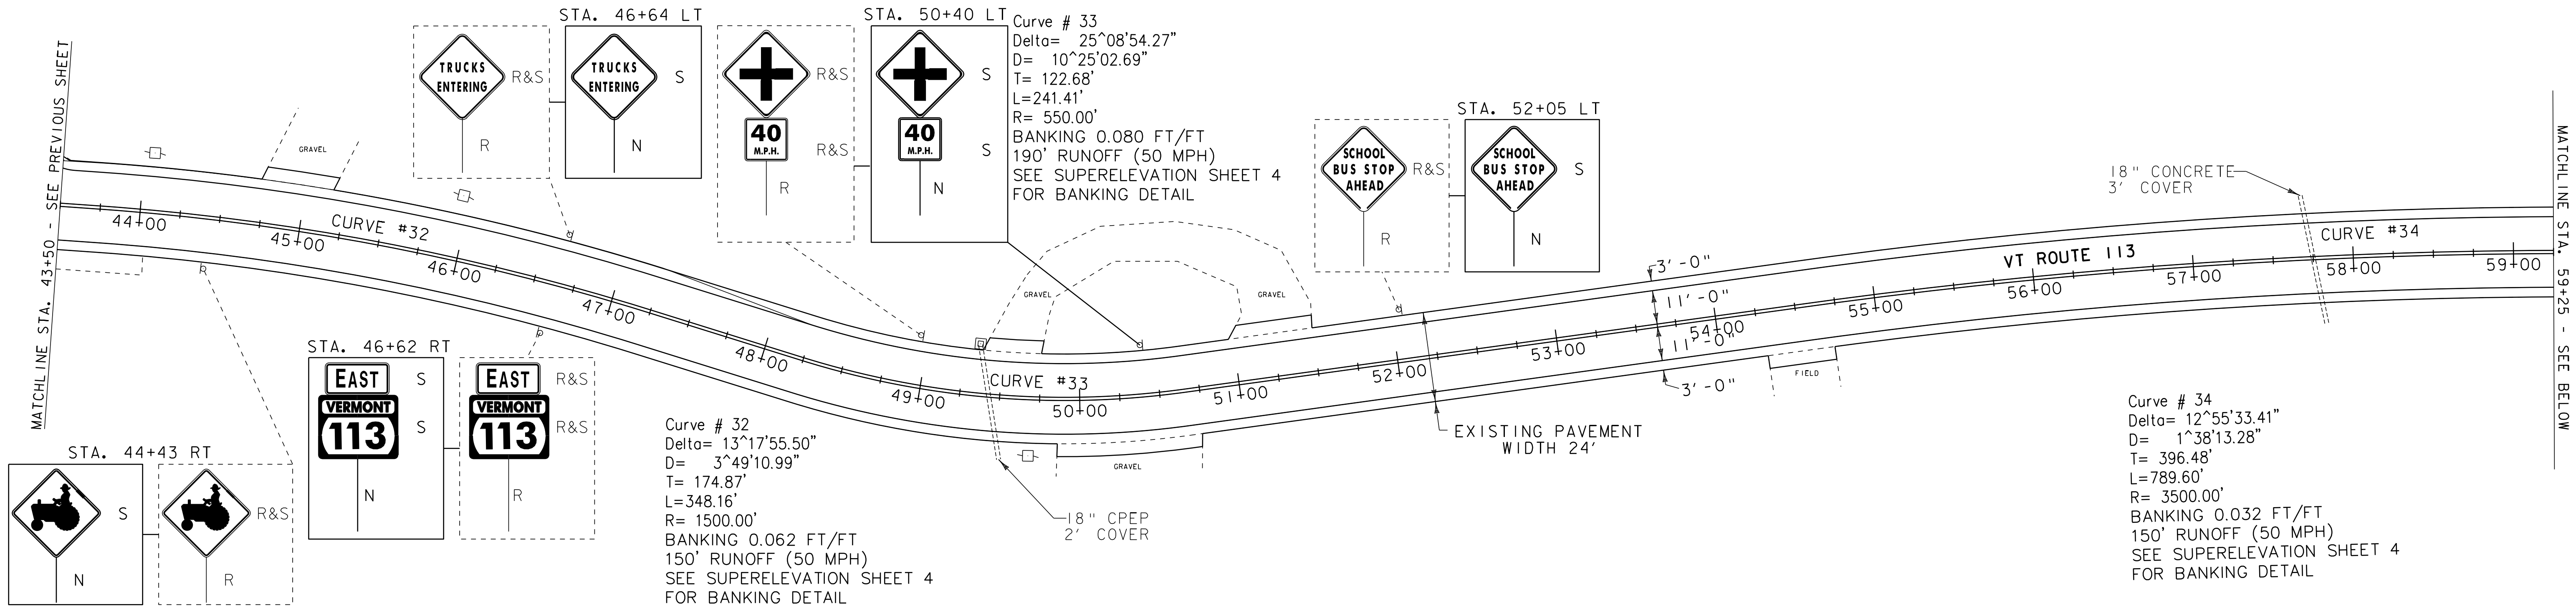

646.402 DURABLE 4 INCH WHITE LINE, THERMOPLASTIC  
 STA. 59+25 - STA. 74+75 (SOLID LT & RT)  
 646.412 DURABLE 4 INCH YELLOW LINE, THERMOPLASTIC  
 STA. 59+25 - STA. 74+75 (SOLID LT)  
 STA. 59+25 - STA. 67+32 (SOLID RT)  
 STA. 67+32 - STA. 73+39 (DASHED RT)  
 STA. 73+39 - STA. 74+75 (SOLID RT)  
 646.602 TEMPORARY 4 INCH WHITE LINE, PAINT  
 STA. 59+25 - STA. 74+75 (SOLID LT & RT)  
 646.612 TEMPORARY 4 INCH YELLOW LINE, PAINT  
 STA. 59+25 - STA. 74+75 (SOLID LT)  
 STA. 59+25 - STA. 67+32 (SOLID RT)  
 STA. 67+32 - STA. 73+39 (DASHED RT)  
 STA. 73+39 - STA. 74+75 (SOLID RT)

675.50 REMOVING SIGNS  
 AS SHOWN - 3  
 675.60 ERECTING SALVAGED SIGNS  
 AS SHOWN - 2

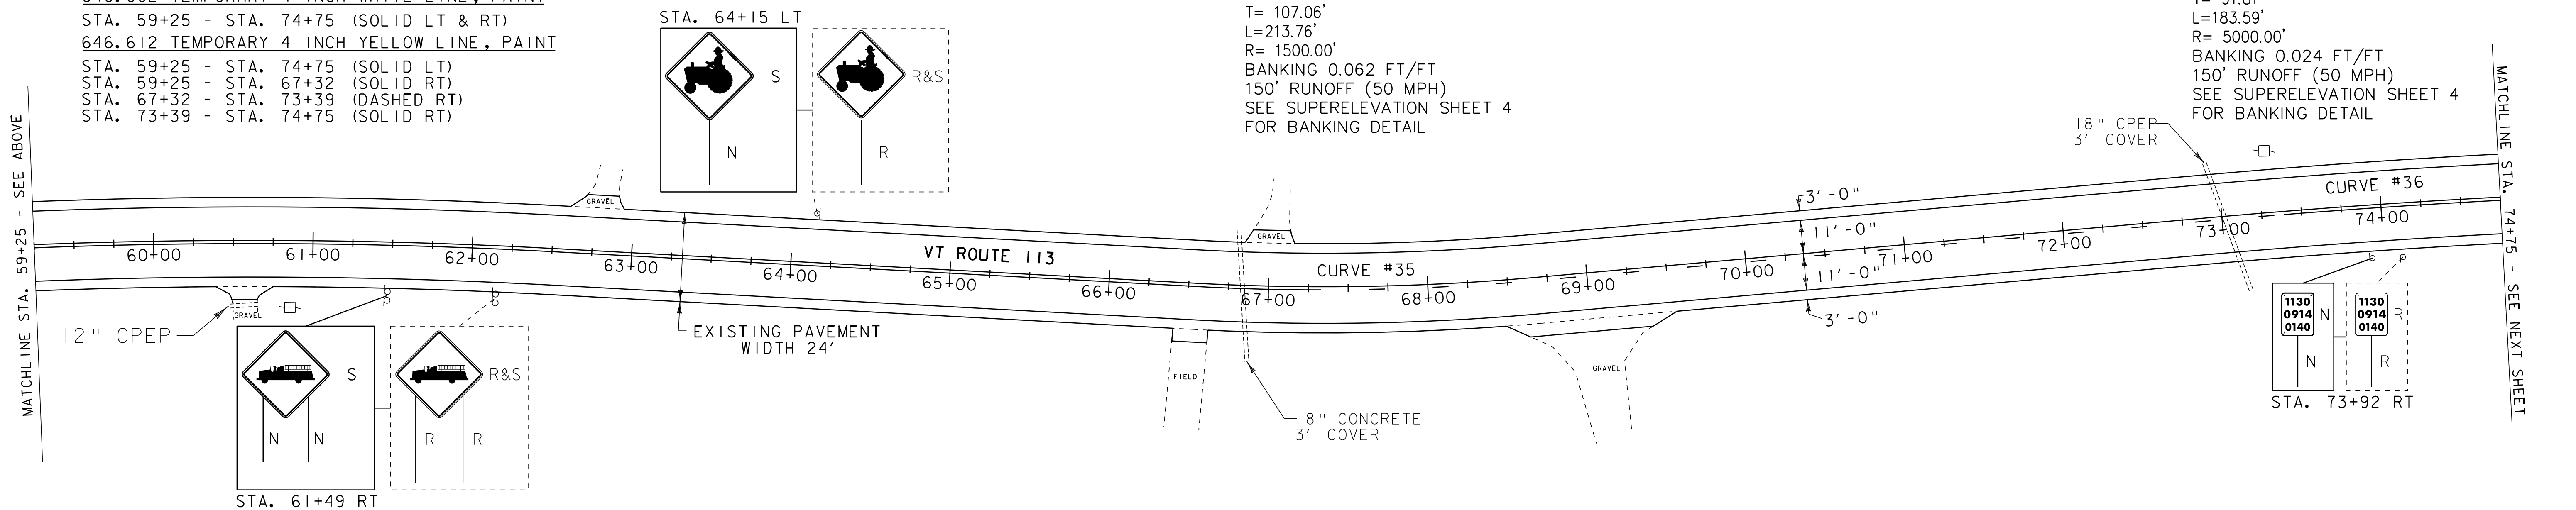

**SIGN LEGEND**  
 R = REMOVE  
 R&S = REMOVE AND SALVAGE  
 S = SALVAGE  
 RET = RETAIN  
 N = NEW  
 B-B = BACK TO BACK

**LEGEND**  
 □ = UTILITY POLE  
 ○ = HYDRANT  
 □ = CATCH BASIN / DROP INLET

NOT TO SCALE

<b>PROJECT LAYOUT SHEET 10</b>	PROJECT NAME: CHLSEA-VERSHIRE	PLOT DATE: 28-OCT-2011 13:36
	PROJECT NUMBER: STP 2331(1)S	DRAWN BY: BMB
	FILE NAME: 01c040.dgn	CHECKED BY: EPD
	PROJECT LEADER: CDL	SHEET 25 OF 55
DESIGNED BY: BMB		
PLOT FILE: 01c040_25.i		