

646.402 DURABLE 4 INCH WHITE LINE, THERMOPLASTIC
 STA. 138+75 - STA. 154+50 (SOLID LT & RT)
 (WITH EDGELINE BREAKS AT TOWN ROADS)


646.412 DURABLE 4 INCH YELLOW LINE, THERMOPLASTIC
 STA. 138+75 - STA. 154+50 (SOLID LT & RT)
 (WITH CENTERLINE BREAKS AT TOWN ROADS)

646.602 TEMPORARY 4 INCH WHITE LINE, PAINT
 STA. 138+75 - STA. 154+50 (SOLID LT & RT)
 (WITH EDGELINE BREAKS AT TOWN ROADS)

646.612 TEMPORARY 4 INCH YELLOW LINE, PAINT
 STA. 138+75 - STA. 154+50 (SOLID LT & RT)
 (WITH CENTERLINE BREAKS AT TOWN ROADS)

675.50 REMOVING SIGNS
 AS SHOWN - 9

675.60 ERECTING SALVAGED SIGNS
 AS SHOWN - 4

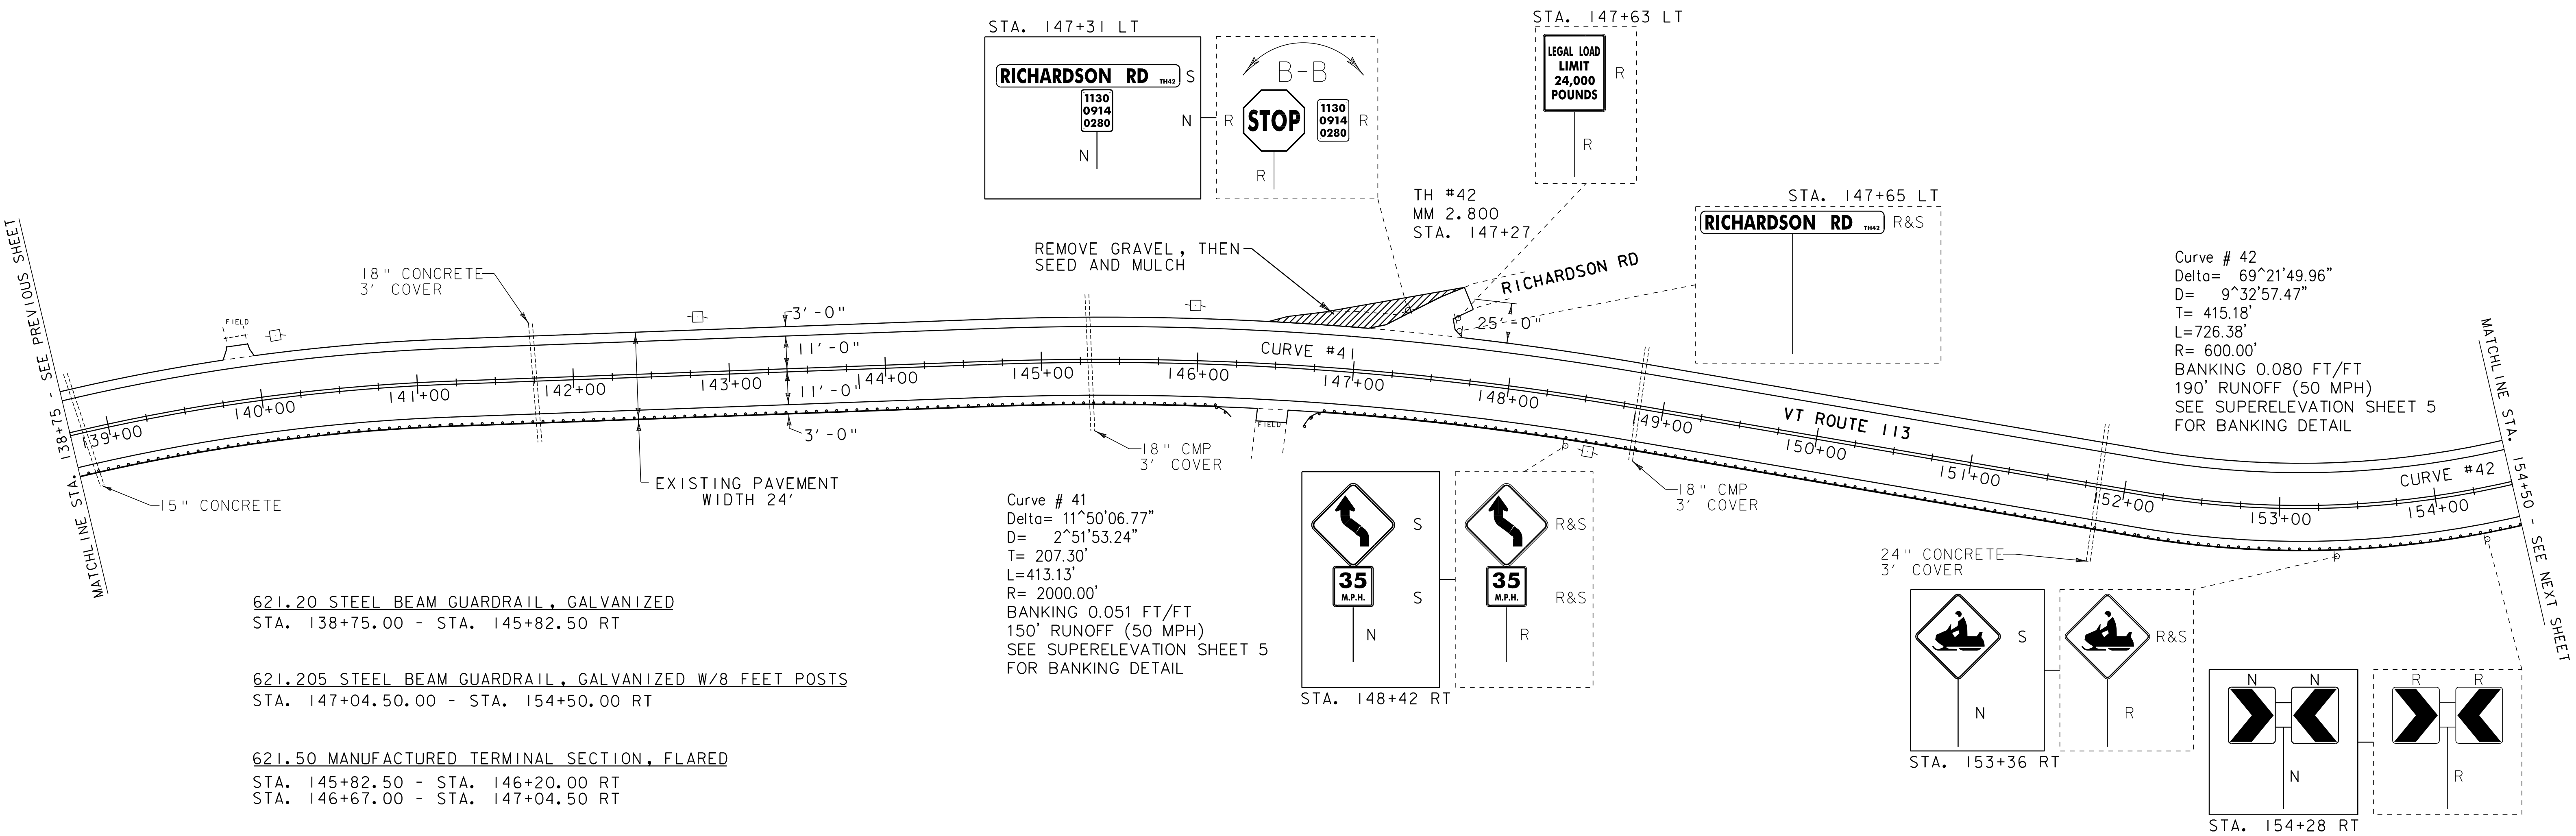

621.20 STEEL BEAM GUARDRAIL, GALVANIZED
 STA. 138+75.00 - STA. 145+82.50 RT

621.205 STEEL BEAM GUARDRAIL, GALVANIZED W/8 FEET POSTS
 STA. 147+04.50.00 - STA. 154+50.00 RT

621.50 MANUFACTURED TERMINAL SECTION, FLARED
 STA. 145+82.50 - STA. 146+20.00 RT
 STA. 146+67.00 - STA. 147+04.50 RT

621.80 REMOVAL AND DISPOSAL OF GUARDRAIL
 STA. 138+75.00 - STA. 146+20.00 RT
 STA. 146+67.00 - STA. 154+50.00 RT

676.10 DELINEATOR WITH STEEL POST
 STA. 146+20.00 RT
 STA. 146+67.00 RT

SIGN LEGEND
 R = REMOVE
 R&S = REMOVE AND SALVAGE
 S = SALVAGE
 RET = RETAIN
 N = NEW
 B-B = BACK TO BACK

LEGEND
 □ = UTILITY POLE
 ○ = HYDRANT
 □ = CATCH BASIN / DROP INLET

NOT TO SCALE

PROJECT LAYOUT SHEET 13

PROJECT NAME: CHELSEA-VERSHIRE
 PROJECT NUMBER: STP 2331(1)S
 FILE NAME: 01c040.dgn
 PROJECT LEADER: CDL
 DESIGNED BY: BMB
 PLOT FILE: 01c040_28.i
 PLOT DATE: 28-OCT-2011 13:36
 DRAWN BY: BMB
 CHECKED BY: EPD
 SHEET 28 OF 55