


646.406 DURABLE 4 INCH WHITE LINE, RECESSED POLYUREA
 (ALL LINES WILL INCLUDE EDGE LINE BREAKS AND
 RADIUS FOR TOWN HIGHWAYS)
 ARLINGTON:
 STA 54+50.00 - STA 68+00.00 LT & RT

646.602 TEMPORARY 4 INCH WHITE LINE, PAINT
 (ALL LINES WILL INCLUDE EDGE LINE BREAKS AND
 RADIUS FOR TOWN HIGHWAYS)
 ARLINGTON:
 STA 54+50.00 - STA 68+00.00 LT & RT

646.416 DURABLE 4 INCH YELLOW LINE, RECESSED POLYUREA
 (ALL LINES WILL INCLUDE C/L BREAKS FOR
 TOWN HIGHWAYS) S=SOLID, D=DASHED
 ARLINGTON:
 STA 54+50.00 - STA 68+00.00 LT C RT
 S - S

646.612 TEMPORARY 4 INCH YELLOW LINE, PAINT
 (ALL LINES WILL INCLUDE C/L BREAKS FOR
 TOWN HIGHWAYS) S=SOLID, D=DASHED
 ARLINGTON:
 STA 54+50.00 - STA 68+00.00 LT C RT
 S - S

675.50 REMOVING SIGNS
 AS SHOWN - 4
 3✓

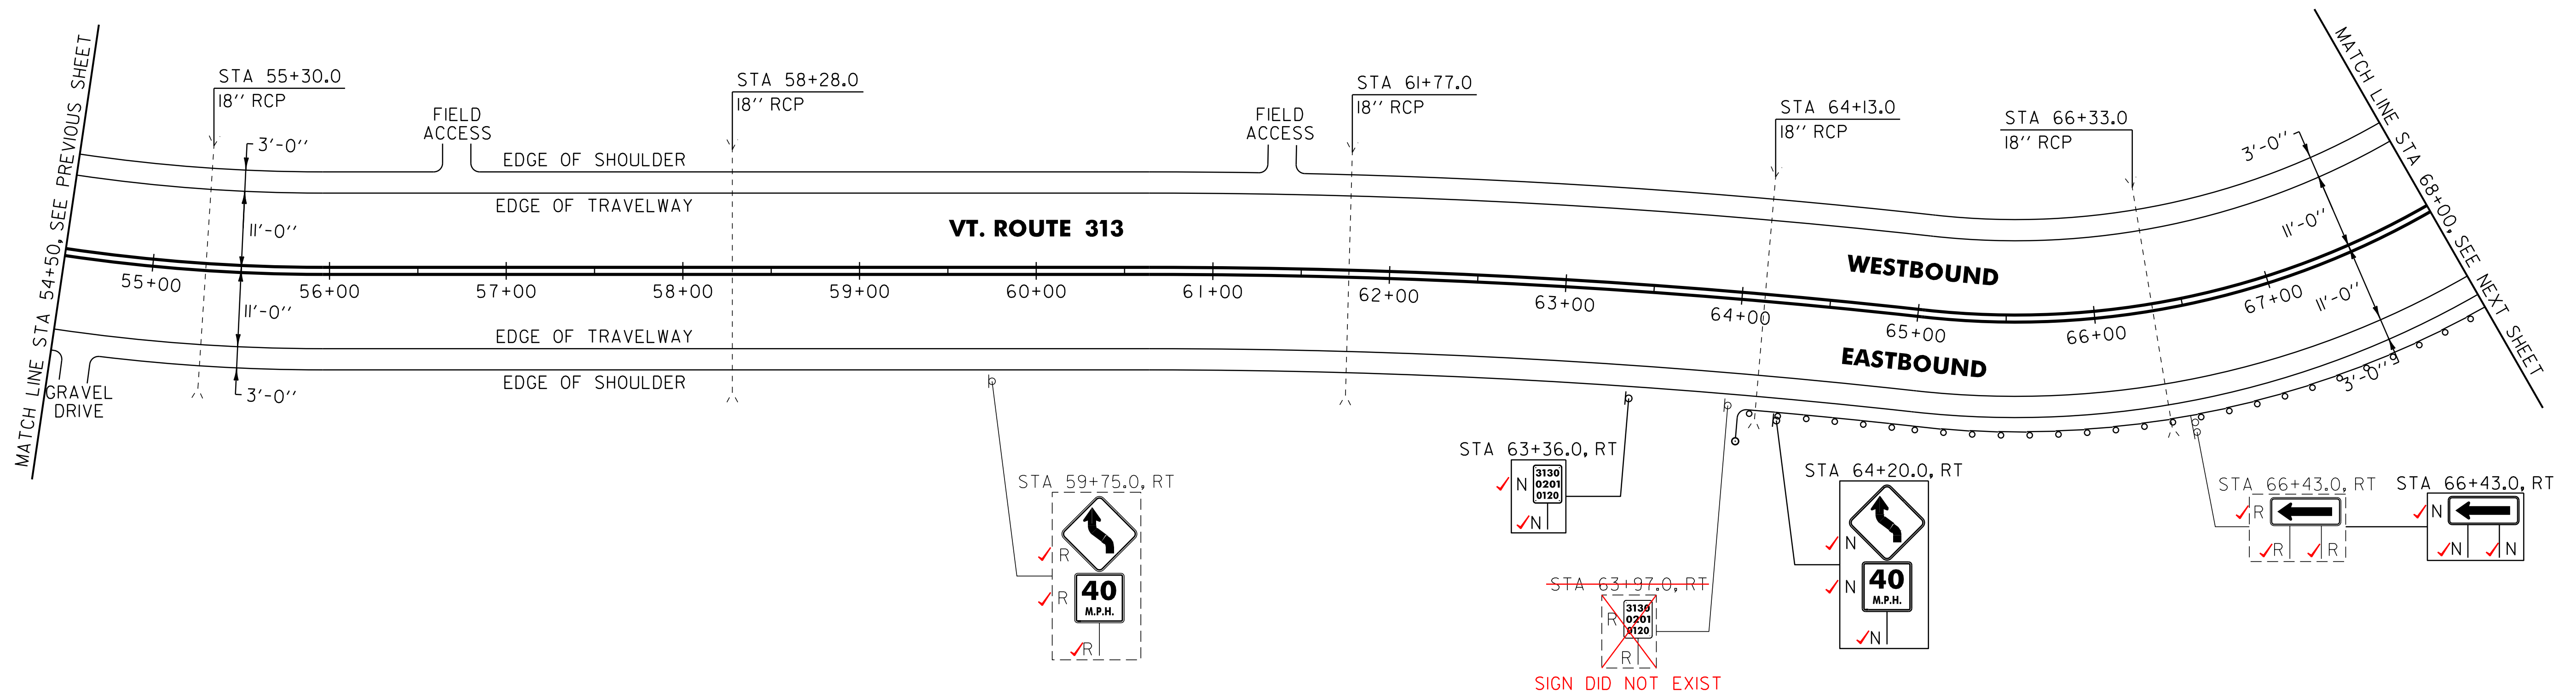

~~621.205 STEEL BEAM GUARDRAIL, GALVANIZED W/8 FEET POSTS~~
 ARLINGTON:
~~STA 64+40.5 - STA 68+00.0 RT (359.5 LF)~~

621.20 STEEL BEAM GUARDRAIL, GALVANIZED
 ARLINGTON:
 STA 64+40.5 - STA 68+00.0 RT (359.5 LF)

621.50 MANUFACTURED TERMINAL SECTION, FLARED
 ARLINGTON:
 STA 64+03.0 ✓ - STA 64+40.5 RT ✓

621.80 REMOVAL AND DISPOSAL OF GUARDRAIL
 ARLINGTON:
 STA 64+03.0 - STA 68+00.0 RT (397.0 LF) ✓

676.10 DELINEATOR WITH STEEL POST
 ARLINGTON:
 STA 64+03.0 RT

SIGN LEGEND
 R = REMOVE
 S = SALVAGE
 N = NEW
 RET = RETAIN
 B-B = BACK TO BACK
 EXISTING = - - - - -
 NEW = _____

PROJECT LAYOUT SHEET #3	NOT TO SCALE	
	PROJECT NAME: ARLINGTON	PROJECT NUMBER: STP 2334(II)
	FILE NAME: OIC042.dgn	PLOT DATE: 20-FEB-2013 16:40
	PROJECT LEADER: D.E.G. DESIGNED BY: M.J.M. IPARM FILE: p0lc042i03.i	DRAWN BY: C.A.K. CHECKED BY: D.W.E. SHEET 19 OF 143